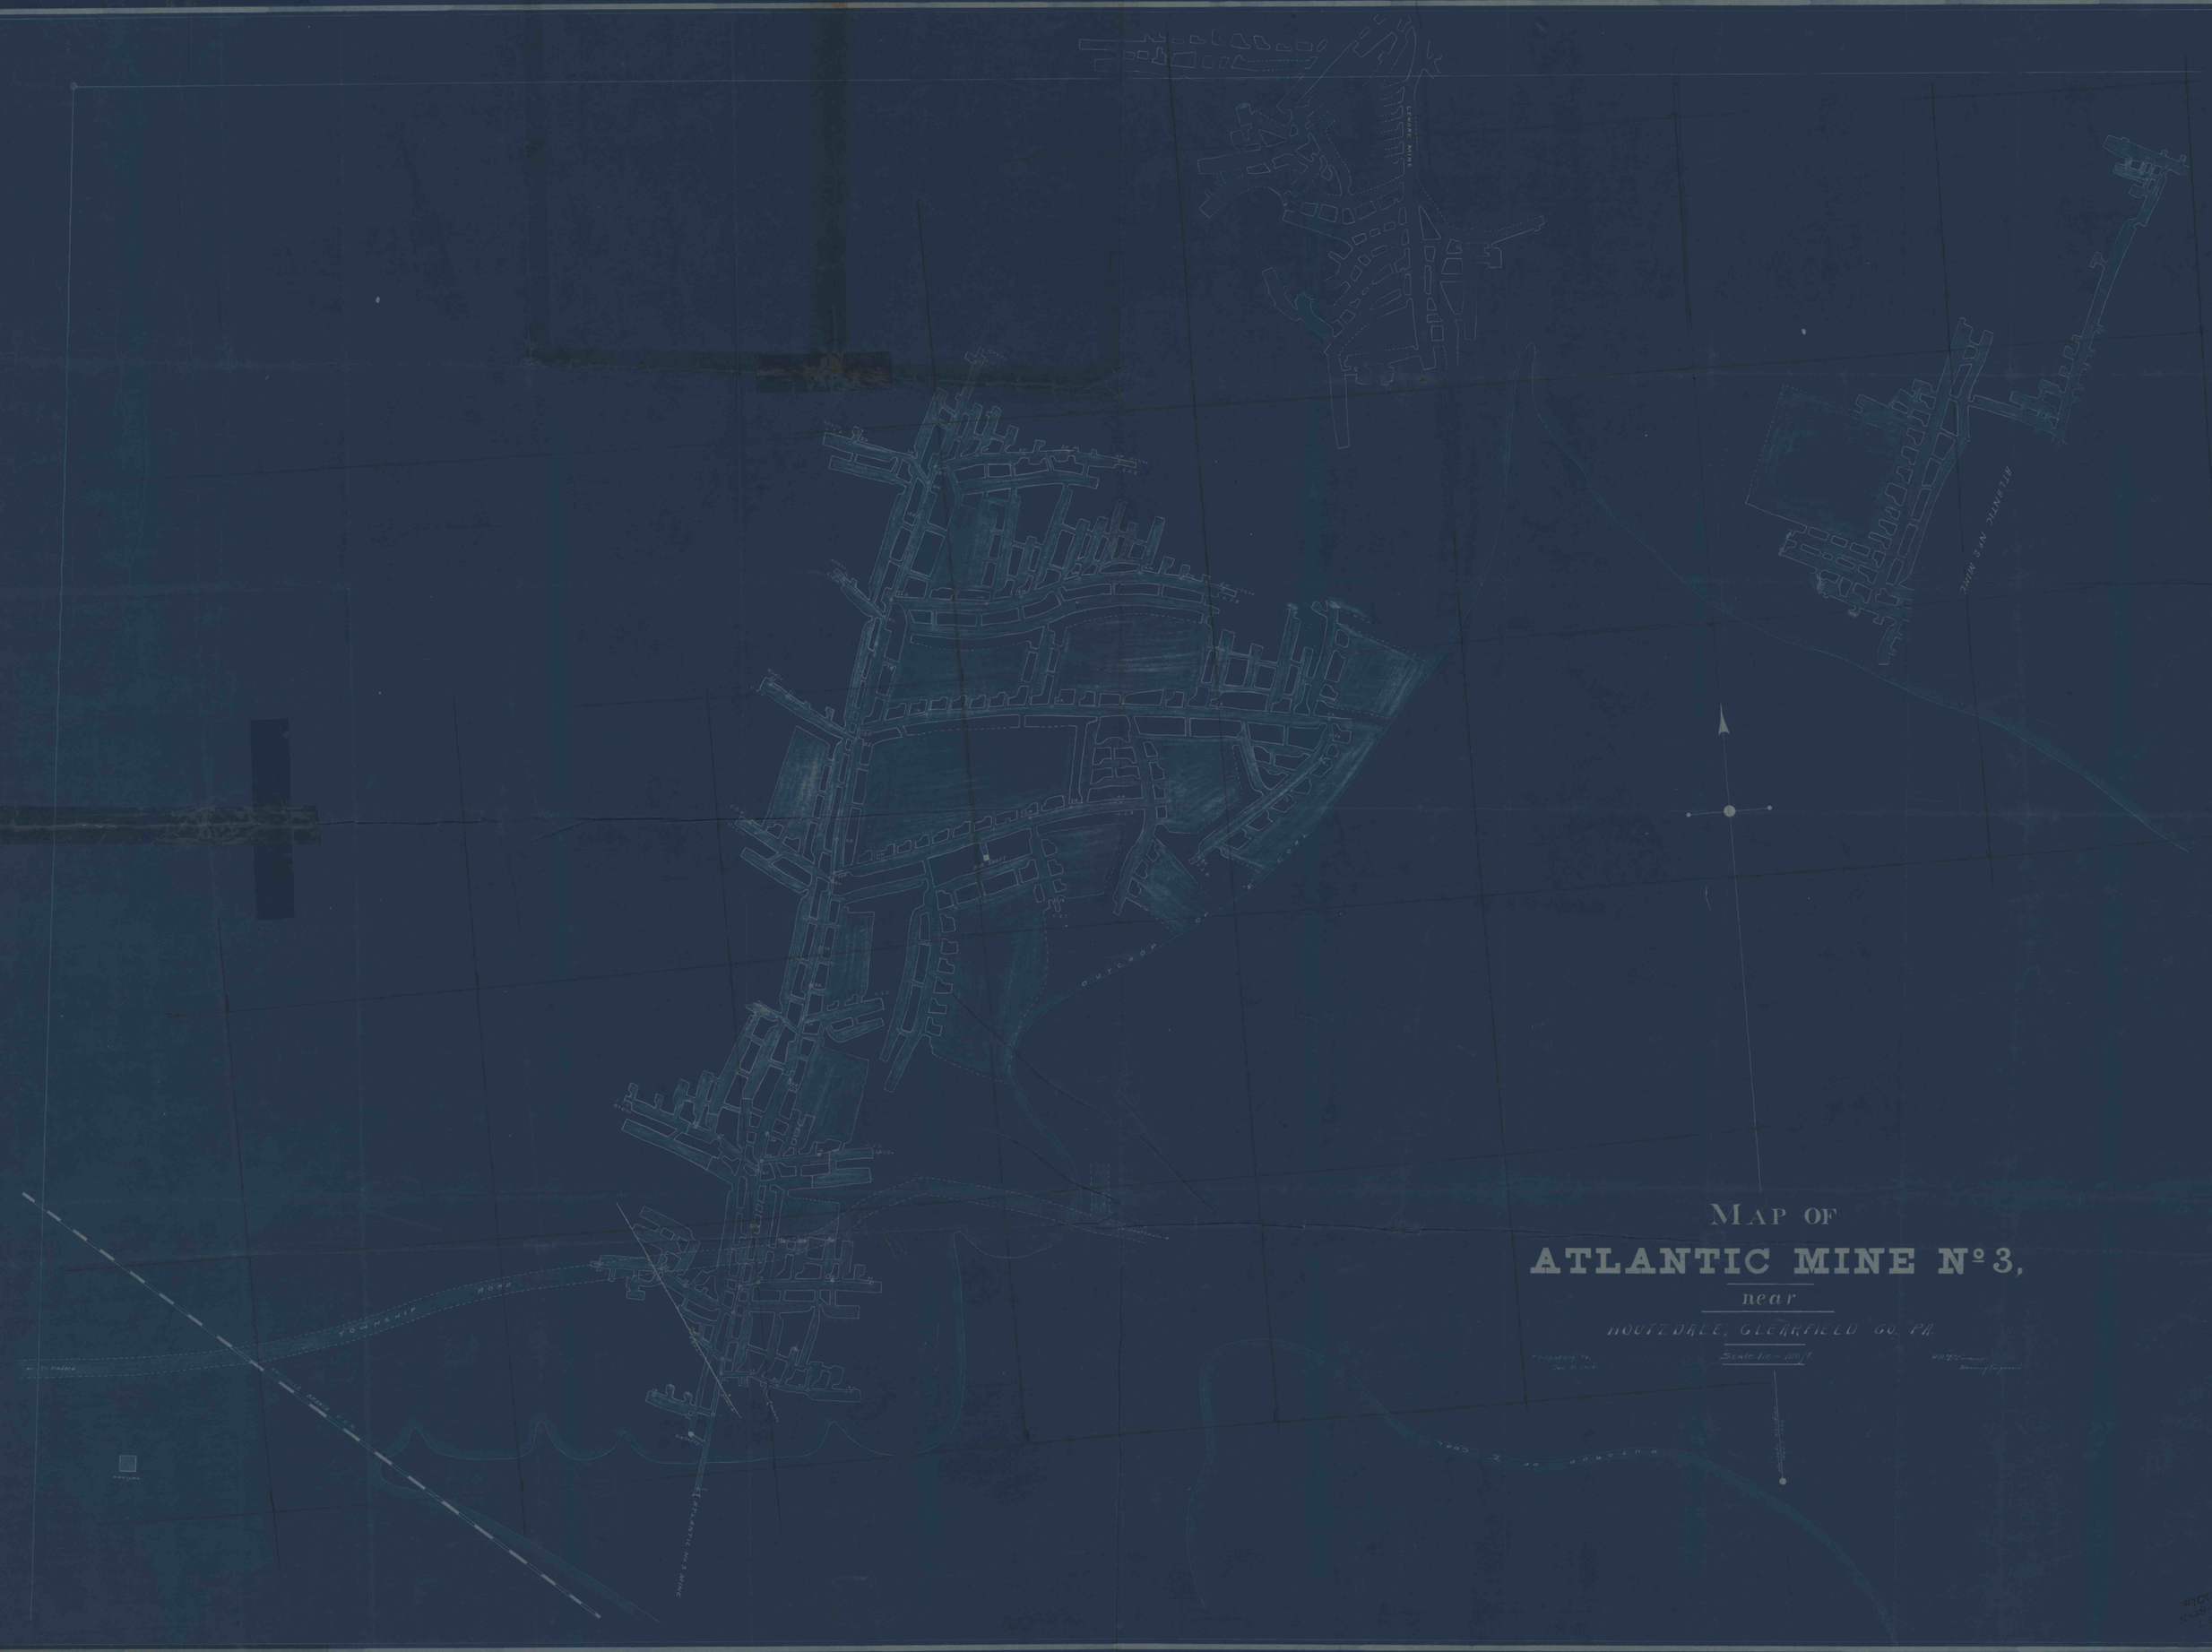

MAP OF
ATLANTIC MINE Nº 3,
near
HOUTZDALE, CLEARFIELD CO. PA.

Scale 1in = 100ft