


AMERICAN AIR SURVEYS, INC.  
PITTSBURGH, PA.

WORKING DRAWING  
SHOWING THE LOCATION OF  
THE AILDS RUN MINE

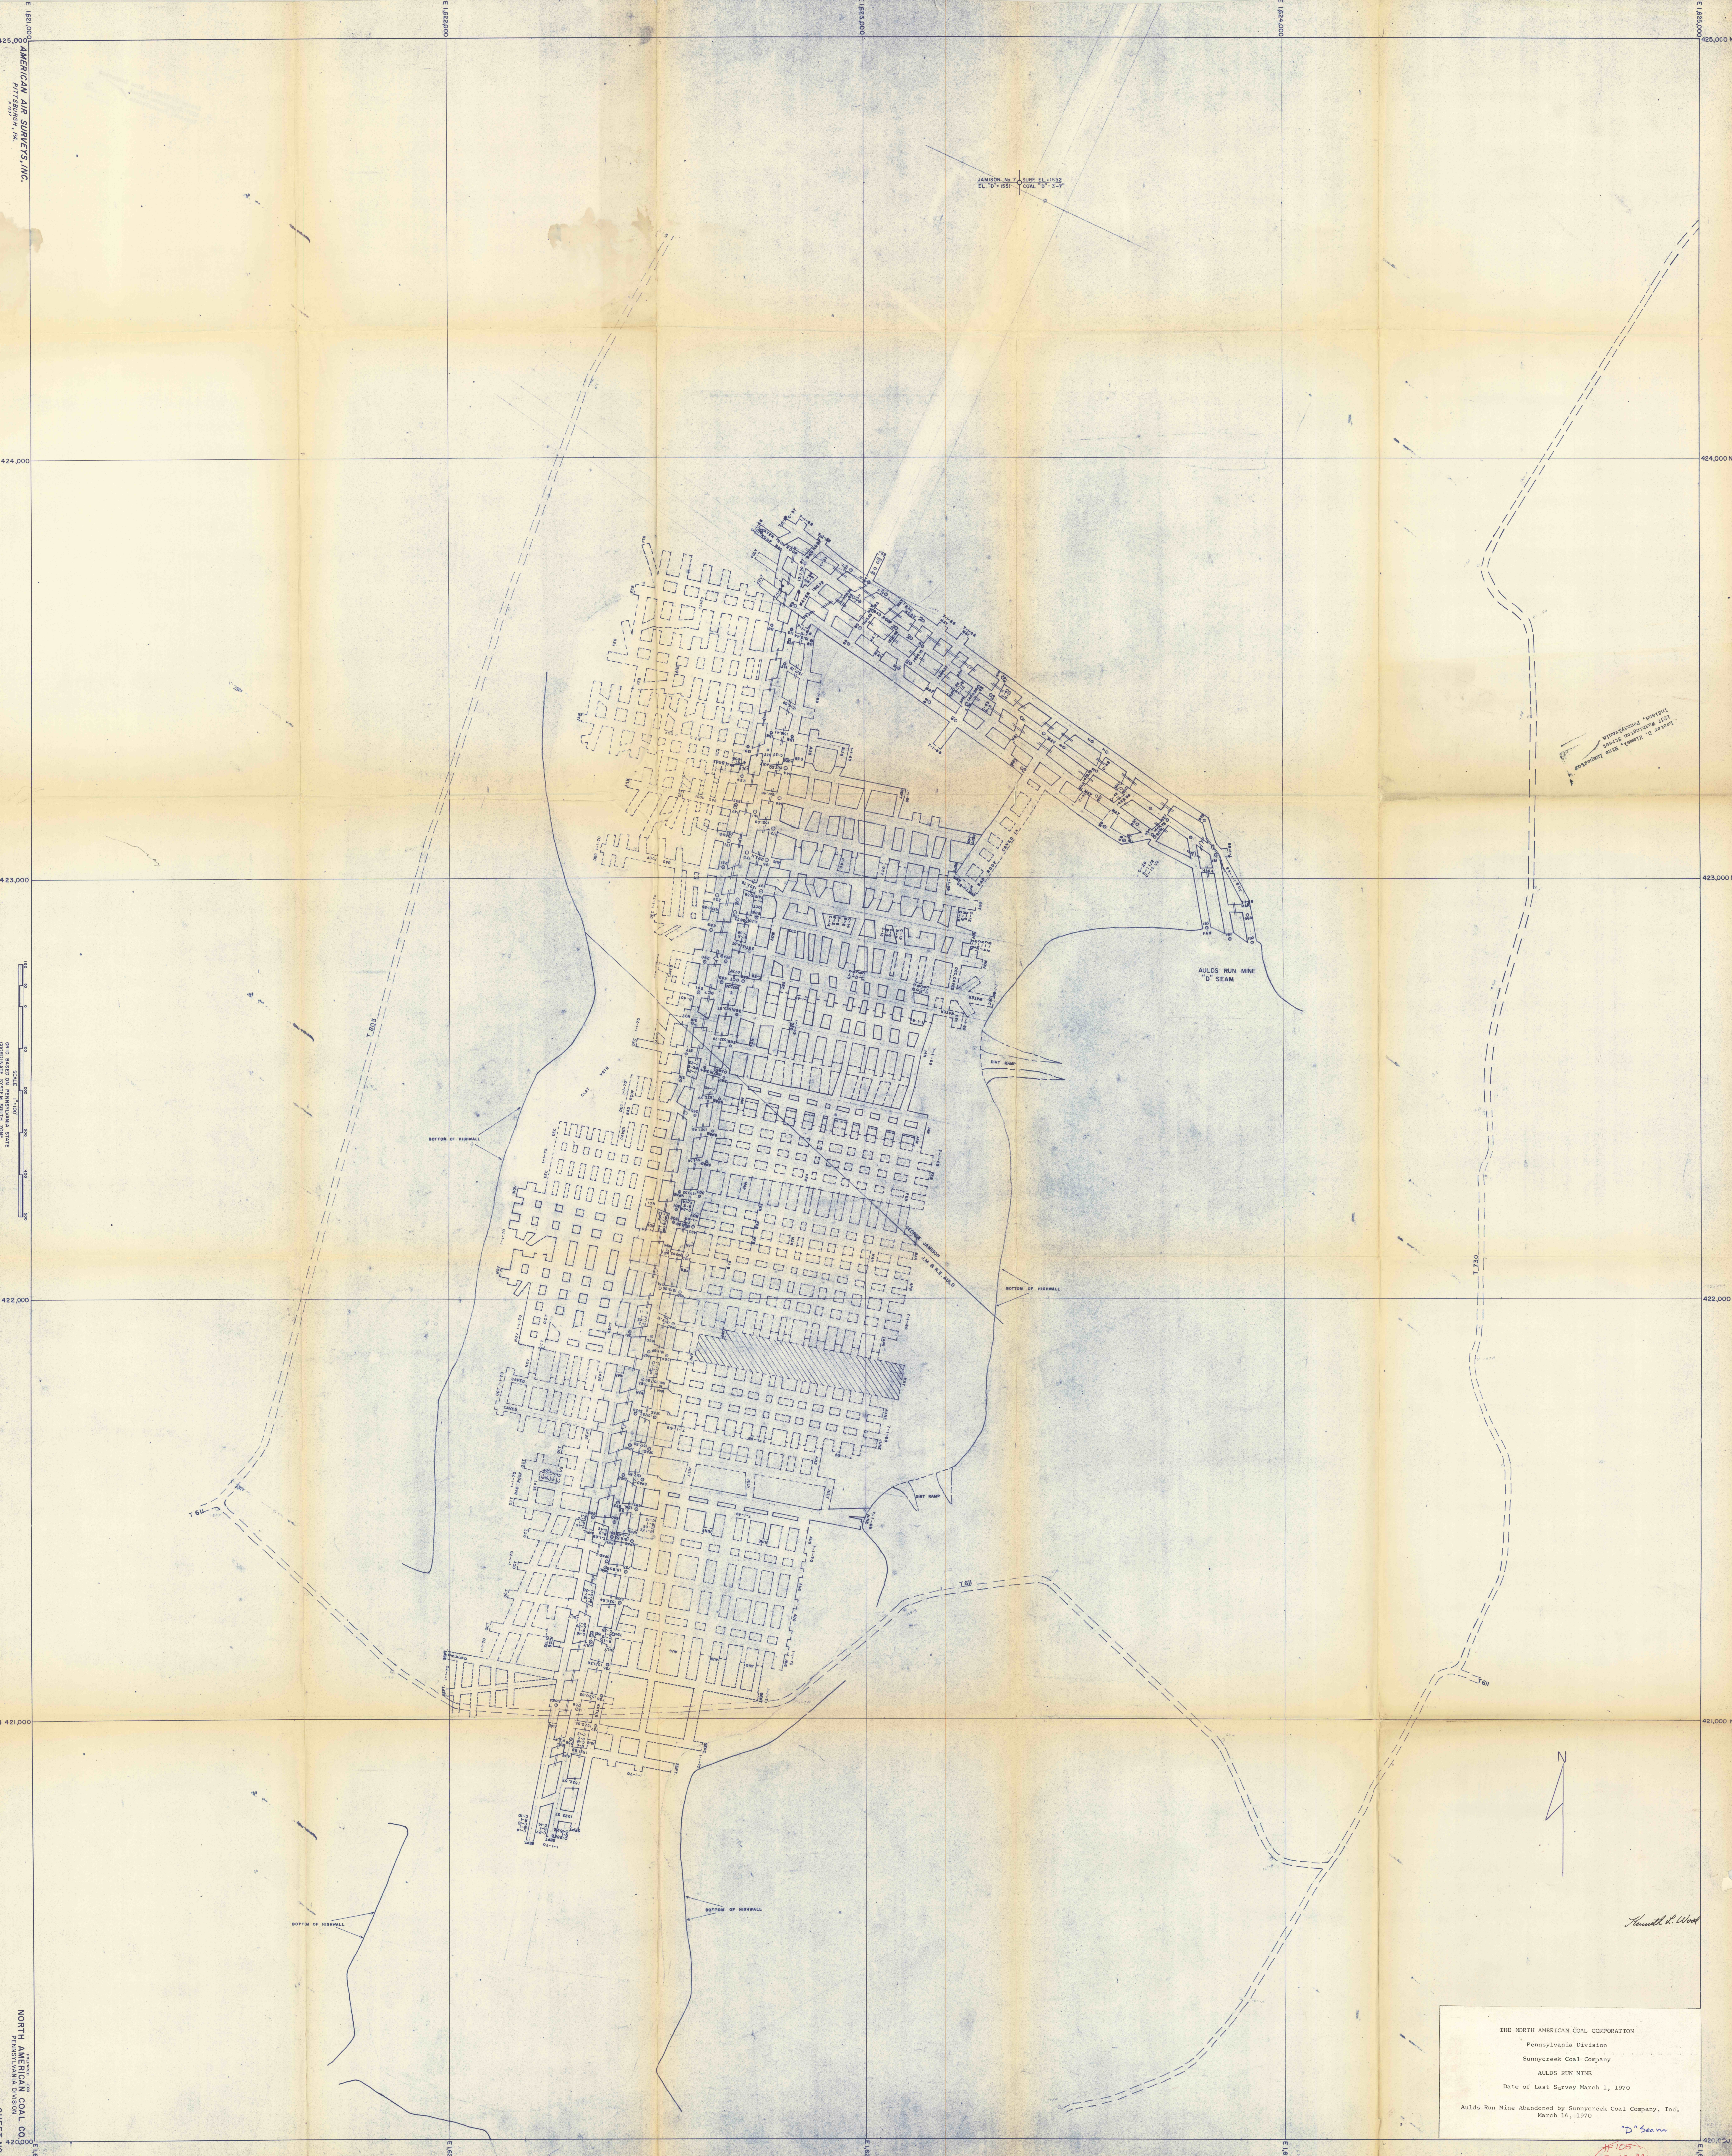

THE NORTH AMERICAN COAL CORPORATION  
Pennsylvania Division  
Summycoek Coal Company  
AILDS RUN MINE  
Date of Last Survey March 1, 1970  
Alds Run Mine Abandoned by Summycoek Coal Company, Inc.  
March 16, 1970  
"D" Seam

#105  
5-21-77  
C.C.