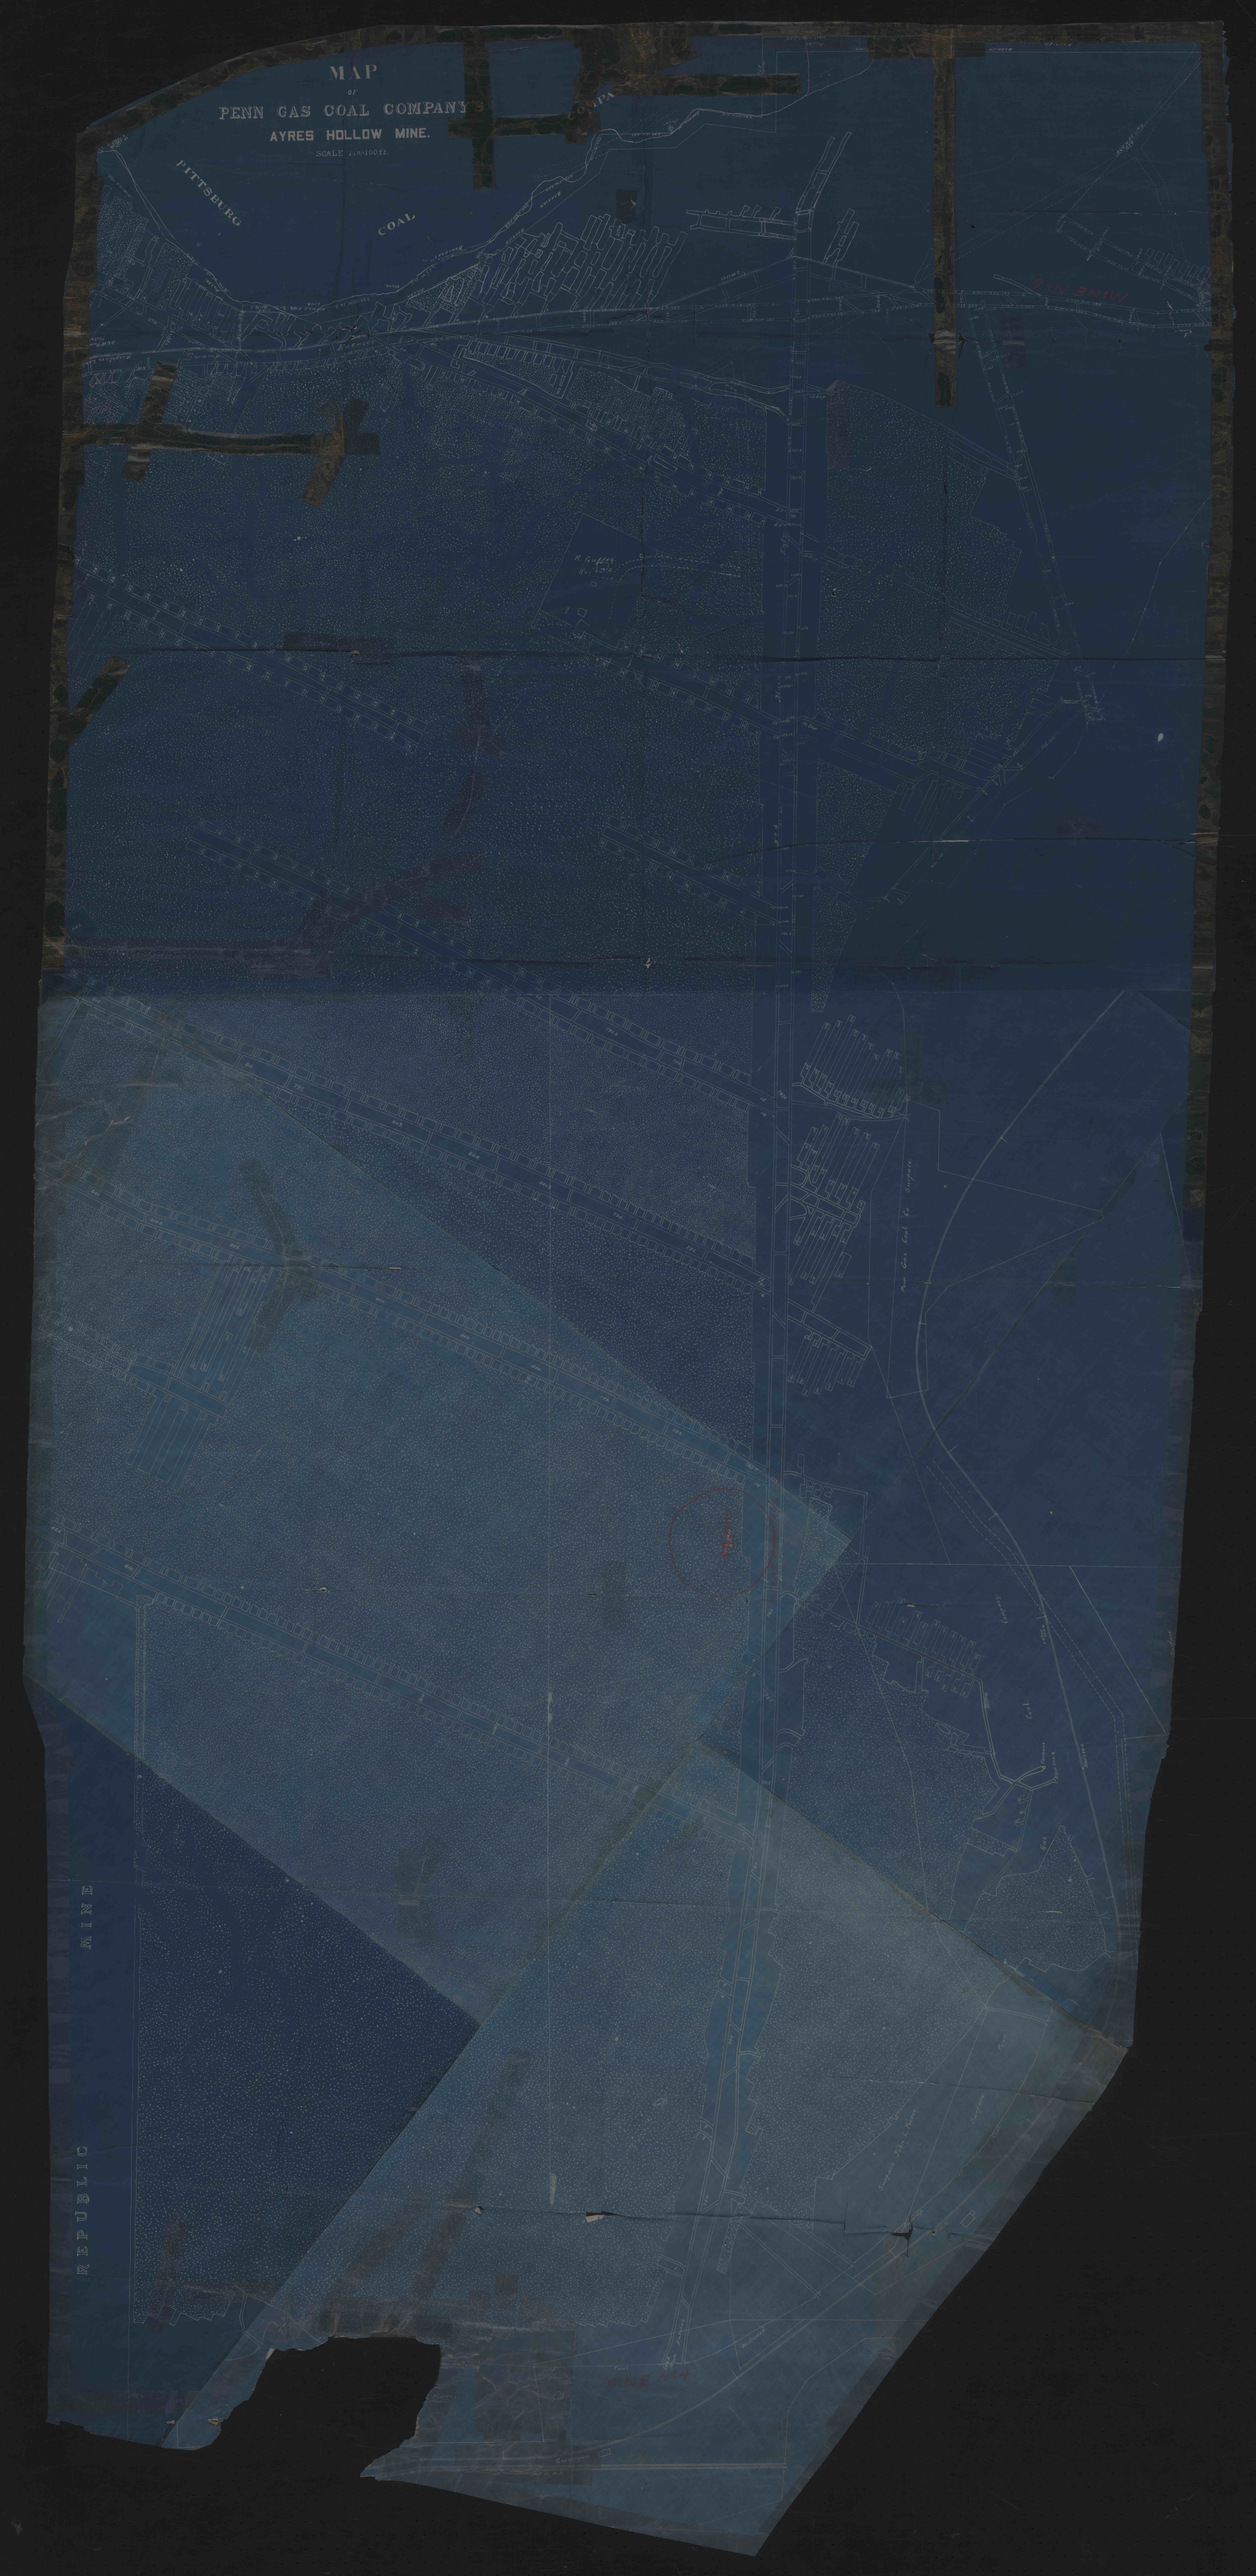
MAP
OF
PENN GAS COAL COMPANY'S
AYRES HOLLOW MINE.
SCALE 1 IN = 100 FT.
PITTSBURG
COAL
REPUBLIC MINE