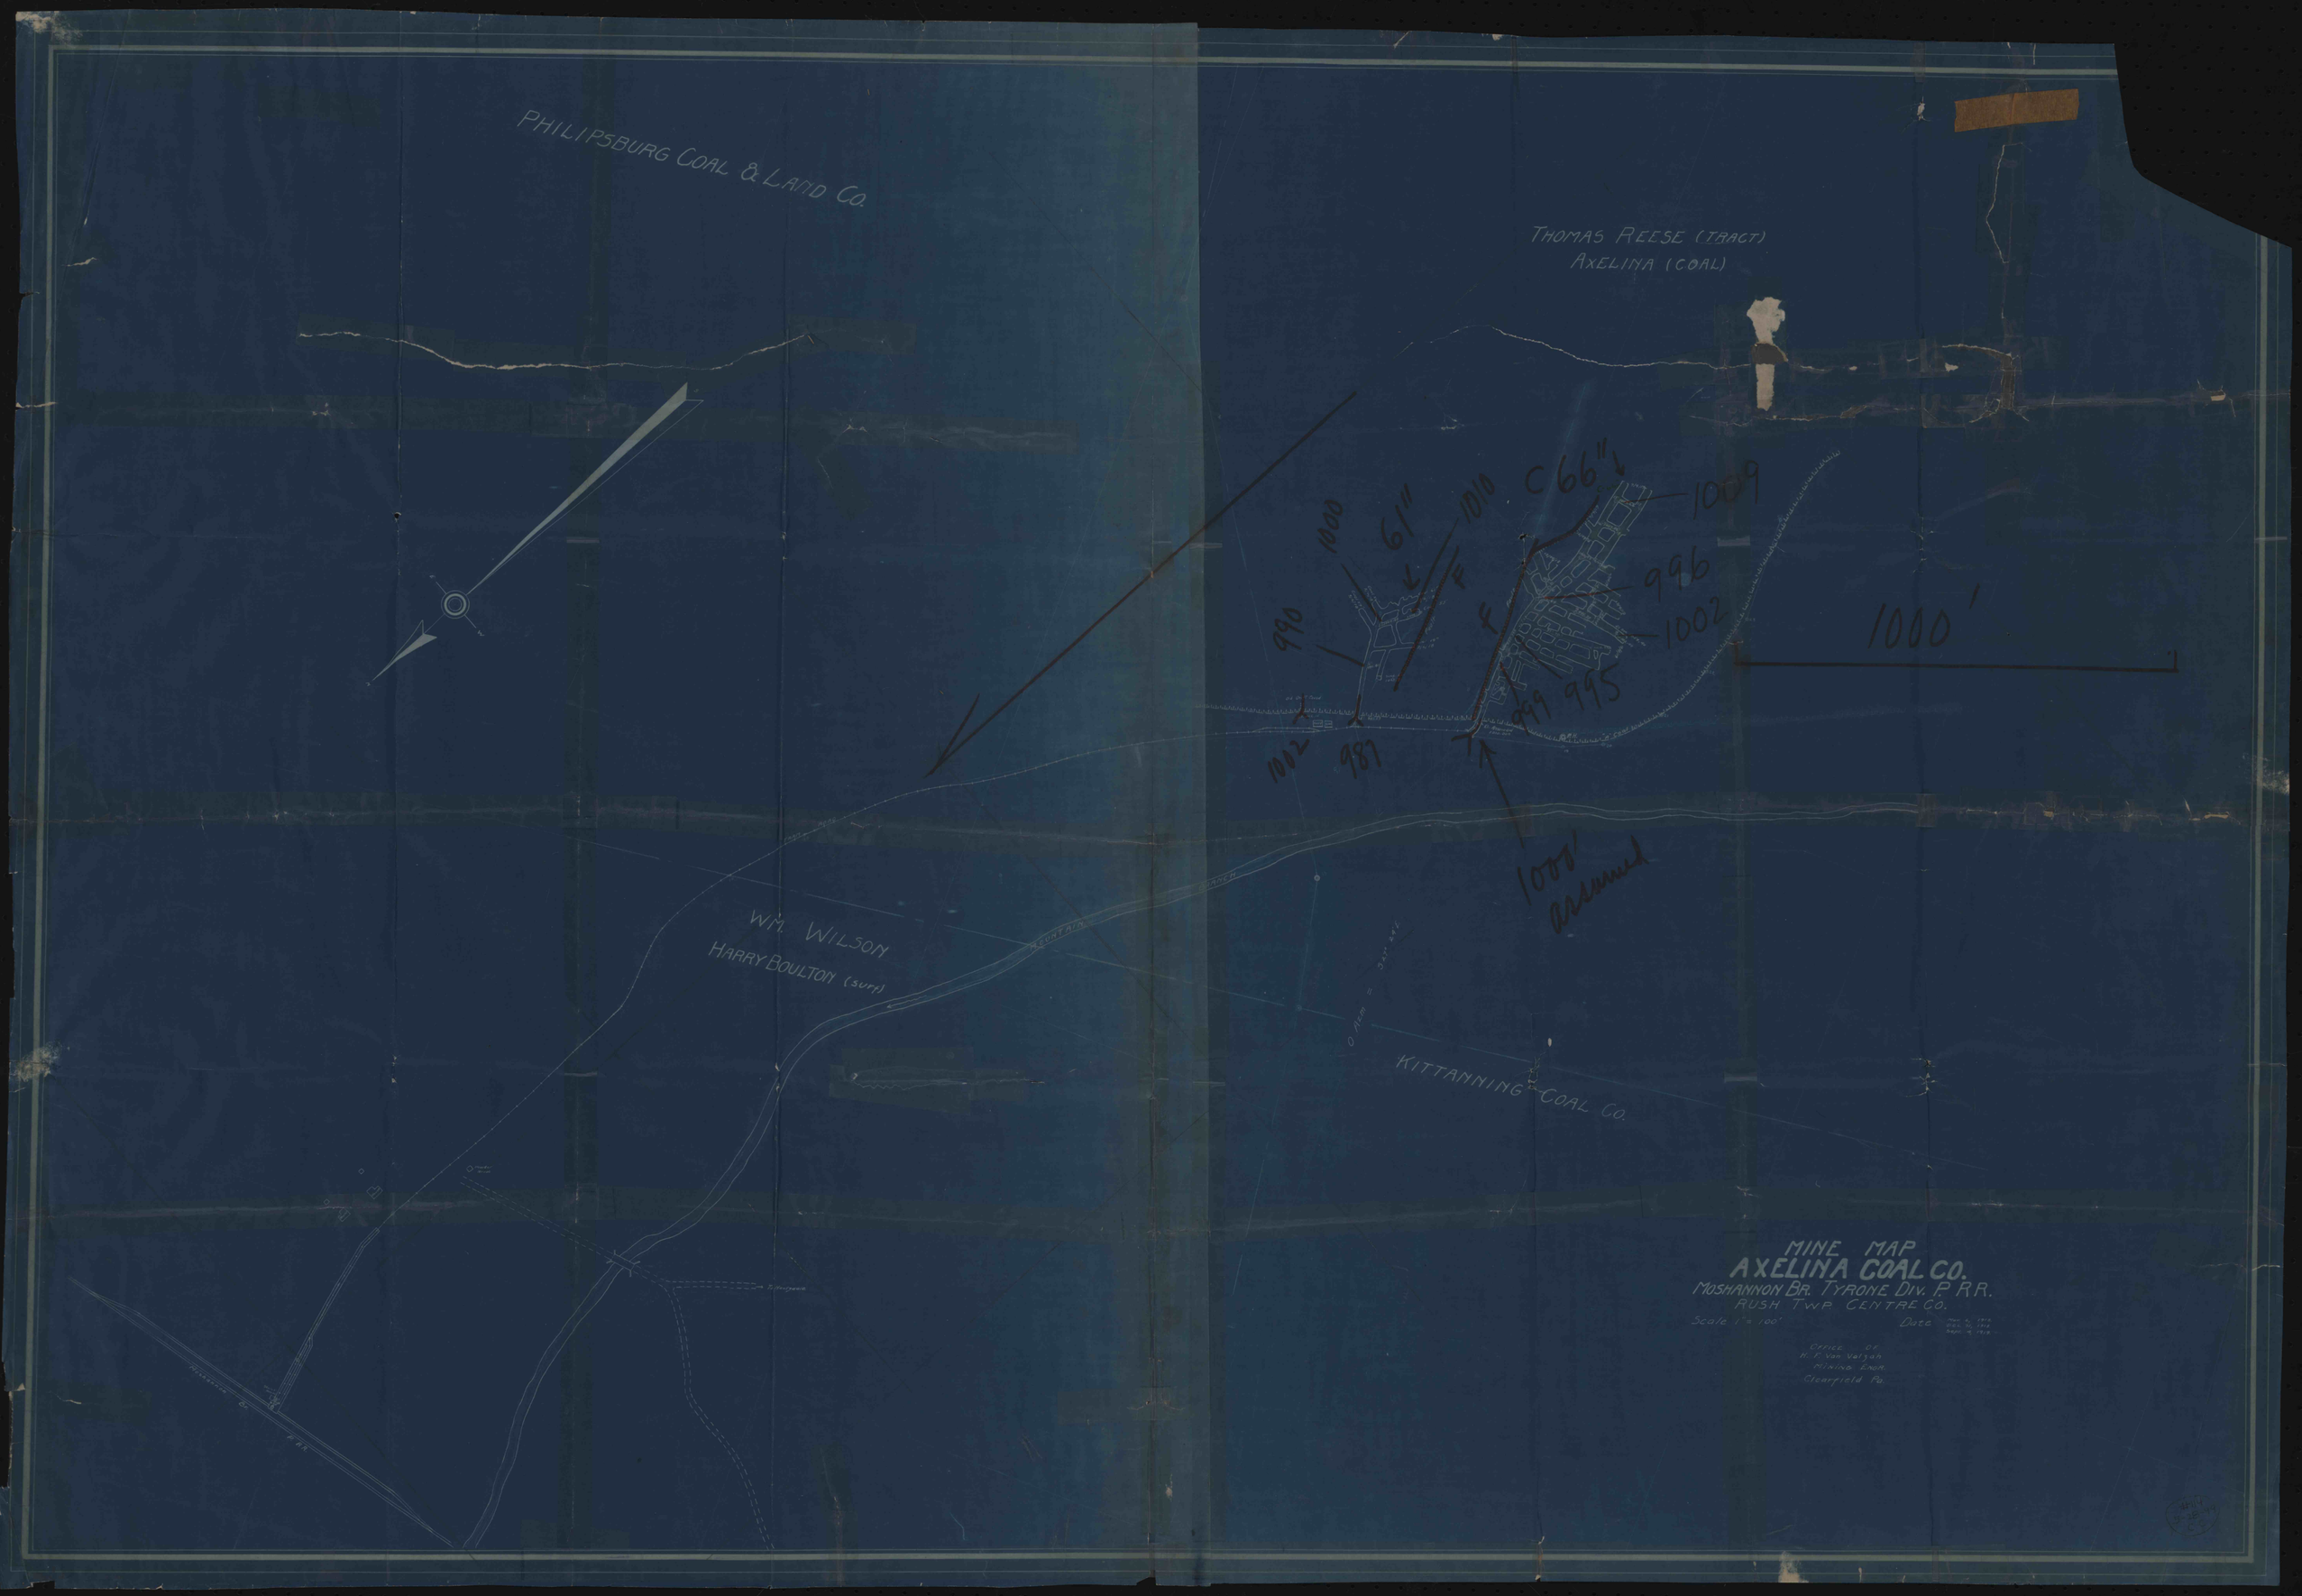
PHILIPSBURG COAL & LAND CO.
THOMAS REESE (TRACT)
AXELINA (COAL)
1000
61"
1010
C66"
1009
996
1002
990
995
999
1000'
1002
987
1000' assumed
WM. WILSON
HARRY BOULTON (surf)
KITTANNING COAL CO.
MINE MAP
AXELINA COAL CO.
MOSHANNON BR. TYRONE DIV. P. R.R.
RUSH TWP. CENTRE CO.
Scale 1" = 100'
Date
Office of
H. F. Van Valzah
Mining Engr.
Clearfield Pa.