


SURVEY LEGEND

- 'A' APRIL 28, 1964
- 'B' OCT 22, 1964

NOTE:
TOTAL AREA 55.82 ACRES

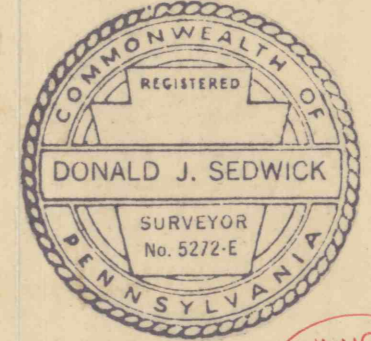

B. & B. # 3 MINE

COAL MINE MAP
GLENN WILLIAMS TRACT FOR
BERTETTO BROTHERS COAL CO.
MANOR TOWNSHIP, ARMSTRONG CO., PA.

R. B. SHANNON & ASSOCIATES, KITTANNING, PA.
DRAWN BY ELS-WES DATE FEB. 1964
SCALE 1/4" = 100 FEET DRAWING NO. C 466

#119
5-28-64
C.C.