

#127
C.C.
6-1-94


ROUTE 253

NORTH LINE

- PROJECTED MINING
- WORKED OUT AREAS
- PROPERTY LINE

NOW
BERZONSKI & SAUPP COAL CO.
SMITHMILL, PENN.

MAP
SHOWING
D. SEAM WORKINGS
OF
CHILCOTE COAL CO. MINE #1
READE TWP., CAMBRIA CO., PA.
SCALE 1"=100'
8-11-56
J.L. BANFIELD REG. ENG.

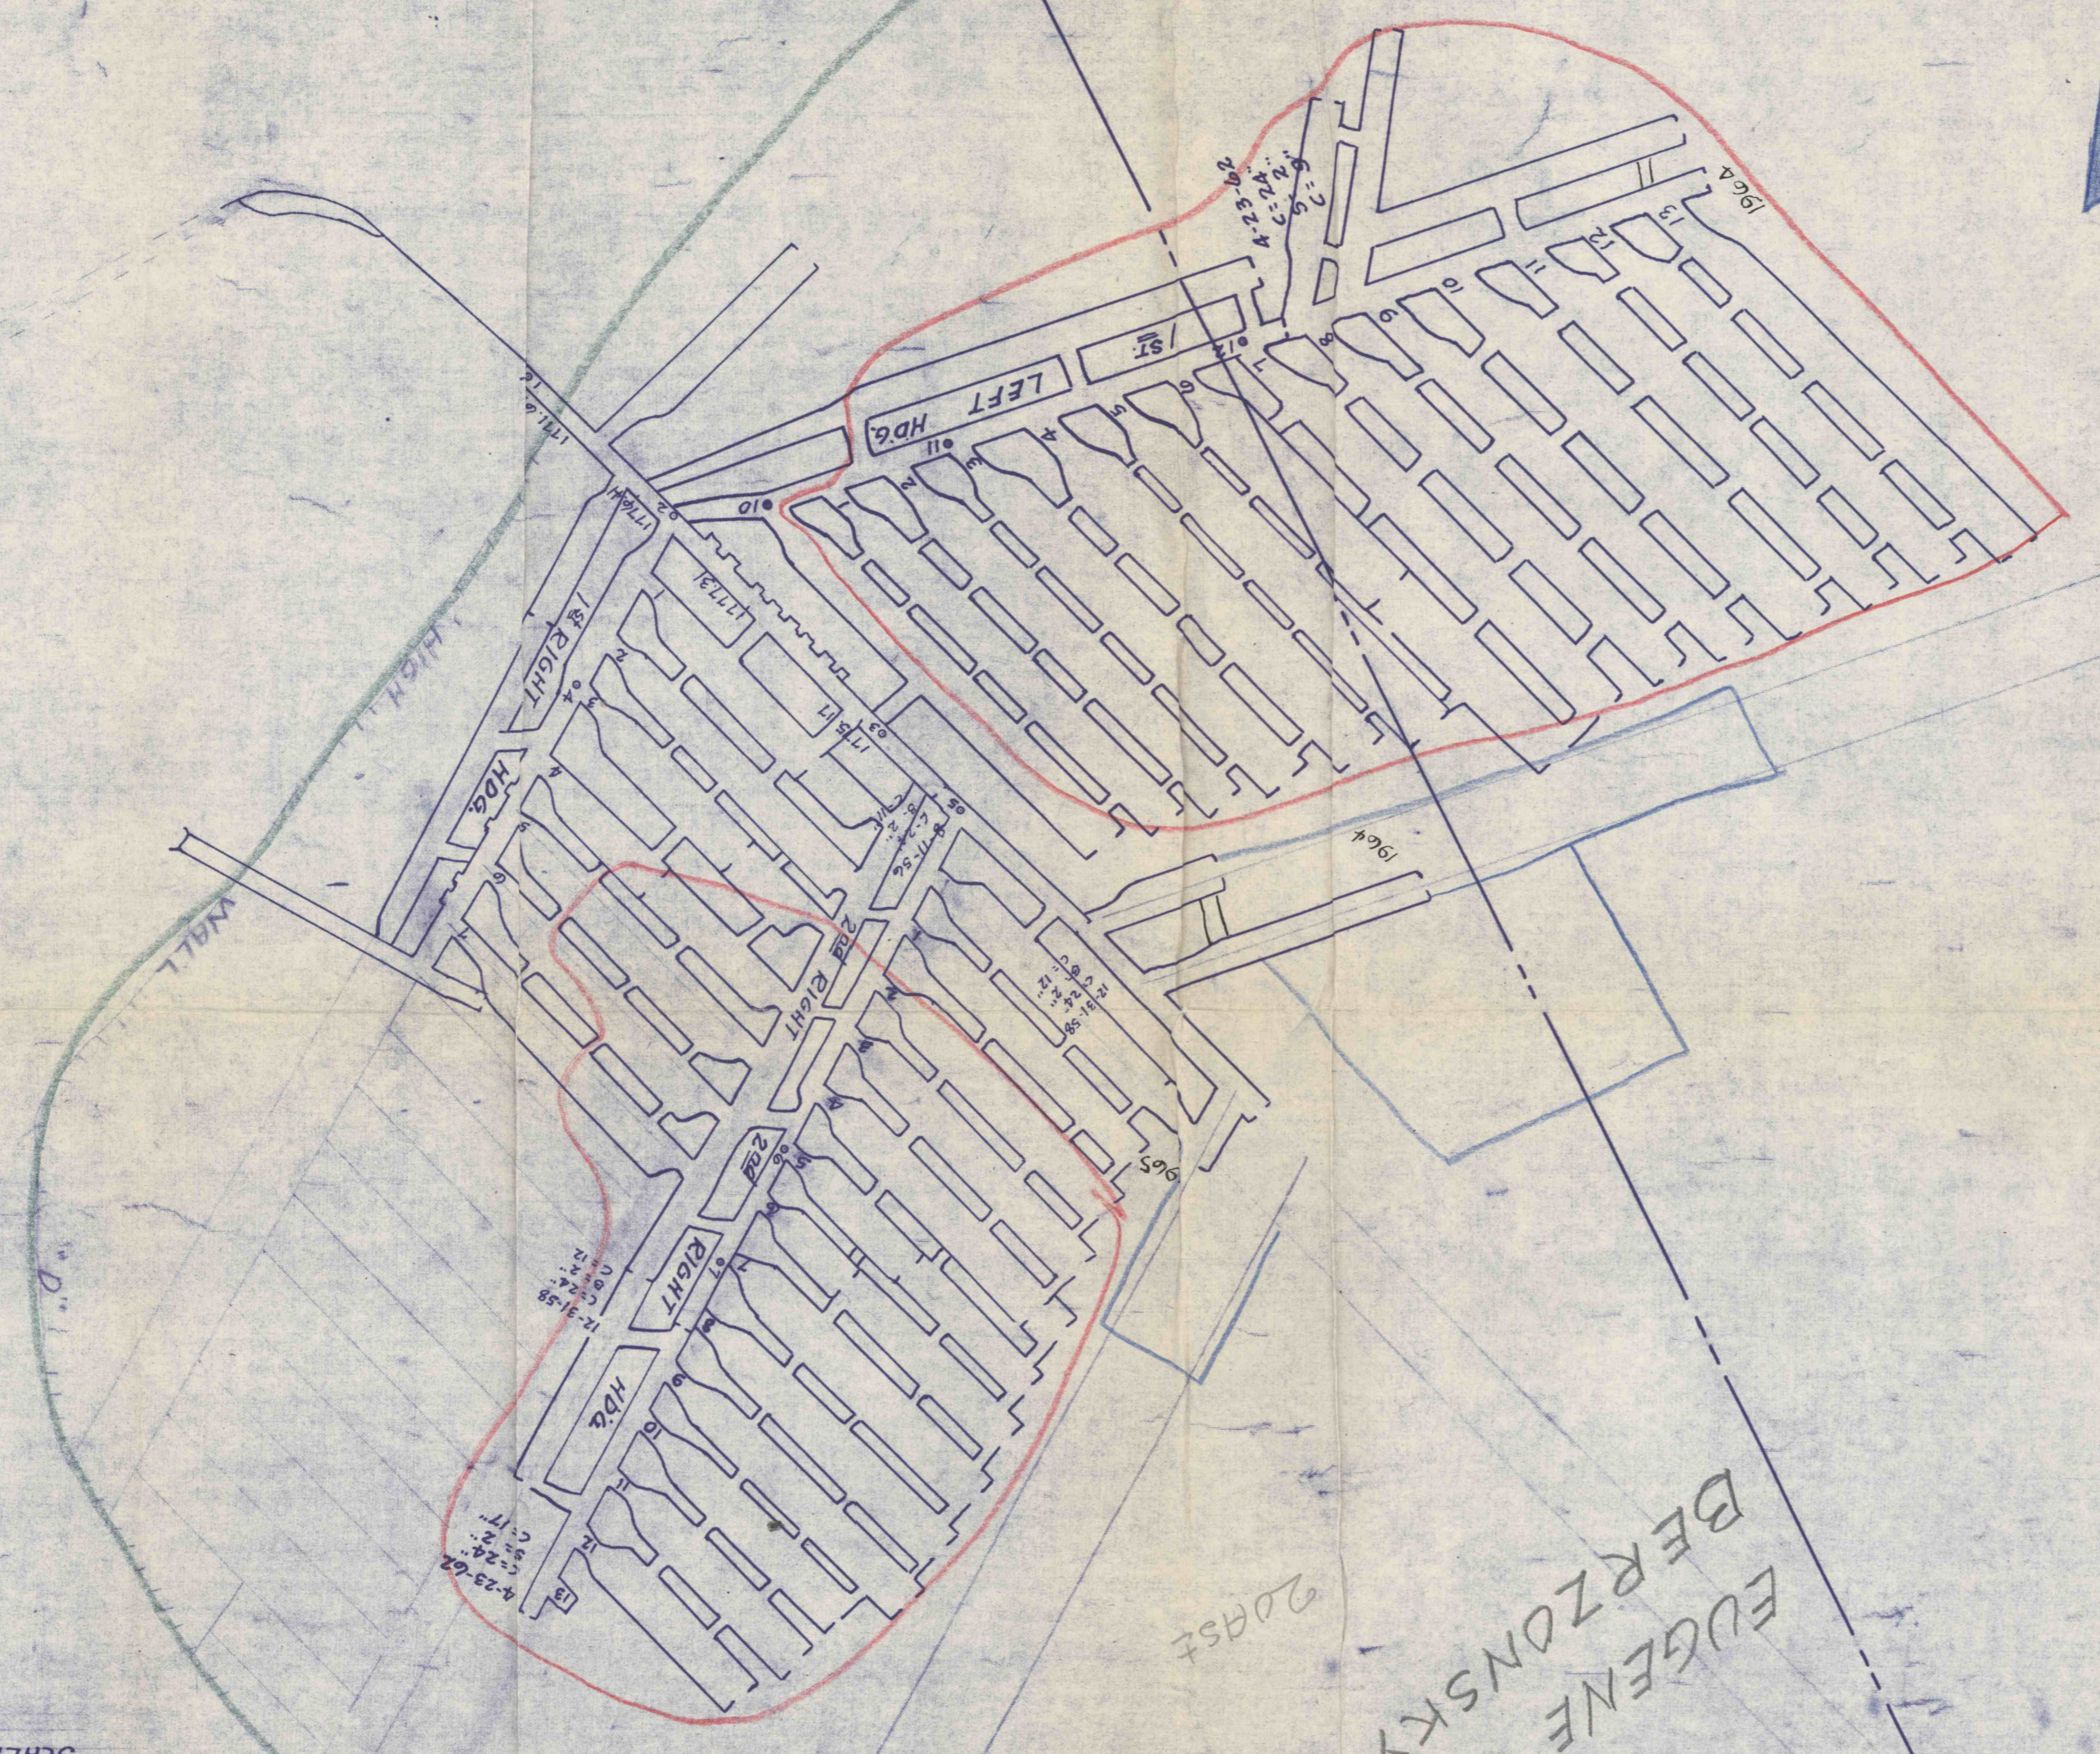

BERZONSKI & SAUPP (COAL)
REYNOLDS & SAUPP (SURF)
EUGENE BERZONSKI & SAUPP (COAL)
REYNOLDS & SAUPP (SURF)
EUGENE BERZONSKI & SAUPP (COAL)
REYNOLDS & SAUPP (SURF)

(SURF)
(COAL)

REYNOLDS & SAUPP
EUGENE BERZONSKI & SAUPP