


#125
6-1-99
C.C.

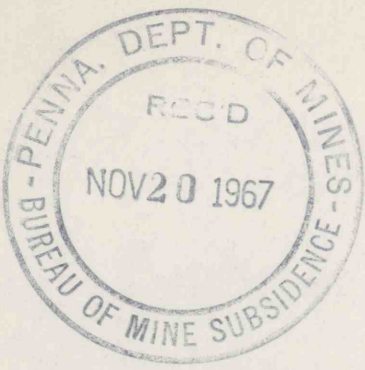

FIELD COPY

RAYMOND BACHELIER

GRAMPIAN, PA.R.D.

MAP OF MINE

FERGUSON TWP., CLFD. CO, PA.



SCALE 1"=100'

CLEARFIELD, PA. OCT 7 1966


ROY C.KINDIG
REG. ENGR.

Revised
Nov. 17, 1967

Lex W. Curry
Reg Surveyor

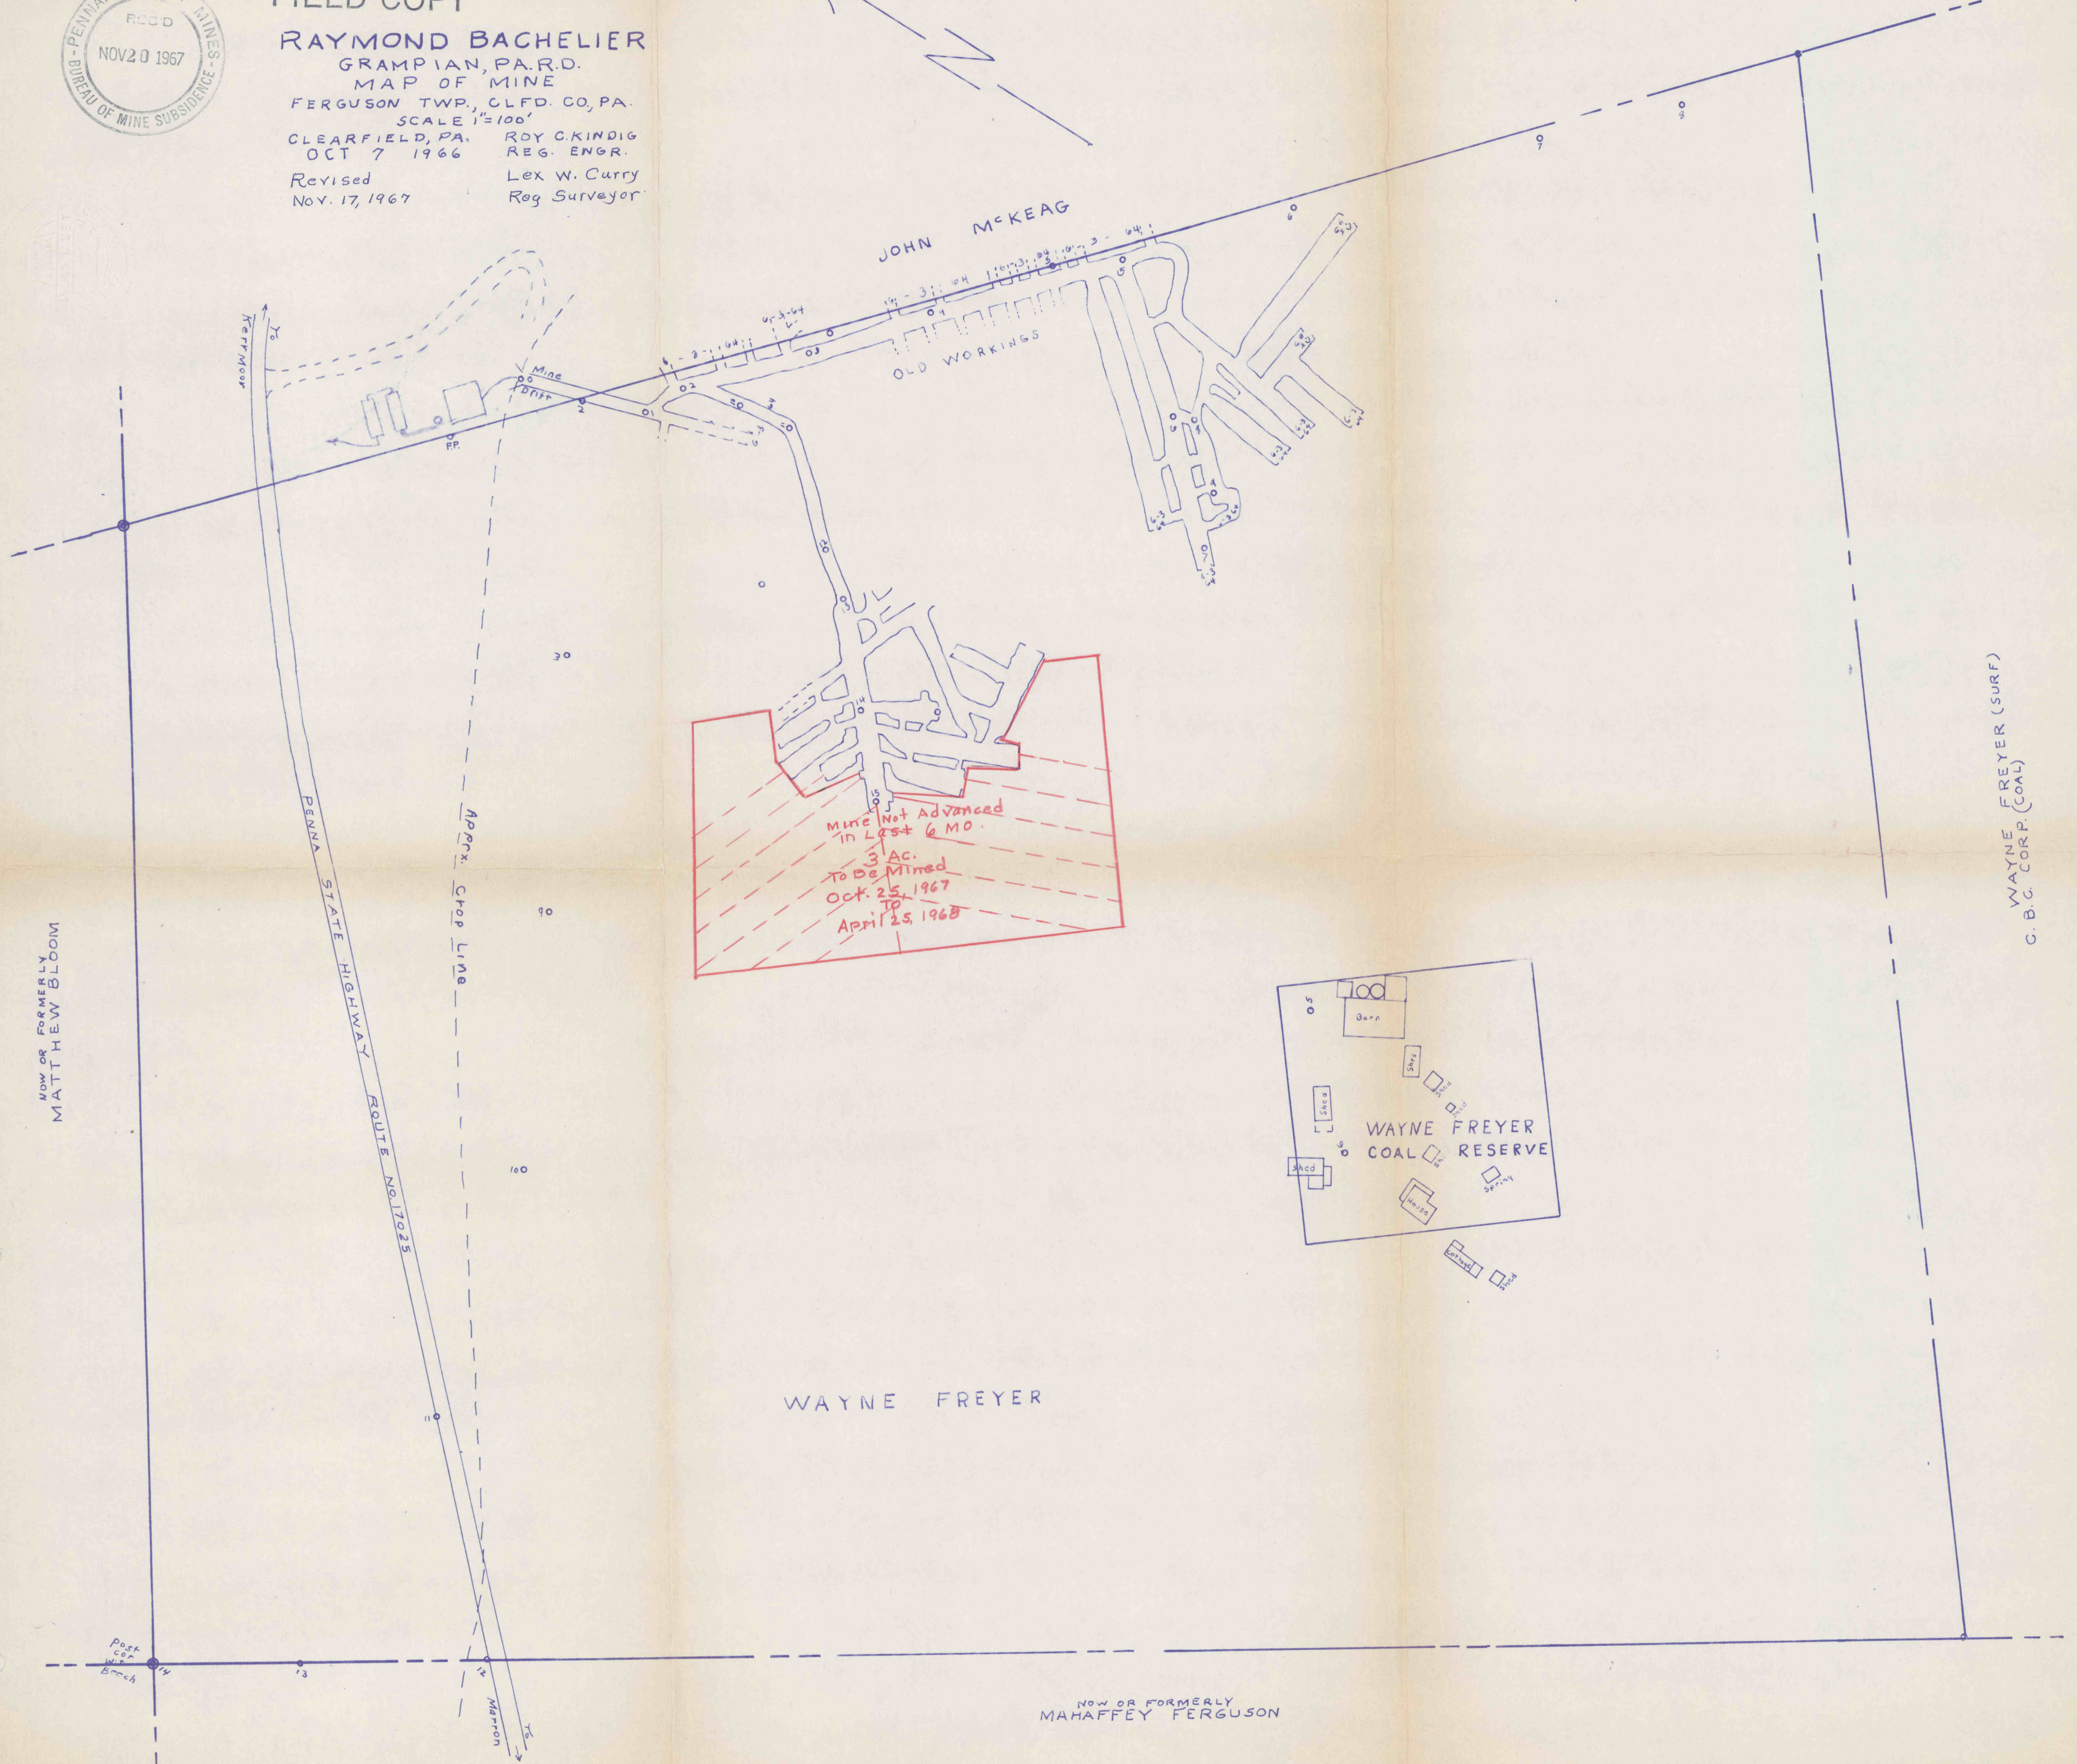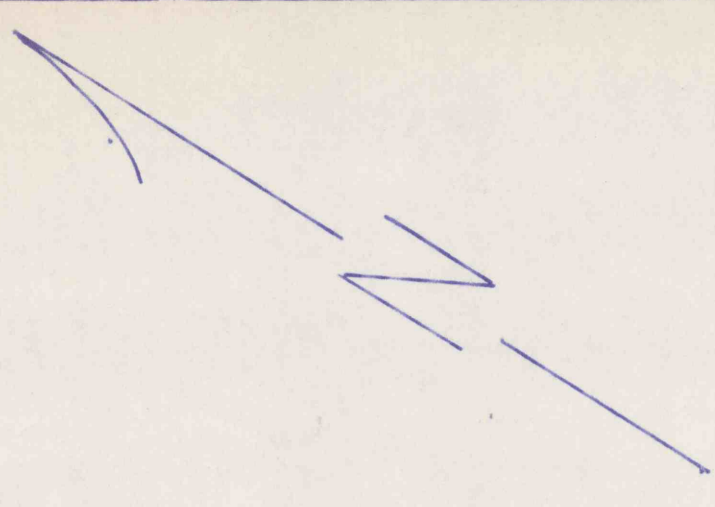

Mine Not Advanced
in Last 6 MO.
3 AC.
To Be Mined
Oct. 25, 1967
to
April 25, 1968

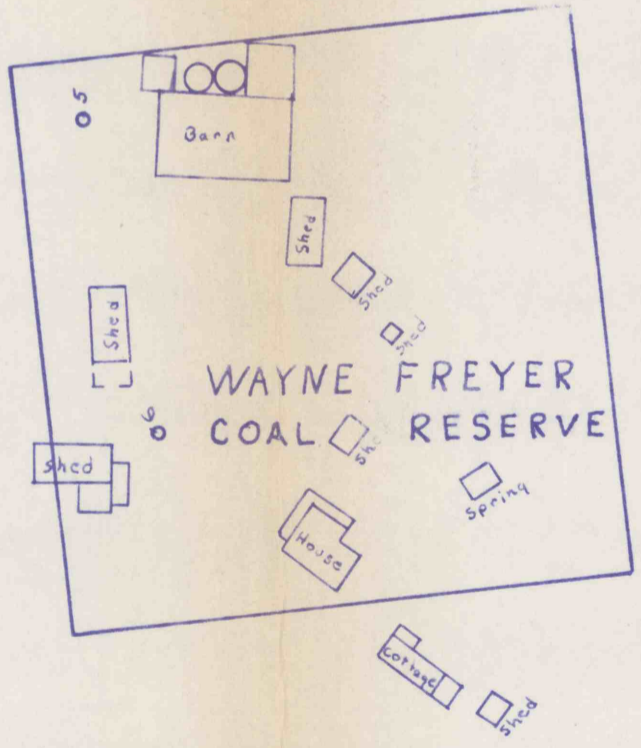

WAYNE FREYER (SURF)
G. B. C. CORP. (COAL)

NOW OR FORMERLY
MAHAFFEY FERGUSON