

JAMES M. McINTYRE & CO.

Surveyed, located & shown  
Bacon No. 5 181987

BUNKER HILL COAL CO.

# MAP OF BACON No 5 MINE

OPERATED BY  
E. EICHELBERGER & CO.  
Broad Top Township — Bedford County

Scale 1" = 100'

KELLY SEAM  
— 1928 —



MINE  
No. 5  
No. 6  
No. 9

OPERATORS  
Duvall & White  
Neville & Everitts  
Wm. H. Martin

Revised Nov. 1927

Based on No. 6

JAMES M. McINTYRE & CO.

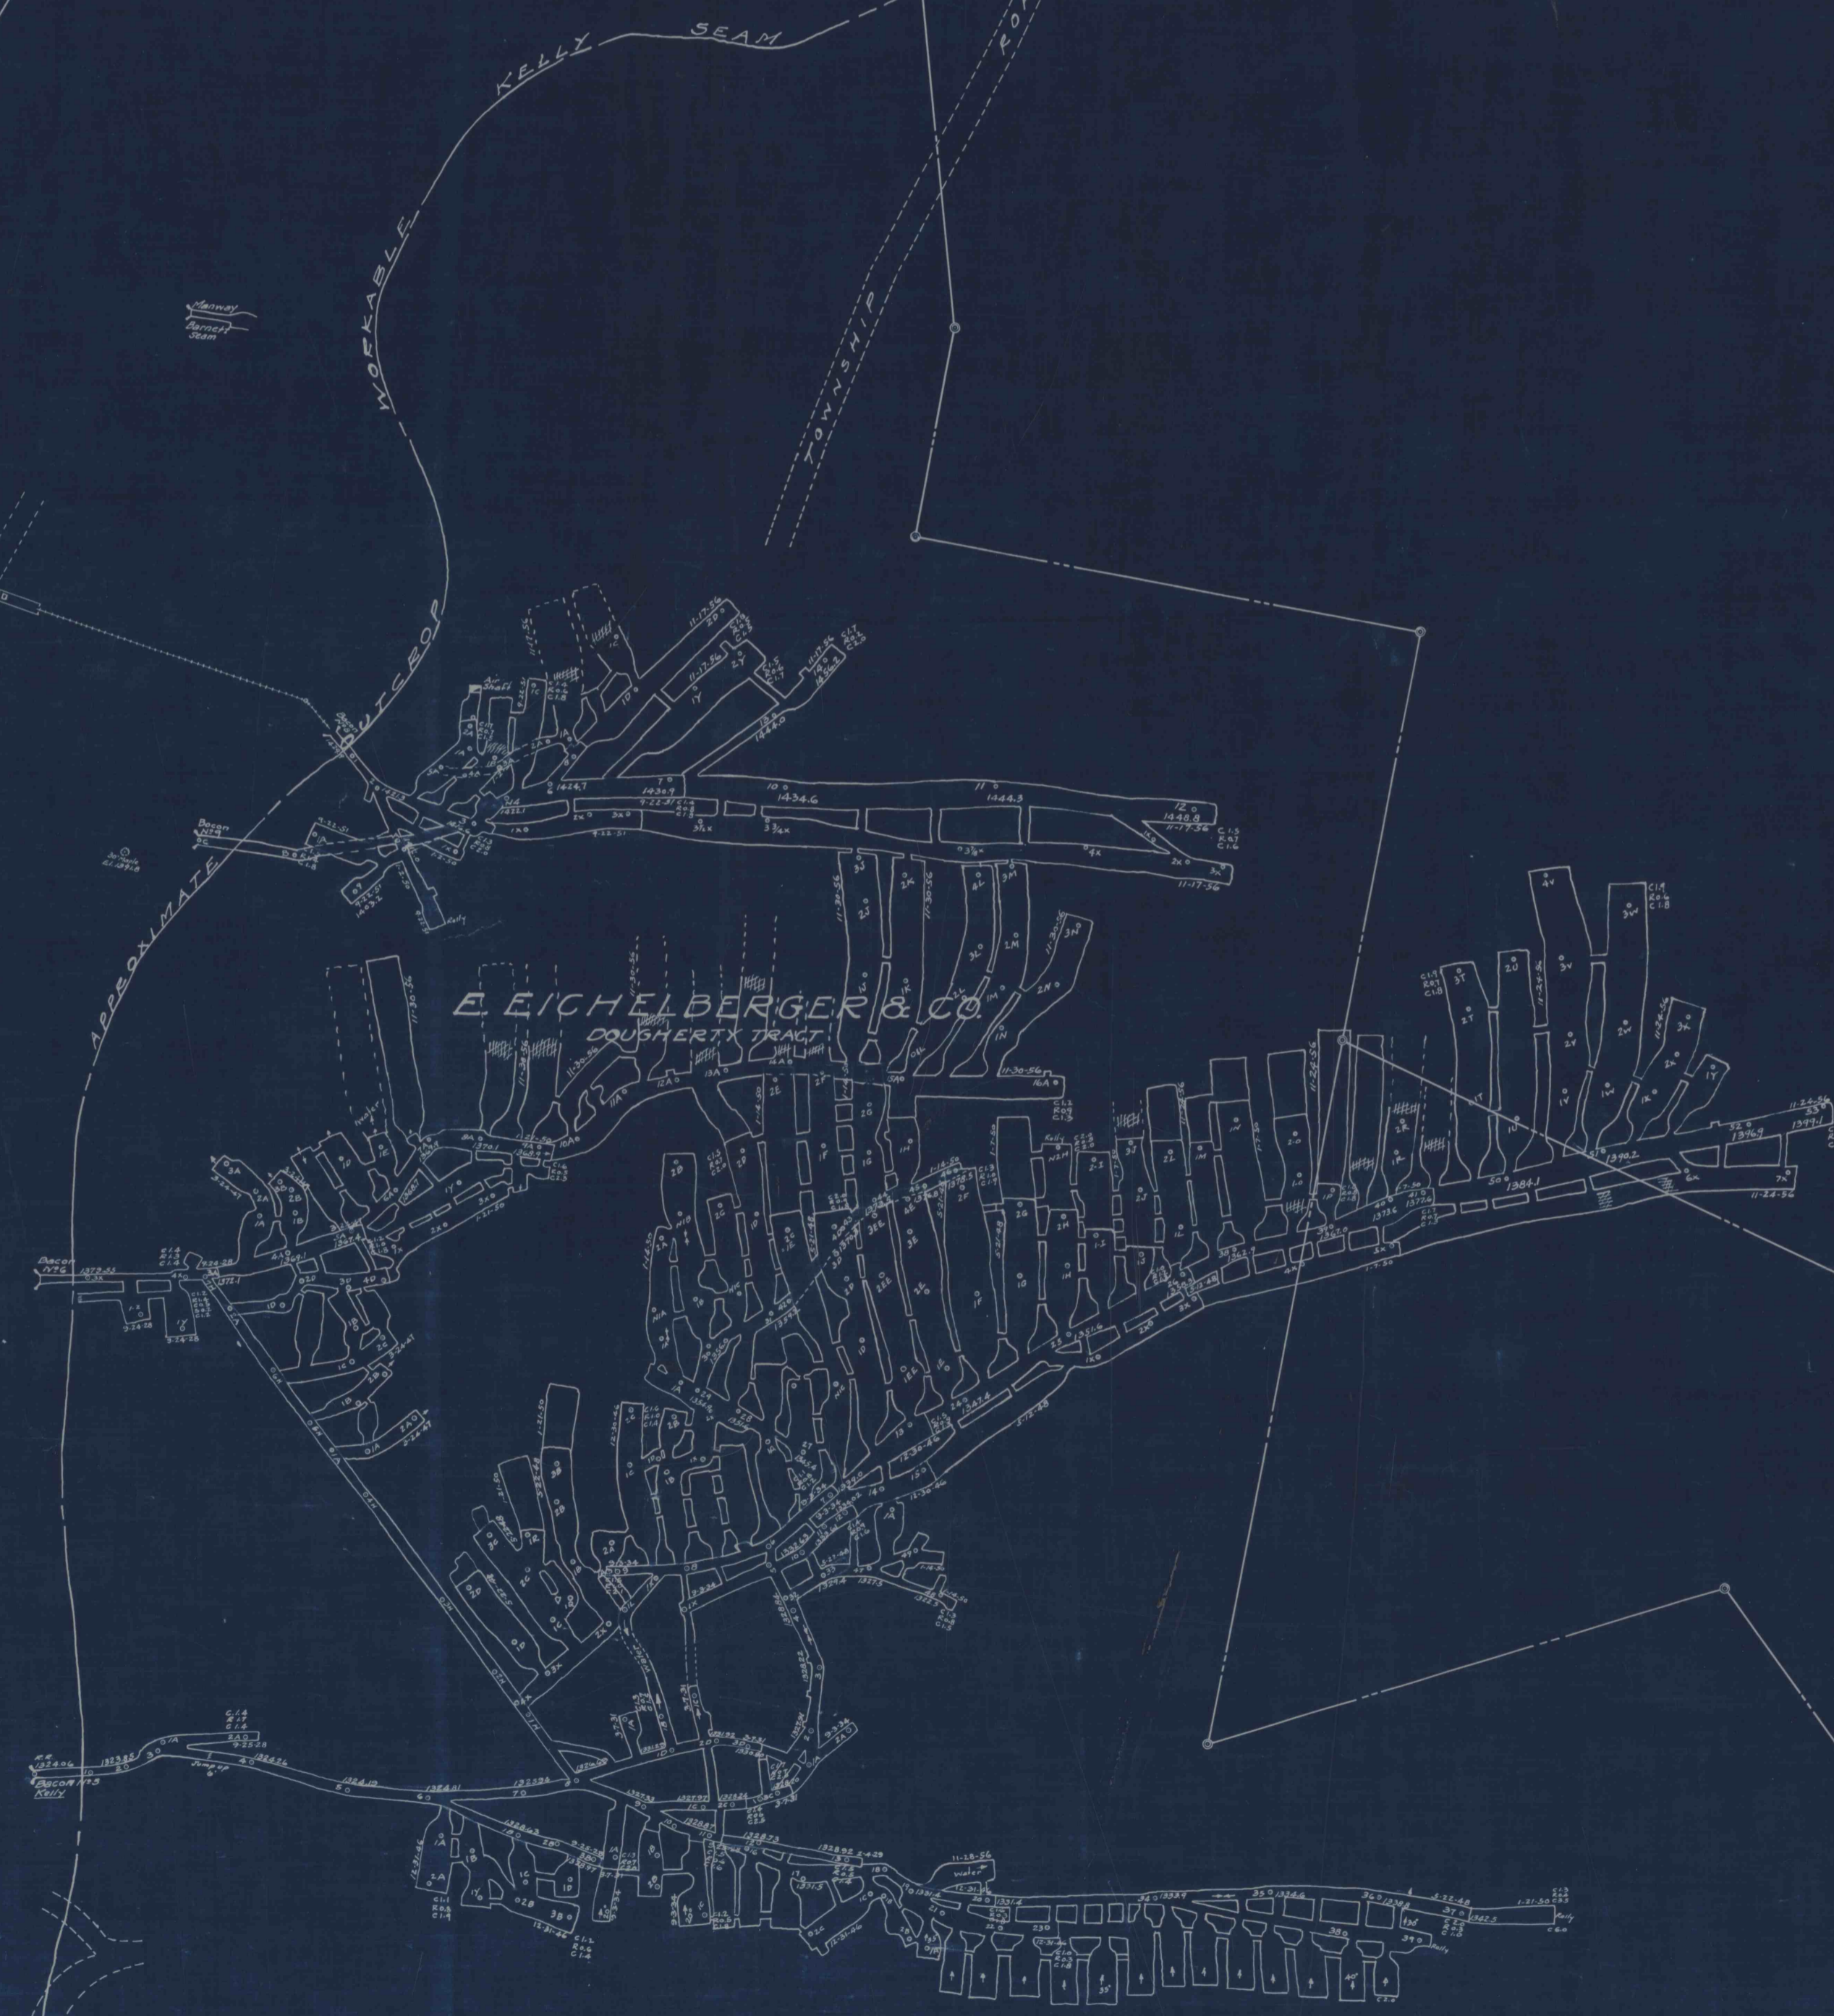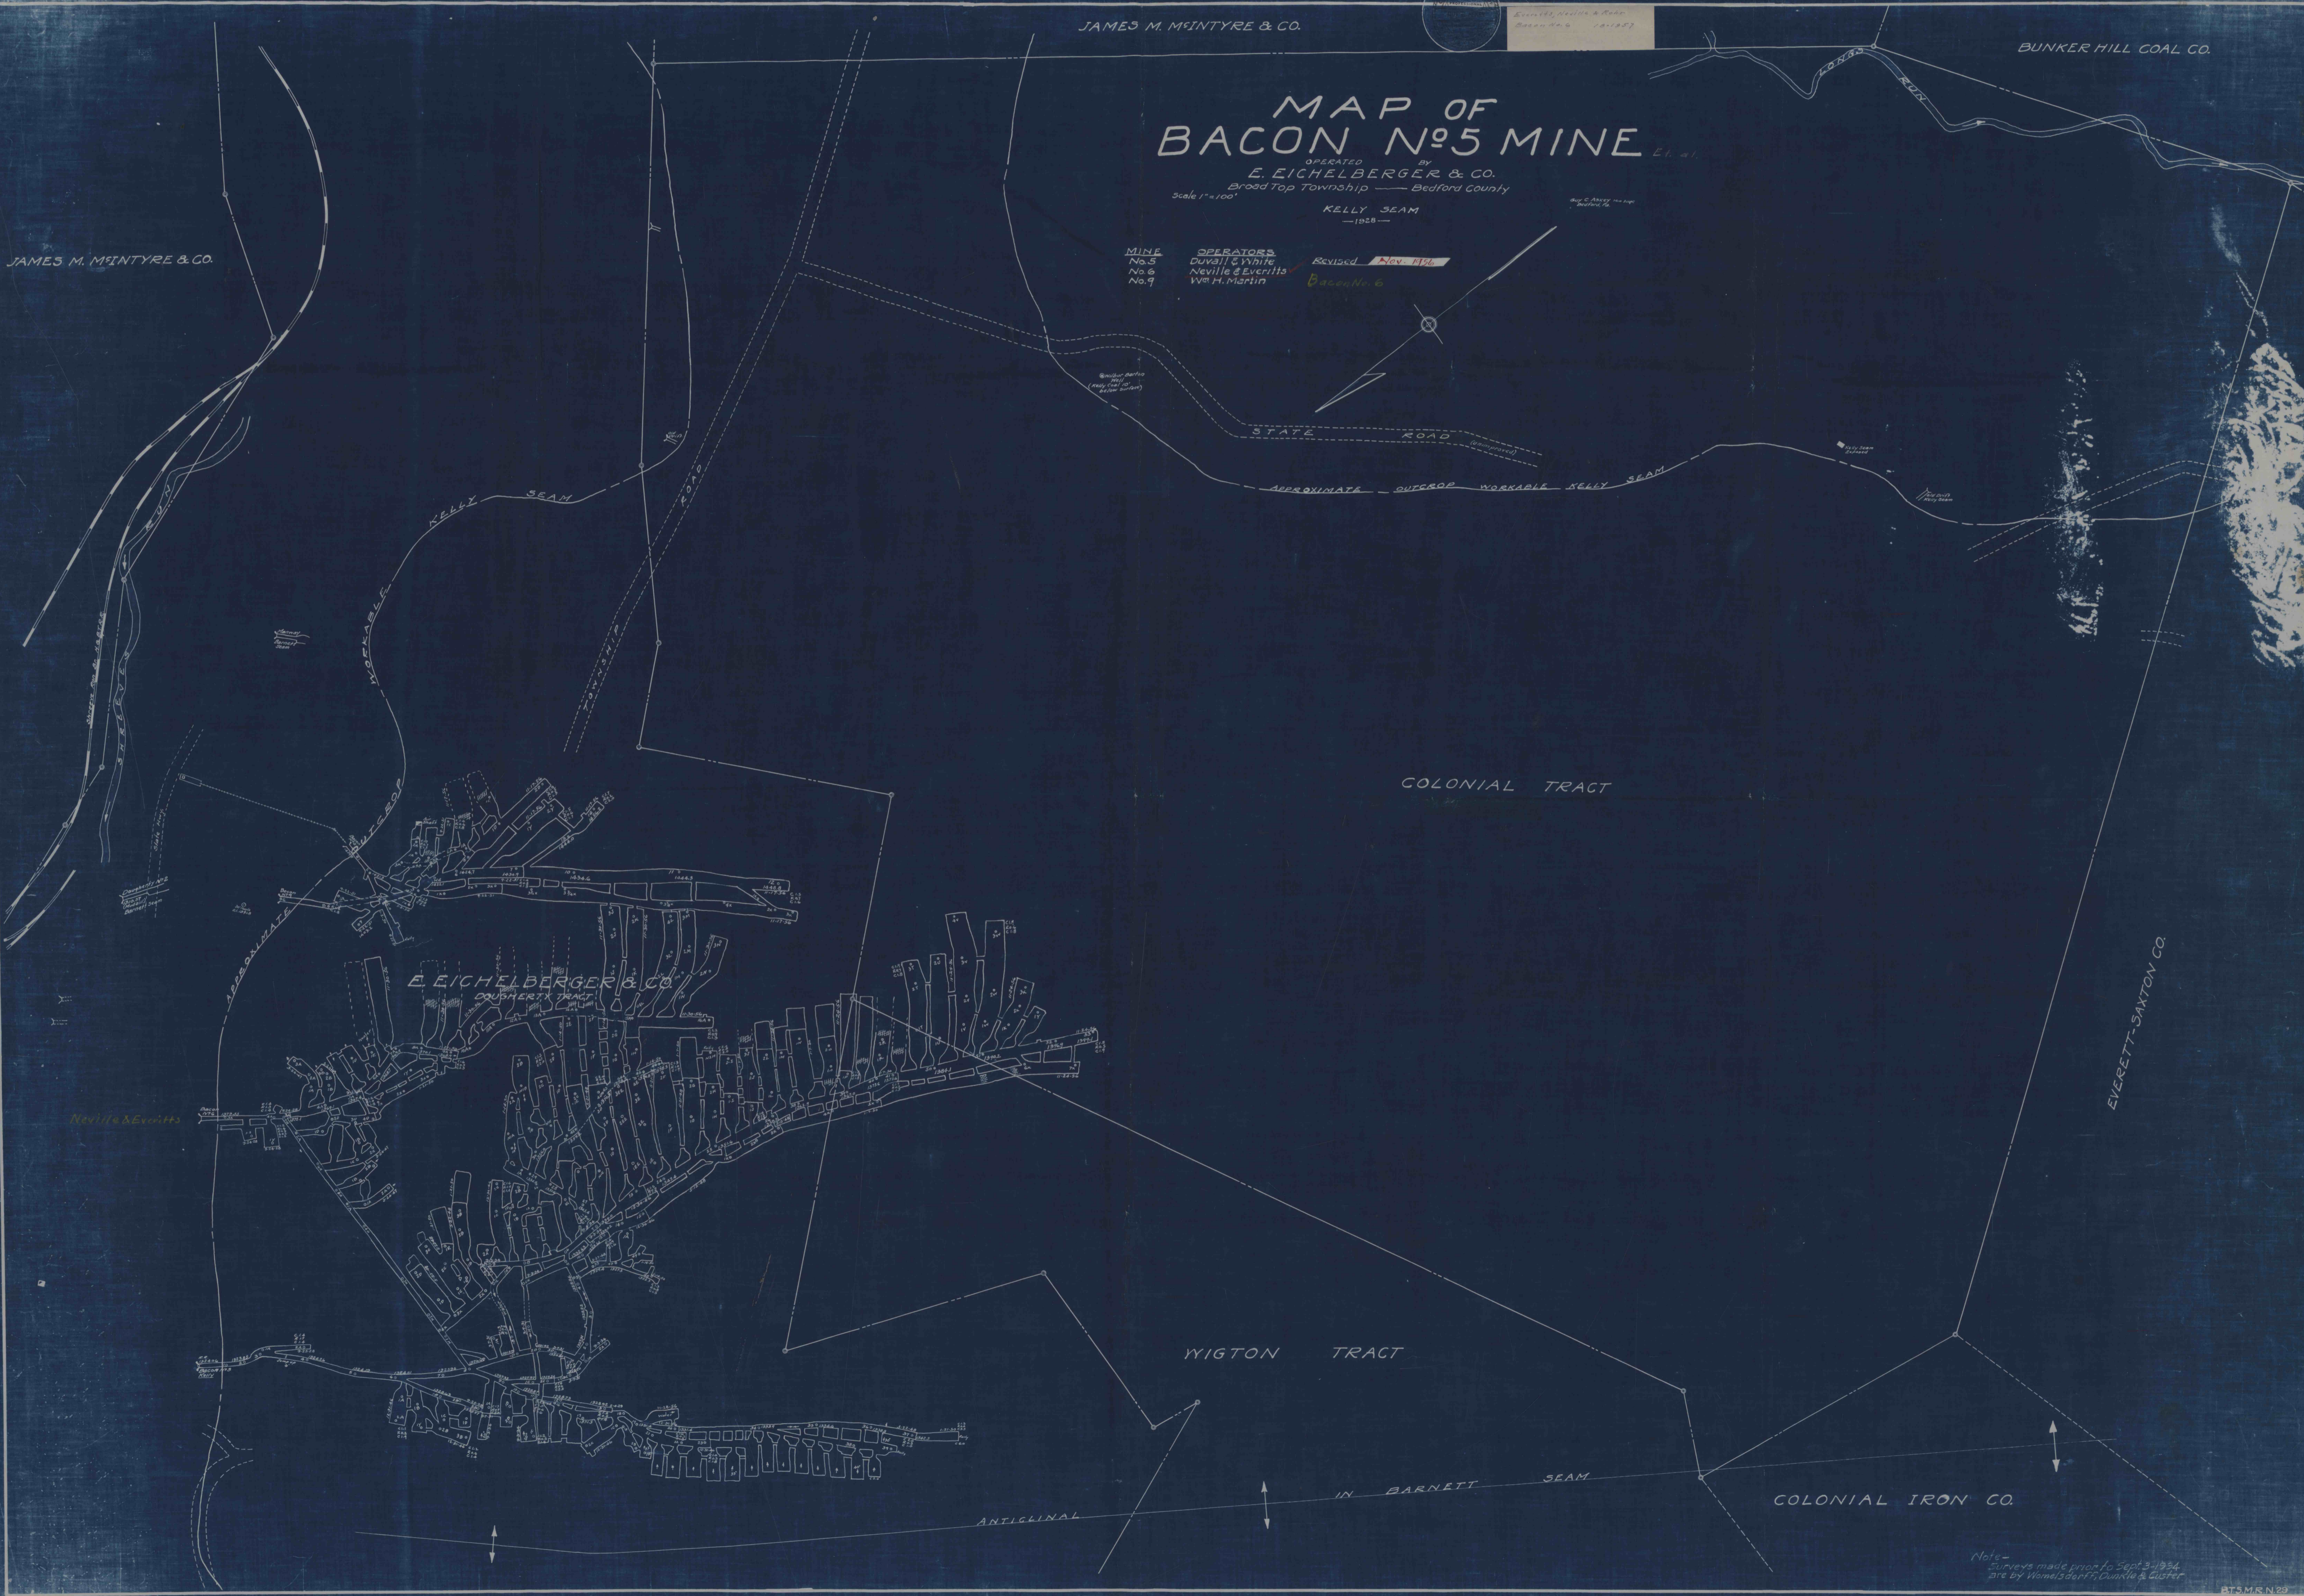

Note -  
Surveys made prior to Sept. 3-1934  
are by Womelsdorf, Dunkle & Cluser

BTSMEN29