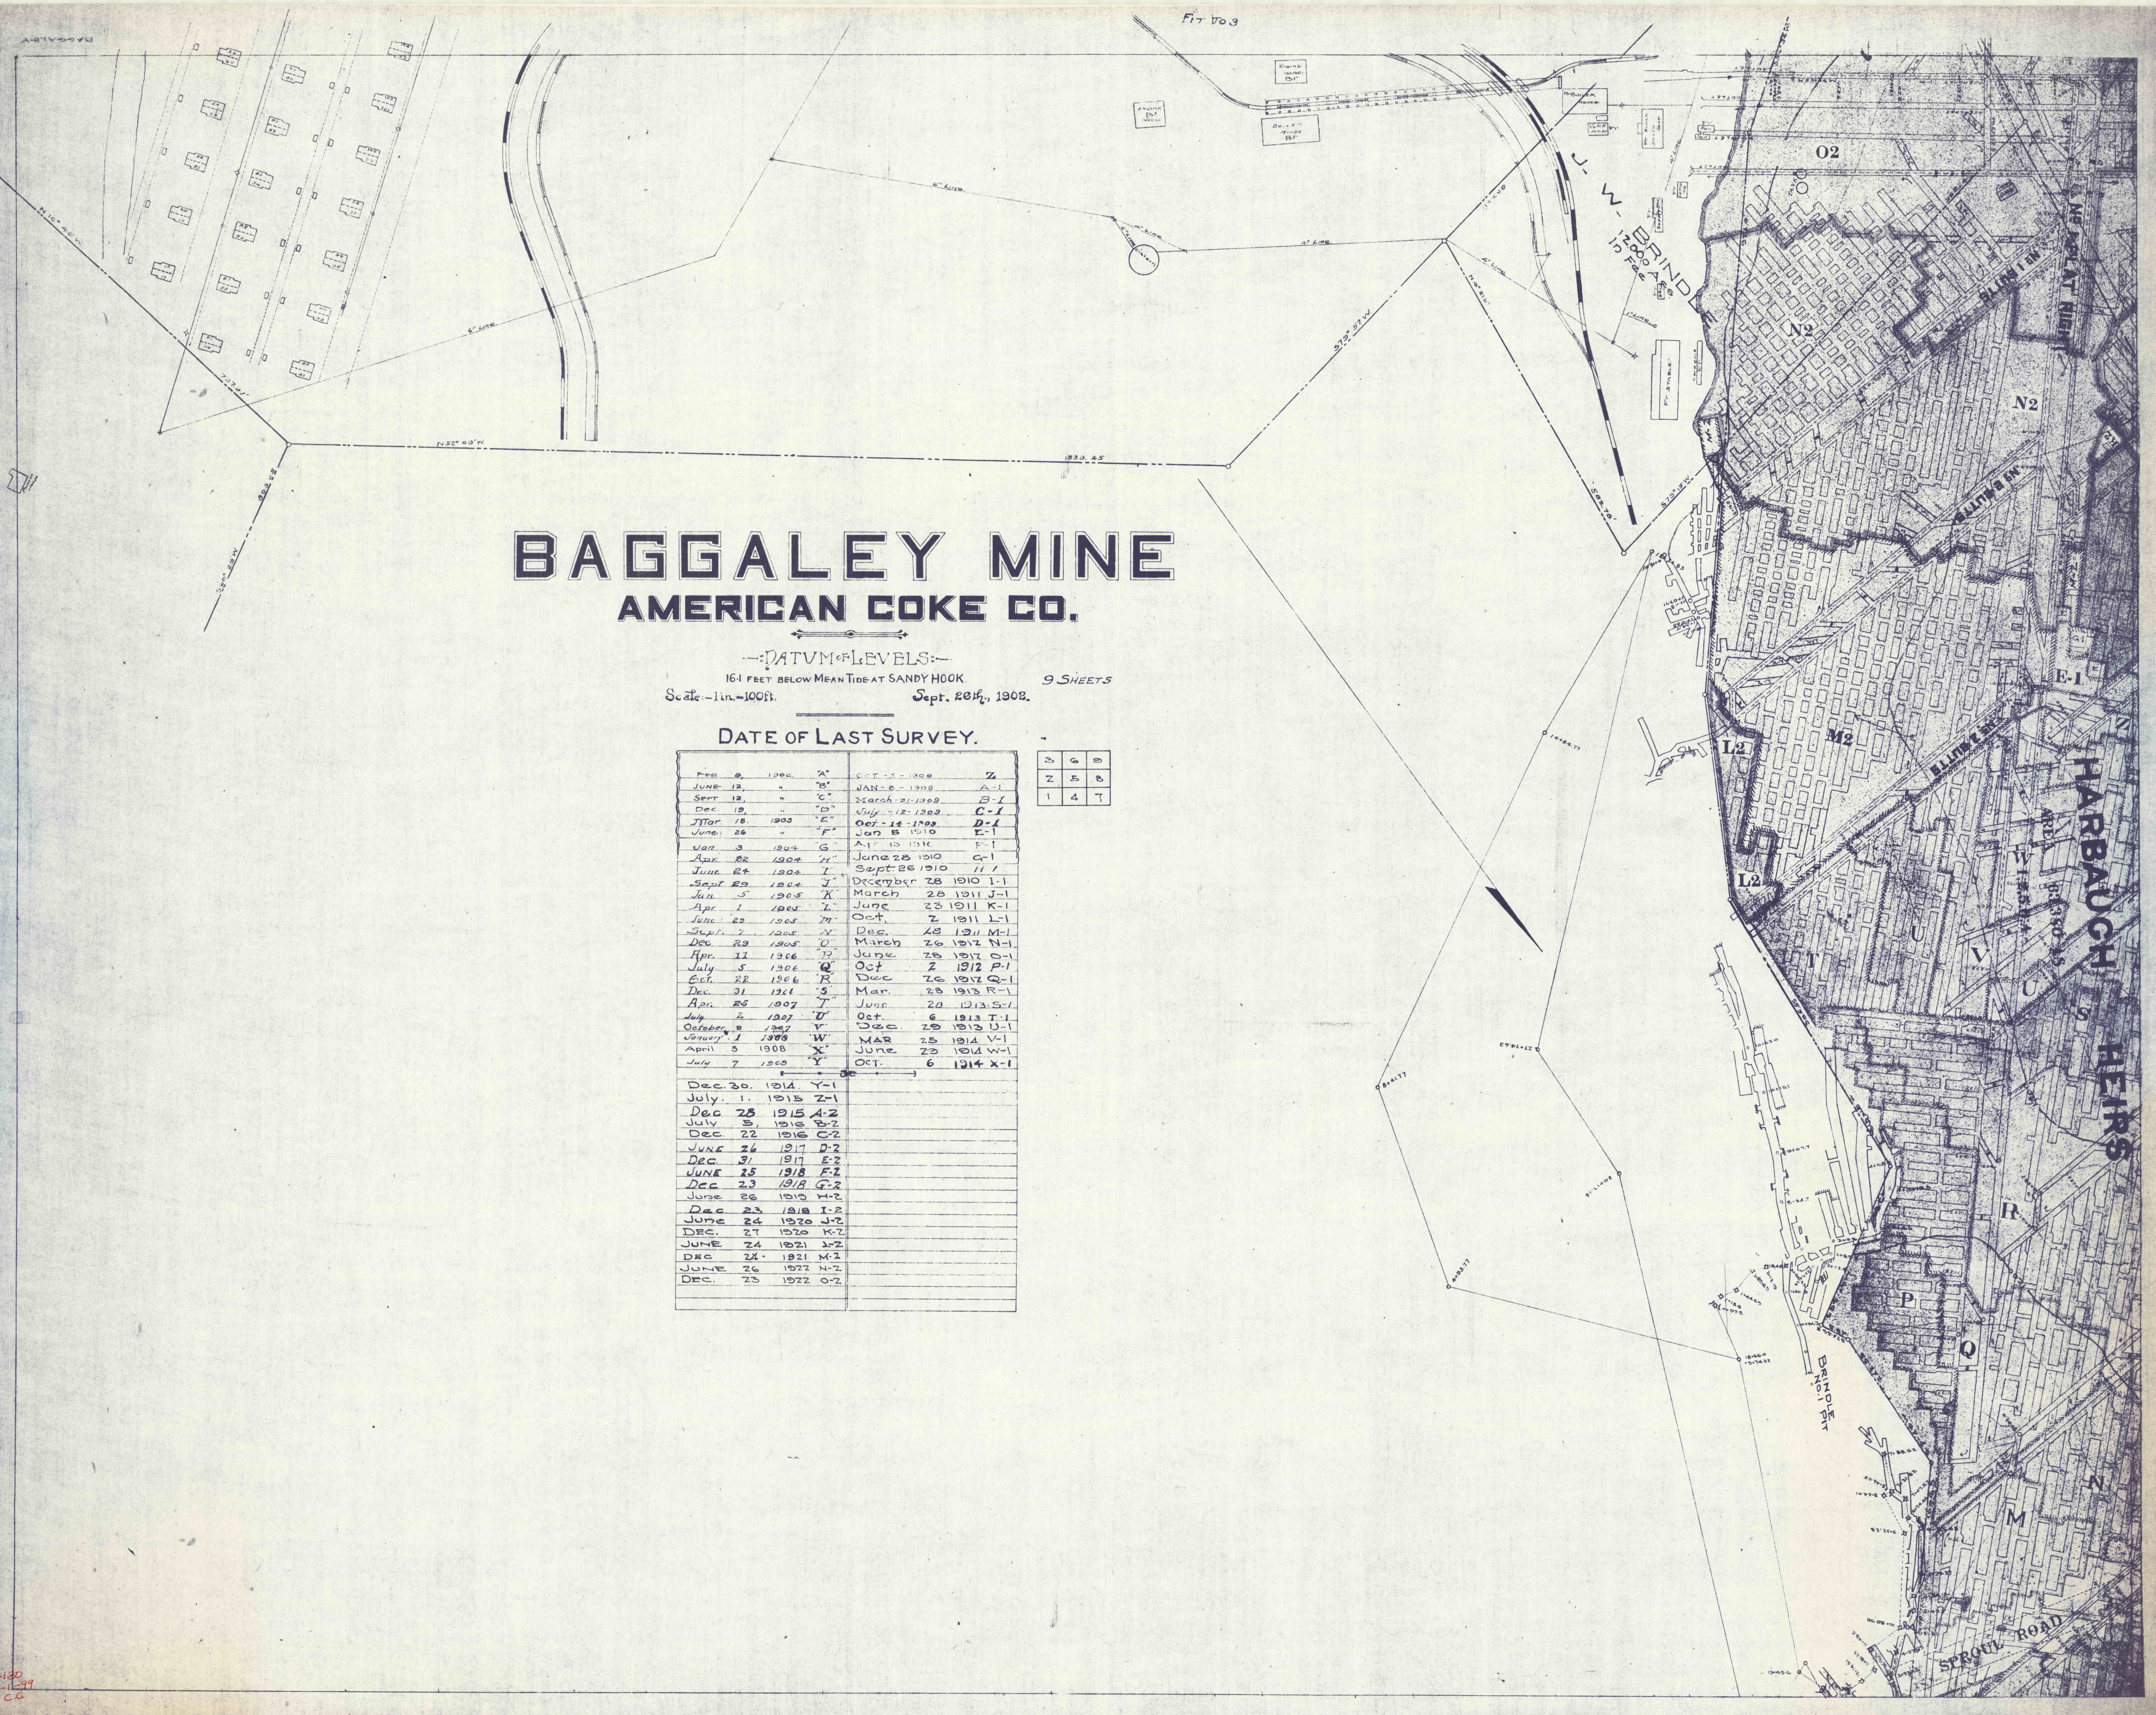

BAGGALEY MINE

AMERICAN COKE CO.

DATUM OF LEVELS:
16·1 FEET BELOW MEAN TIDE AT SANDY HOOK

Scale – 1 in. = 100 ft. Sept. 26th, 1902. 9 SHEETS

DATE OF LAST SURVEY.

Feb 8, 1902	"A"	Oct - 3 - 1908	Z
June 12, "	"B"	Jan - 8 - 1909	A-1
Sept 12, "	"C"	March - 31 - 1909	B-1
Dec 19, "	"D"	July - 12 - 1909	C-1
Mar 18, 1903	"E"	Oct - 14 - 1909	D-1
June 26 "	"F"	Jan 8 1910	E-1
Jan 3 1904	"G"	Apr 13 1910	F-1
Apr 22 1904	"H"	June 28 1910	G-1
June 24 1904	"I"	Sept 26 1910	H-1
Sept 29 1904	"J"	December 28 1910	I-1
Jan 5 1905	"K"	March 28 1911	J-1
Apr 1 1905	"L"	June 23 1911	K-1
June 29 1905	"M"	Oct 2 1911	L-1
Sept 7 1905	"N"	Dec 28 1911	M-1
Dec 29 1905	"O"	March 26 1912	N-1
Apr 11 1906	"P"	June 28 1912	O-1
July 5 1906	"Q"	Oct 2 1912	P-1
Oct 22 1906	"R"	Dec 26 1912	Q-1
Dec 31 1906	"S"	Mar 28 1913	R-1
Apr 25 1907	"T"	June 20 1913	S-1
July 2 1907	"U"	Oct 6 1913	T-1
October 8 1907	"V"	Dec 29 1913	U-1
January 1 1908	"W"	MAR 25 1914	V-1
April 5 1908	"X"	June 23 1914	W-1
July 7 1908	"Y"	Oct 6 1914	X-1
Dec. 30. 1914 Y-1			
July 1. 1915 Z-1			
Dec 28 1915 A-2			
July 5, 1916 B-2			
Dec. 22 1916 C-2			
June 26 1917 D-2			
Dec. 31 1917 E-2			
June 25 1918 F-2			
Dec 23 1918 G-2			
June 26 1919 H-2			
Dec. 23 1919 I-2			
June 24 1920 J-2			
Dec. 27 1920 K-2			
June 24 1921 L-2			
Dec 24 1921 M-2			
June 26 1922 N-2			
Dec. 23 1922 O-2			

3	6	9
2	5	8
1	4	7