

Raymond Nelson

Marion Brooks


NOYES TRACT

JOE MICALE et al
LOUIS and CHIAPELLI

Workings for Six Months
Oct 25, 1966 to
Mar 25, 1967

BAKEMANS HOLLOW #6
B Seam

New Shawmut Mining Co.

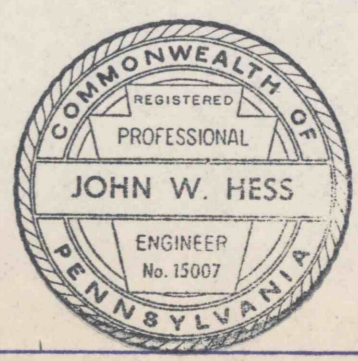

JOSEPH	MICALE
BAKEMANS HOLLOW #6	
Jay Twp. Elk Co, Penna.	
SCALE — 1 inch = 100 foot	
October 27, 1966	John W. Hess
Clearfield, Pa.	Engineer

North
0 1" = 100'

#442
C.C.