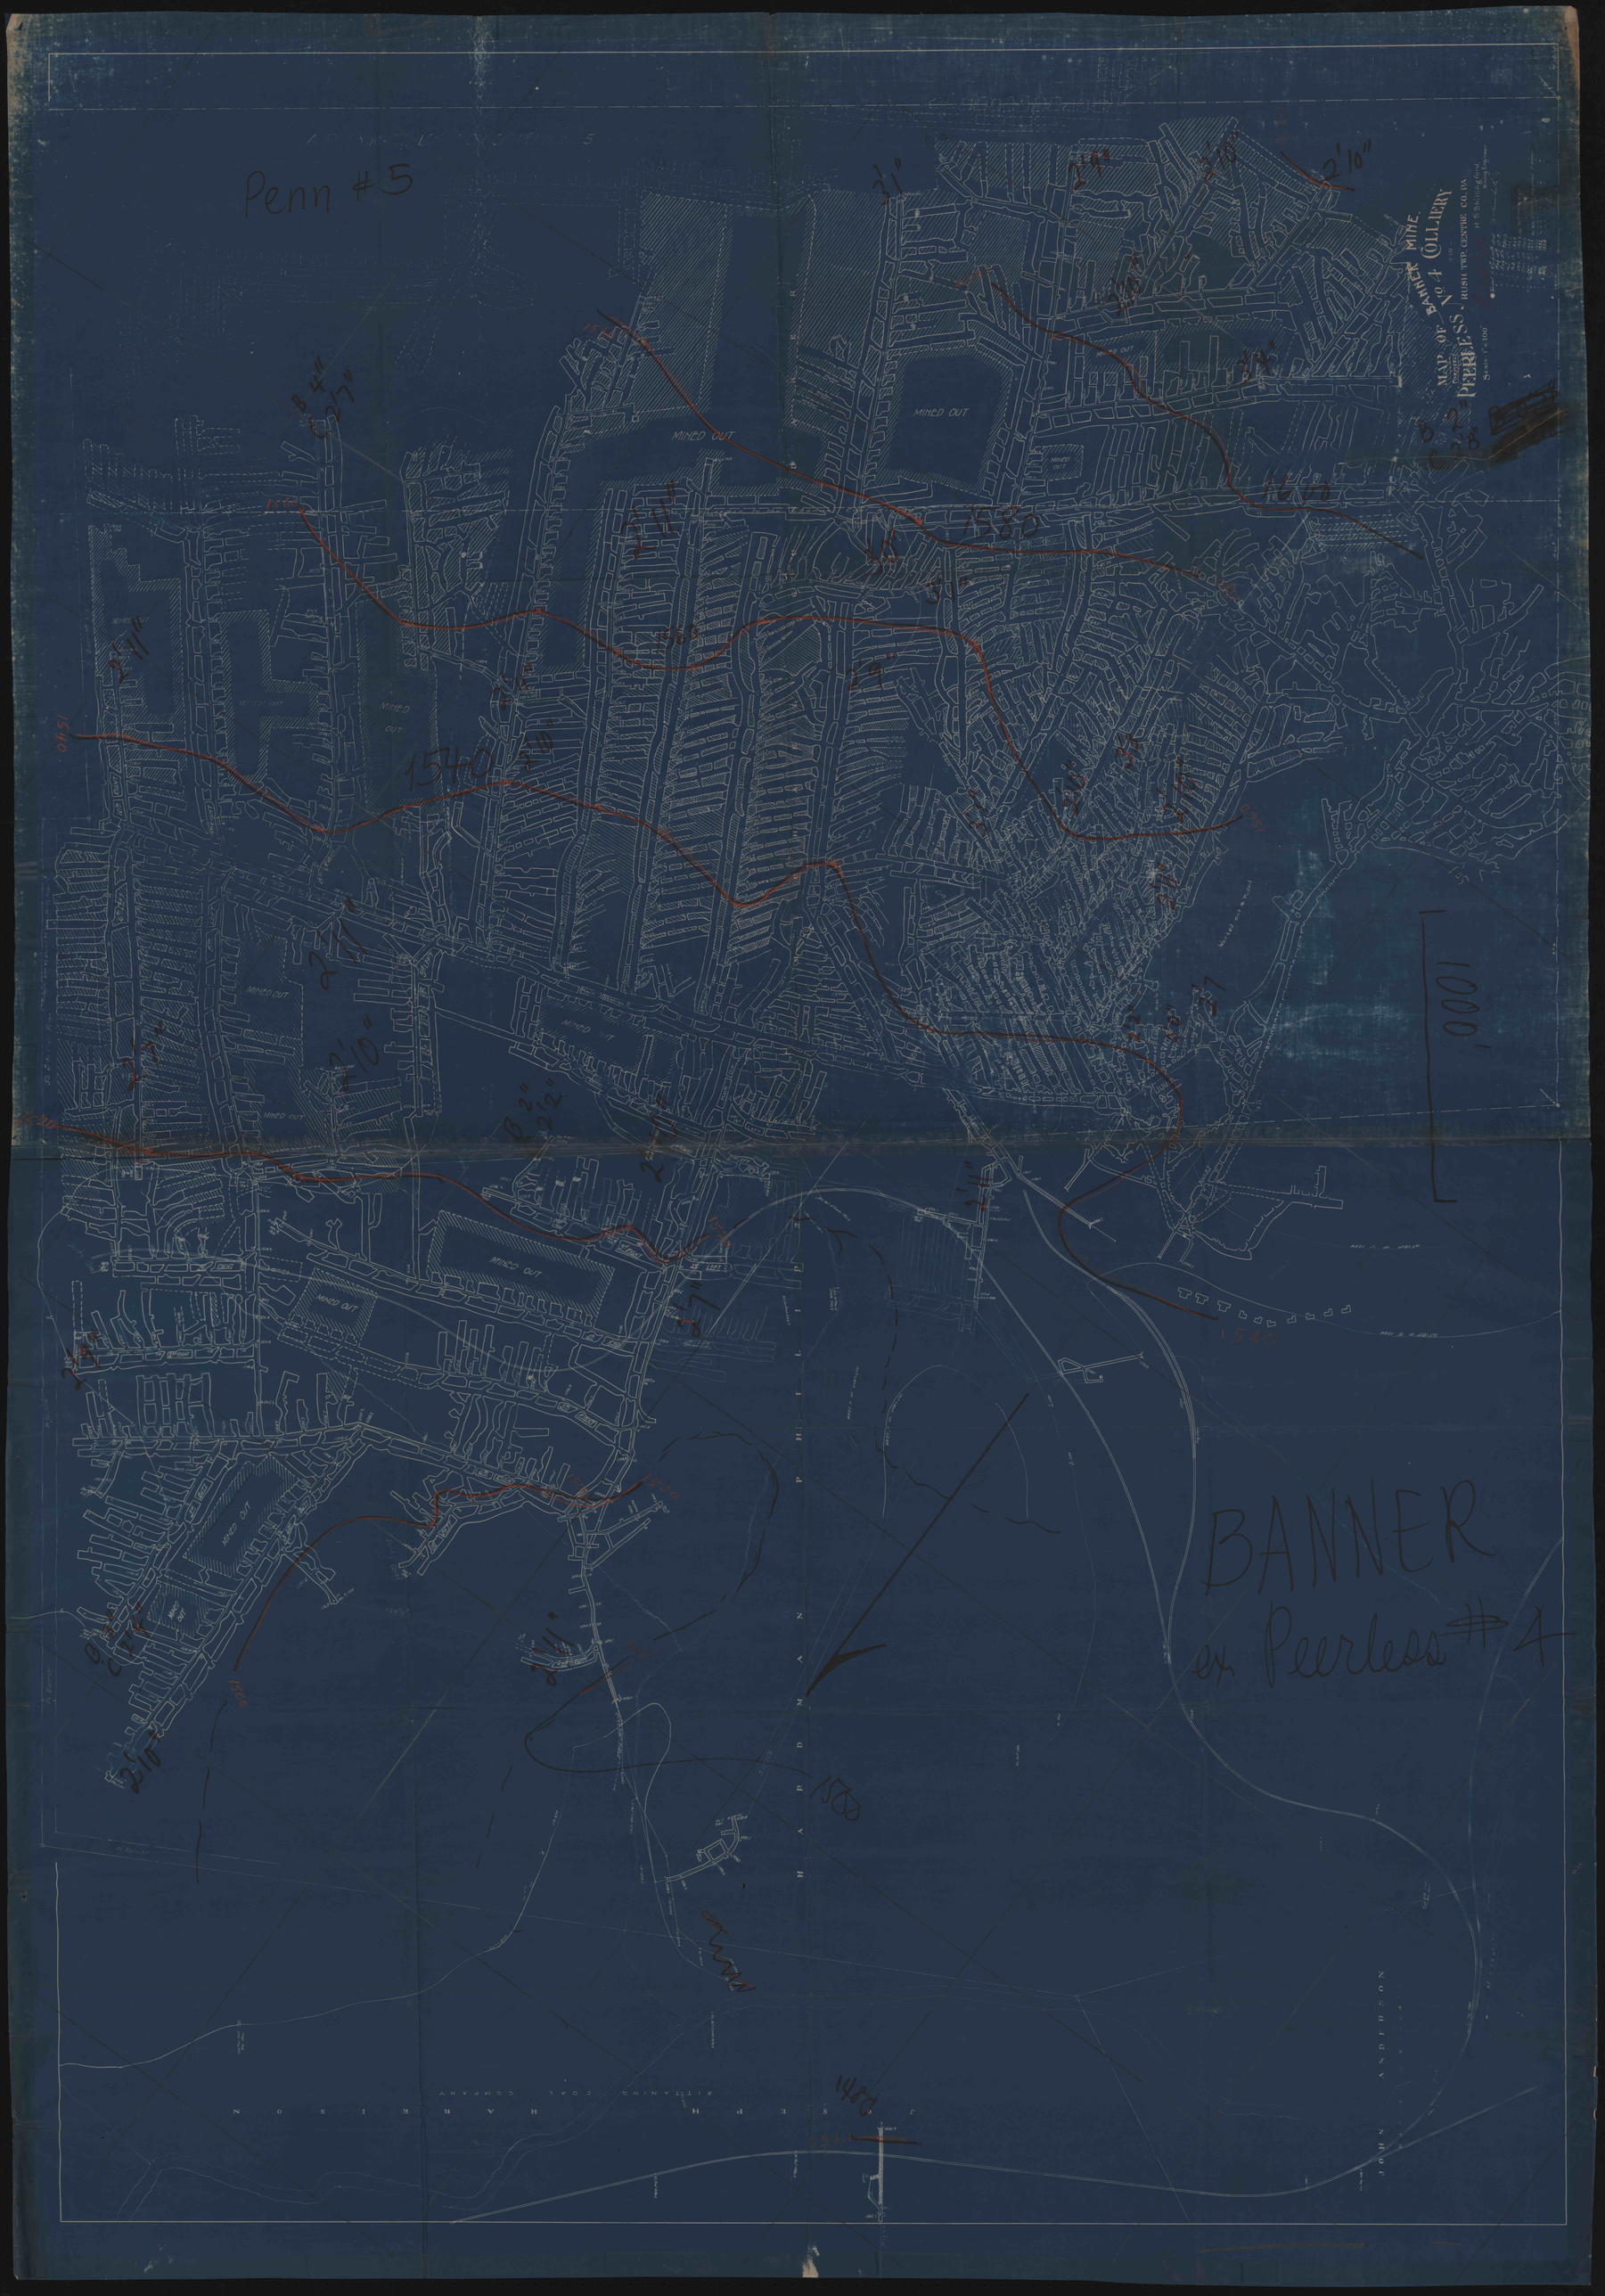
Penn #5
MAP OF BANNER MINE
PEERLESS No 4 COLLIERY
RUSH TWP. CENTRE CO. PA.
Scale 1" = 100'
MINED OUT
1000'
BANNER
ex Peerless #4
HARDMAN PHILLIPS
JOSEPH HARRISON
KITTANING COAL COMPANY
JOHN ANDERSON