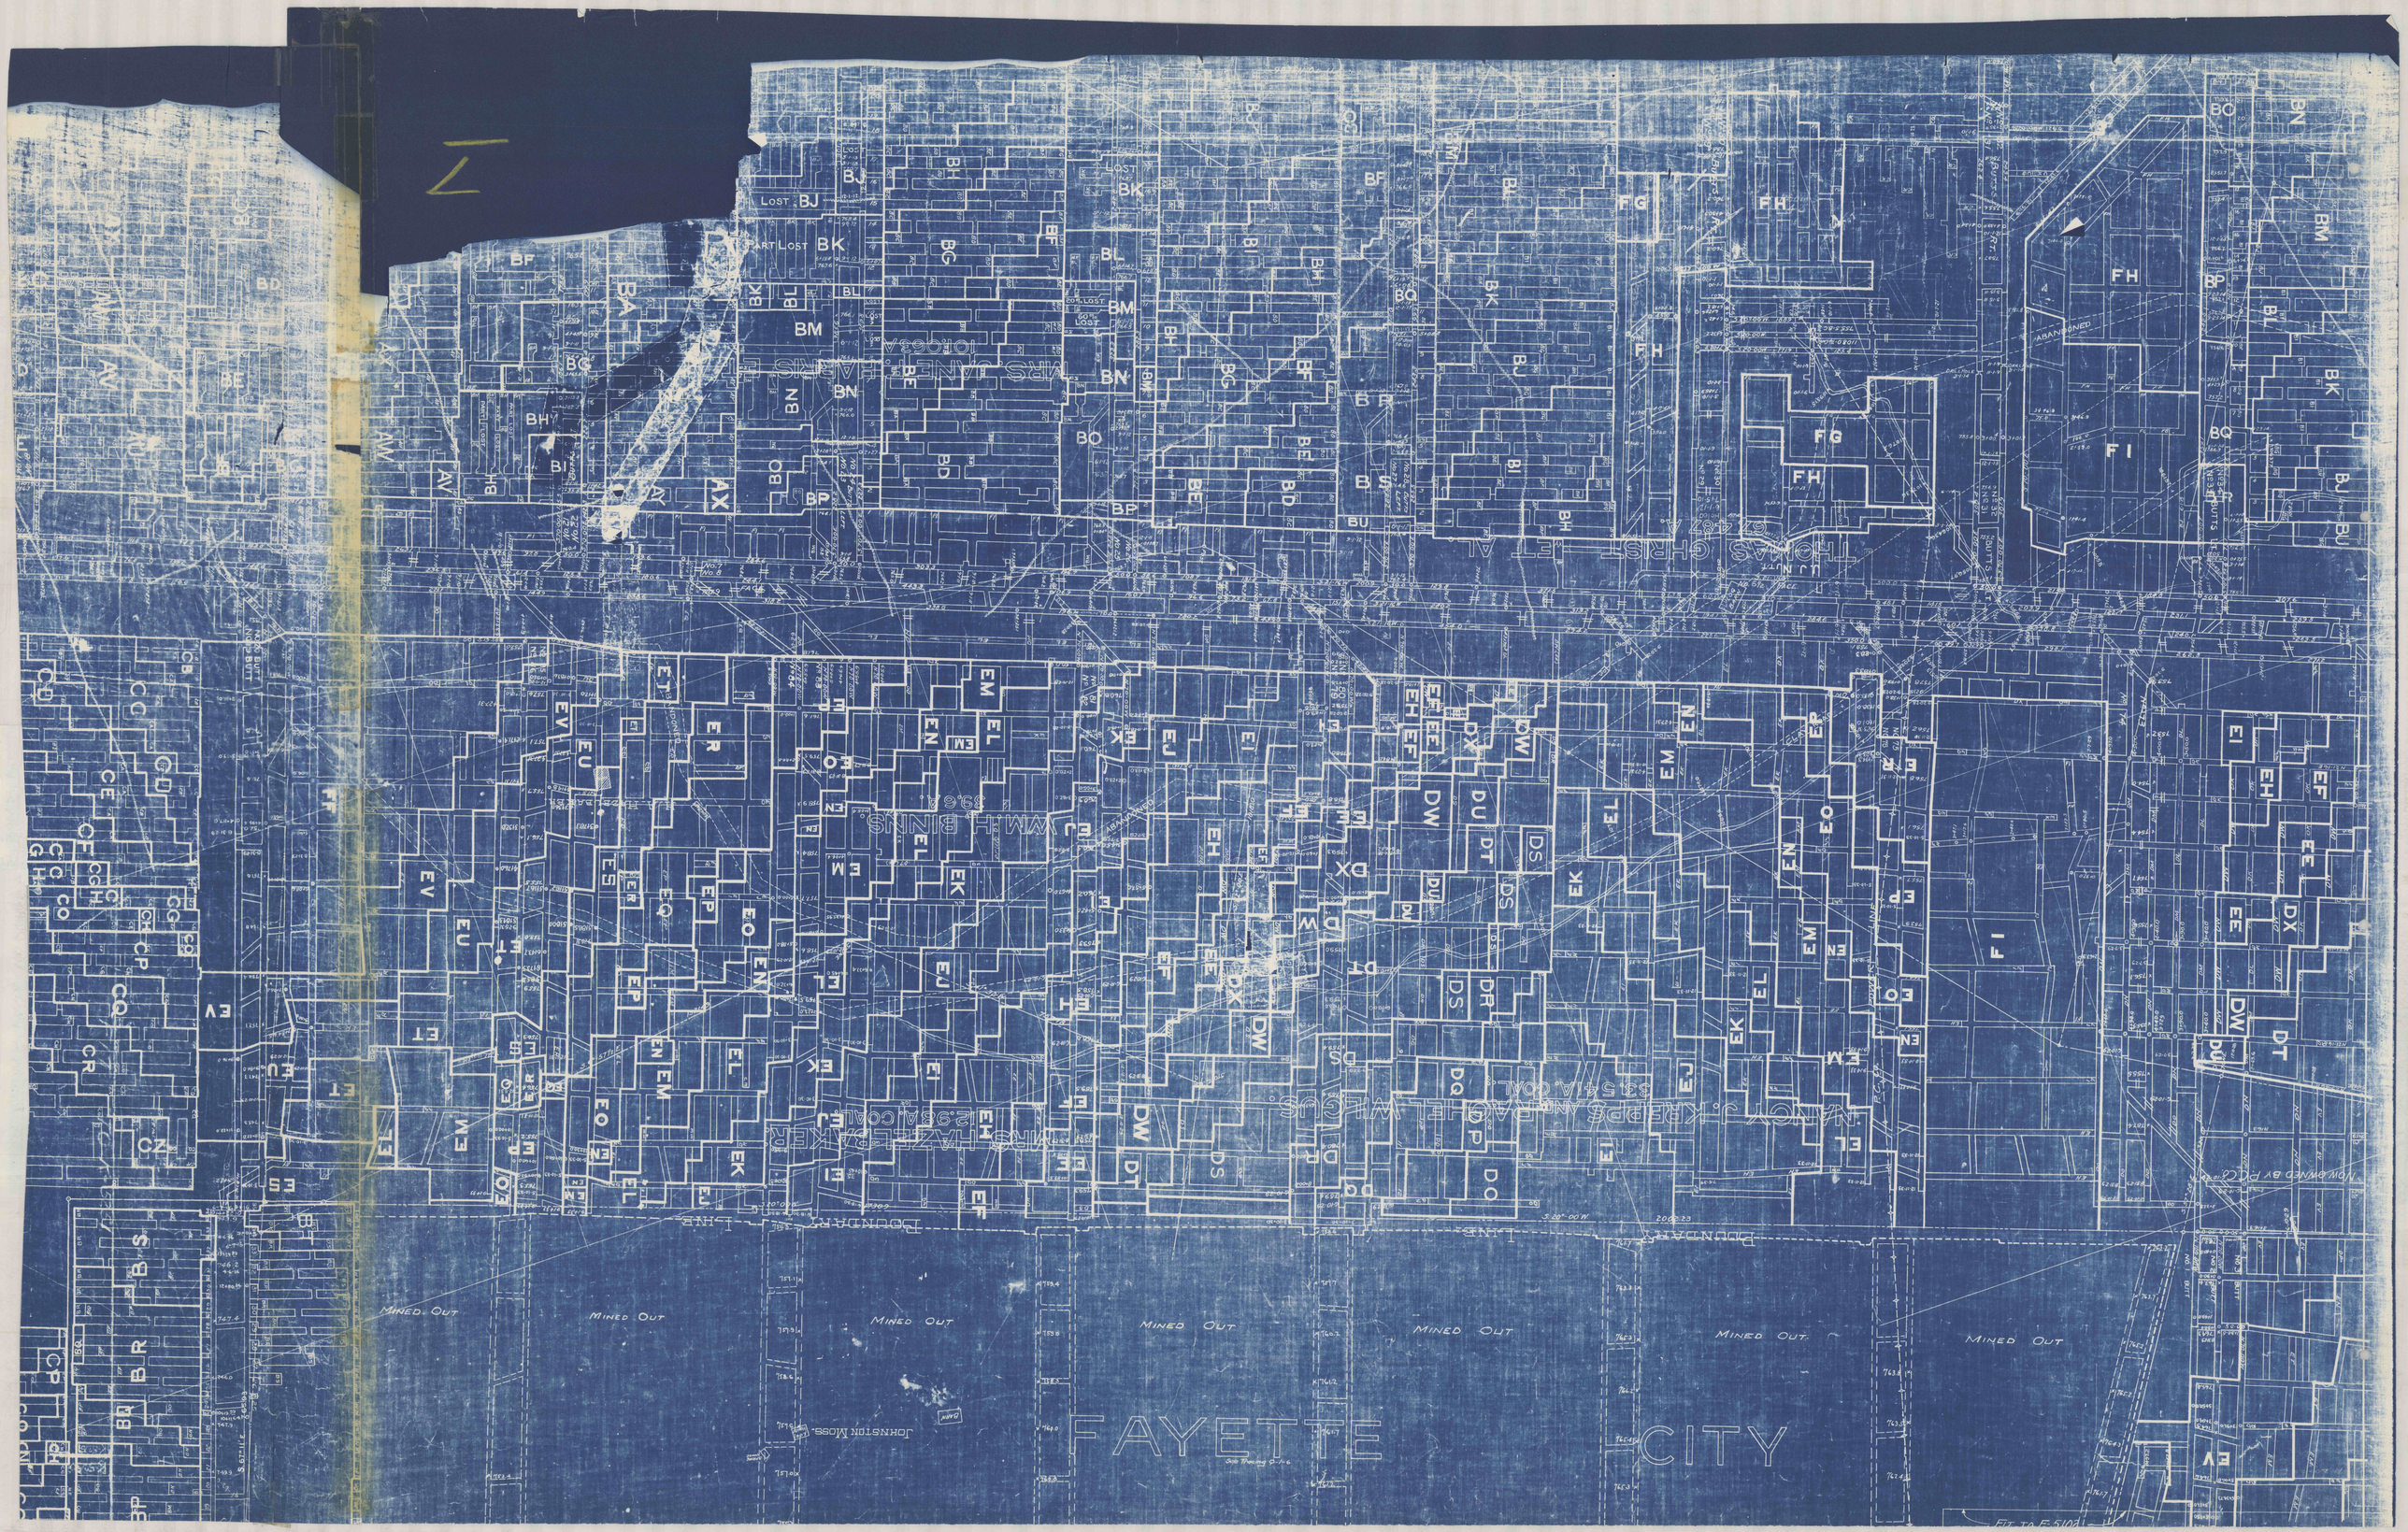

FAYETTE CITY
See Tracing 9-1-6
FIT TO F-5108
MINED OUT
MINED OUT
MINED OUT
MINED OUT
MINED OUT
MINED OUT
JOHNSTON MOSS
BARN
LOG HOUSE
SPRING HOUSE
BOUNDARY LINE
BOUNDARY LINE
NOW OWNED BY P.C.Co.
P.C.Co. LINE
NANCY J. KREPPS AND RACHEL WILGUS.
33.541A. COAL
MRS. HAZEL BAKER
12.98A. COAL
WM. H. BINNS
39.6 A.
H.A. HAZELBAKER
ABANDONED
U.J. NUTT
THOMAS GHRIST ET AL.
67.487 A.
MRS. JANE F. HARRIS ET AL.
101.063 A.
ABANDONED
BUTTS
PART LOST
LOST
7