


PITTSBURGH CONSOLIDATION COAL CO.
 PLAN SHOWING
 BANNING No 2 MINE
 SITUATE IN
 WASHINGTON & JEFFERSON TWP'S.
 FAYETTE COUNTY
 SCALE 1"=100'

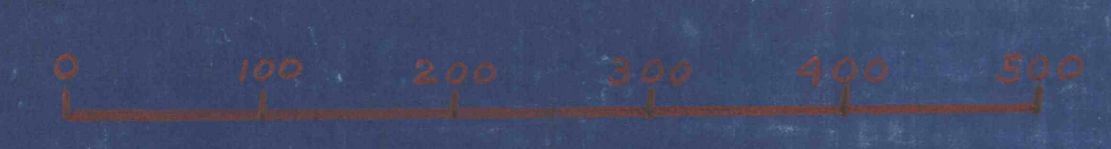

I hereby certify this is a true and correct copy of the mine workings as of March 30, 1946
H.S. Pellam Chief Engineer

