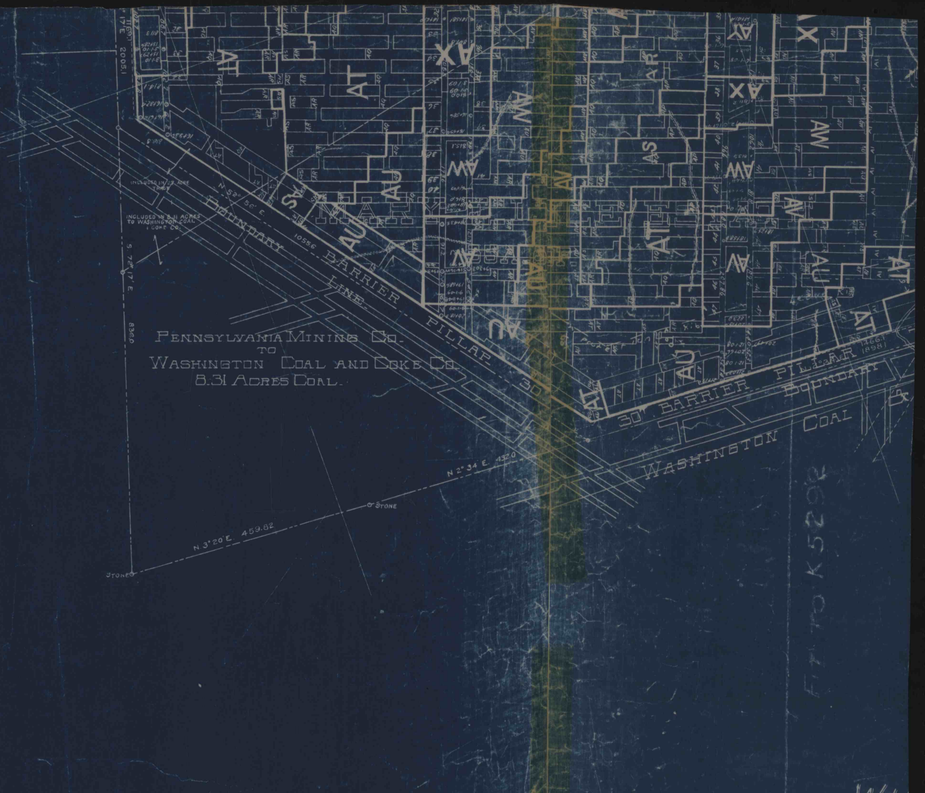
Pennsylvania Mining Co.
to
Washington Coal and Coke Co.
8.31 Acres Coal.
Barrier Pillar
Boundary
Washington Coal
N 3°34 E 432.0
N 3°20 E 459.0E
Stone
Stone
Scale 100 ft.