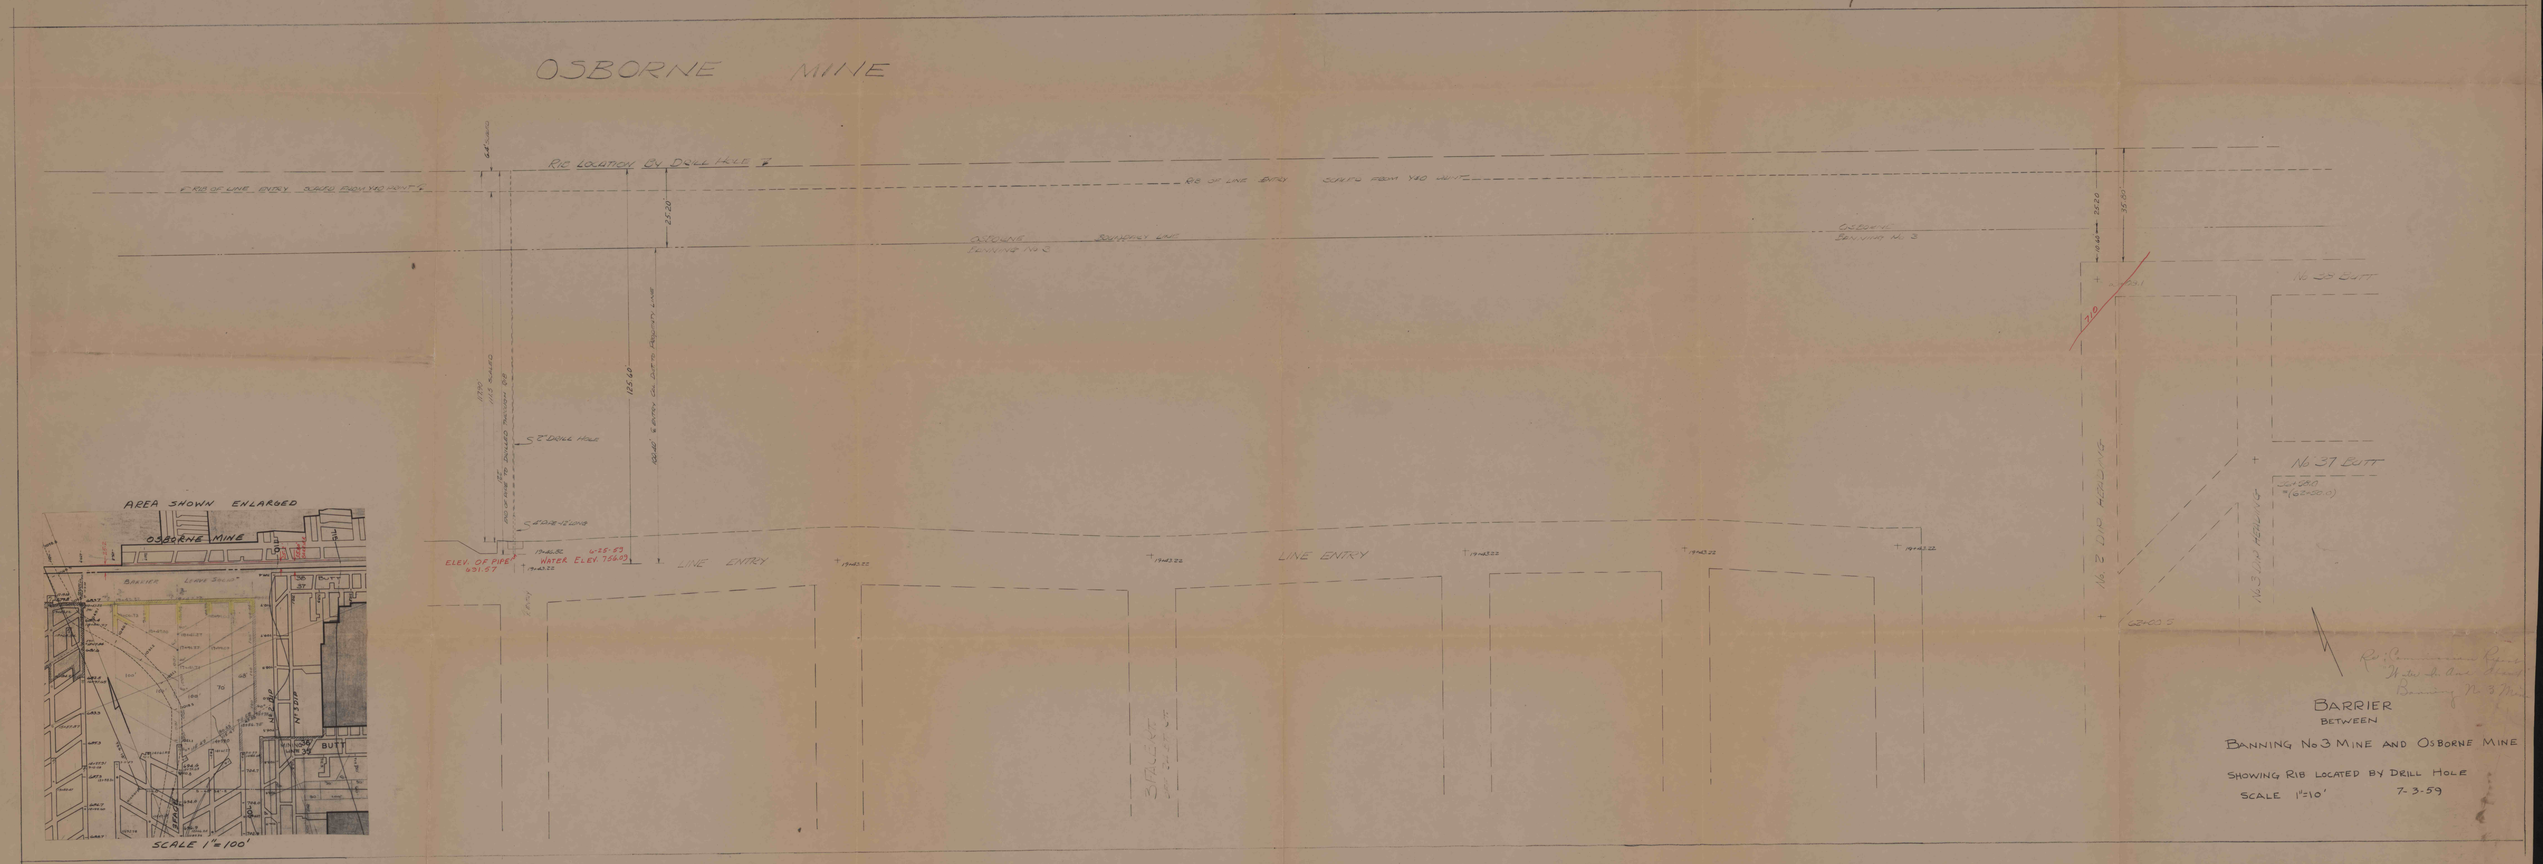
OSBORNE MINE
RIB LOCATION BY DRILL HOLE
RIB OF LINE ENTRY SCALED FROM Y&O POINT
OSBORNE BANNING No 3
OSBORNE BANNING No 3
No 38 BUTT
No 37 BUTT
No 2 DIP HEADING
No 3 DIP HEADING
LINE ENTRY
LINE ENTRY
ELEV. OF PIPE 631.57
WATER ELEV. 756.03
AREA SHOWN ENLARGED
OSBORNE MINE
BUTT
SCALE 1"=100'
BARRIER
BETWEEN
BANNING No 3 MINE AND OSBORNE MINE
SHOWING RIB LOCATED BY DRILL HOLE
SCALE 1"=10'
7-3-59