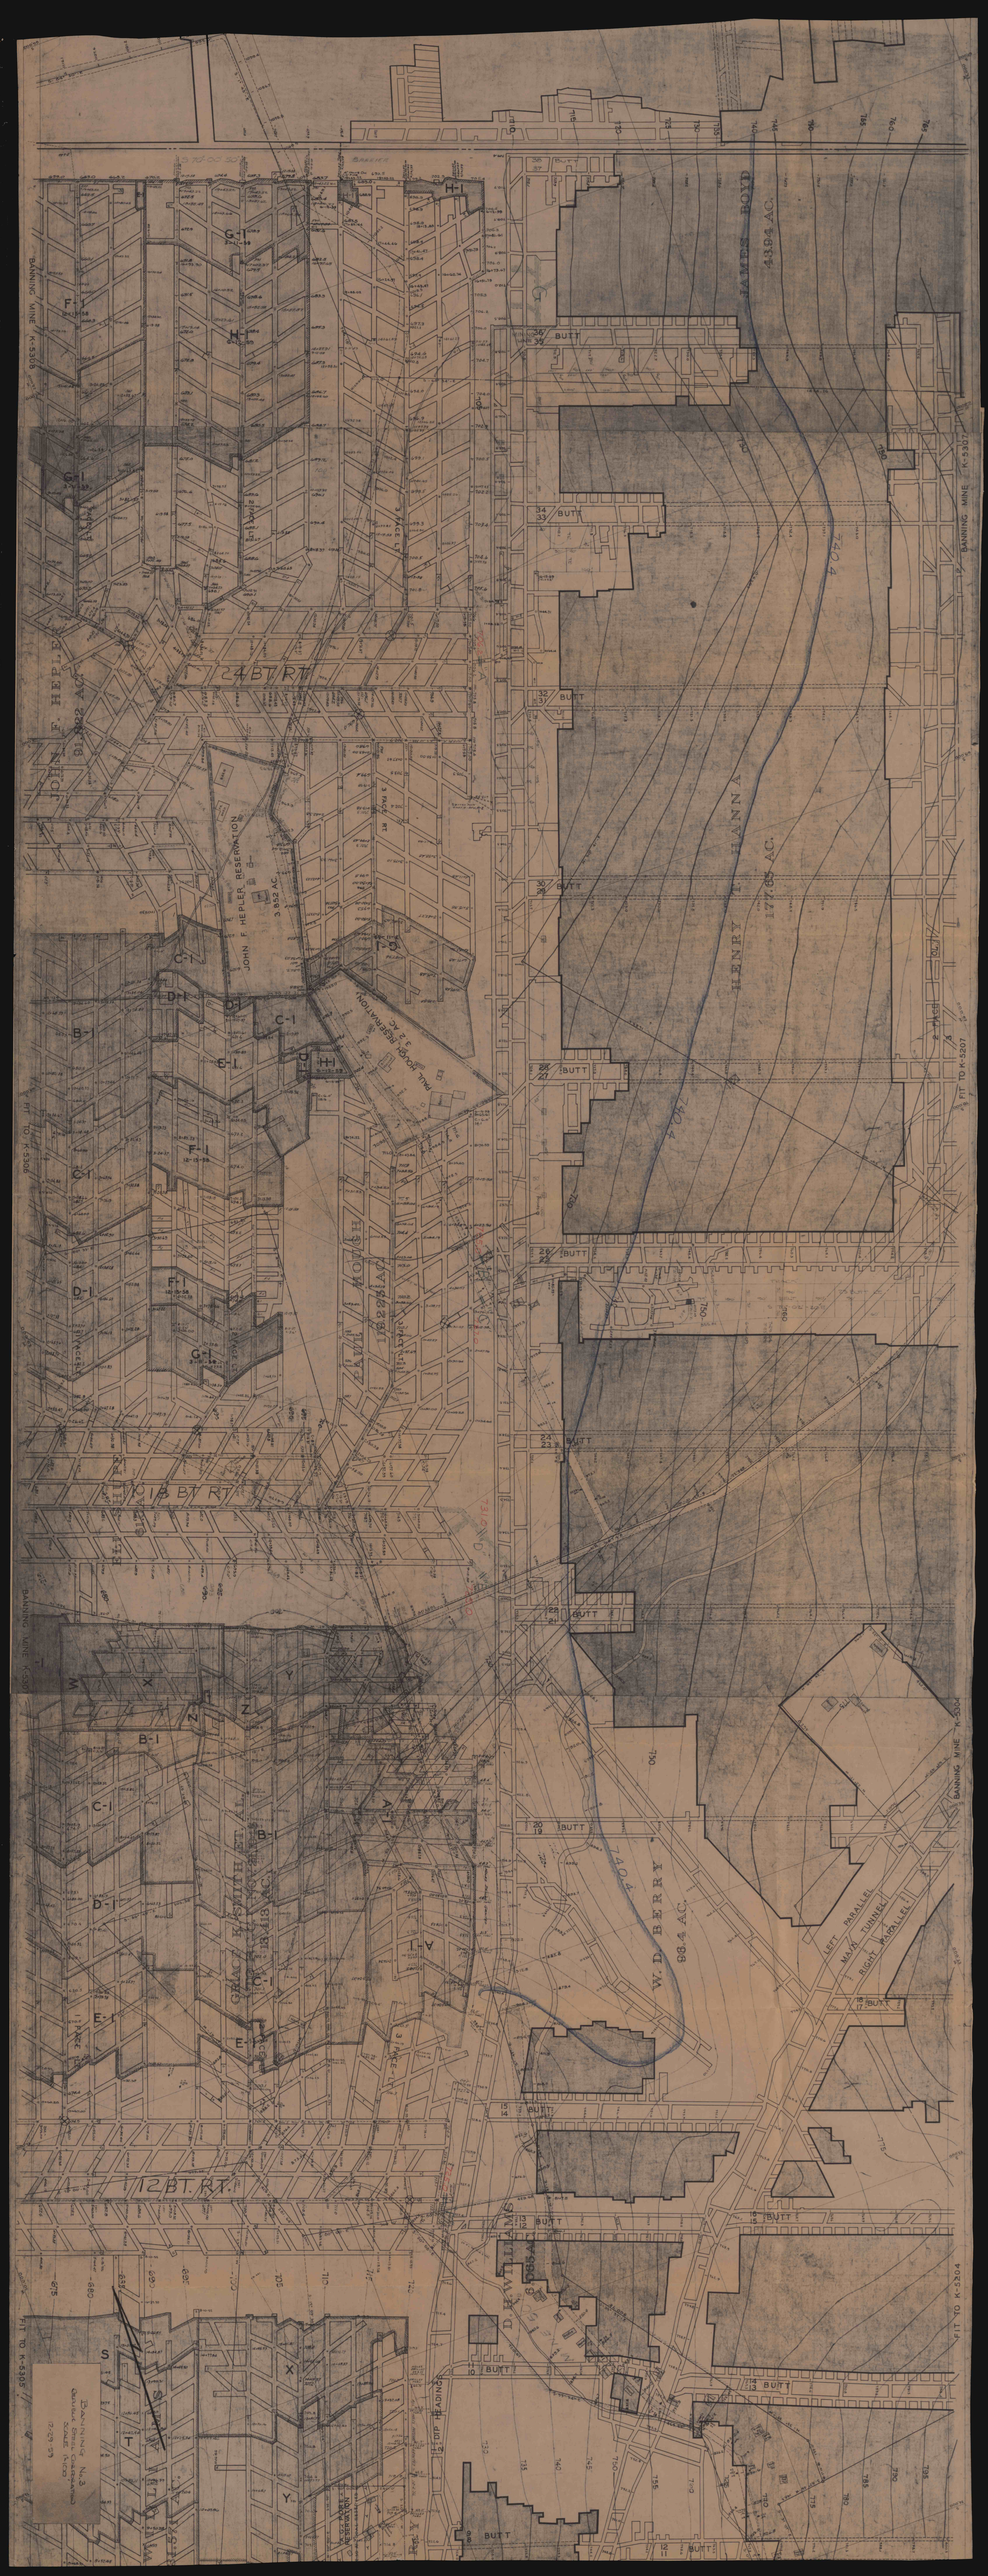
JAMES BOYD
43.94 AC.
HENRY J. HANNA
17.65 AC.
W. D. BERRY
98.4 AC.
JOHN F. HEPLER RESERVATION
3.852 AC.
24 BT. RT.
18 BT. RT.
12 BT. RT.
BANNING MINE K-5306
BANNING MINE K-5307
BANNING MINE K-5304
FIT TO K-5307
FIT TO K-5304
FIT TO K-5306
BUTT
LEFT PARALLEL
MAIN TUNNEL
RIGHT PARALLEL