

PLANING MINNE K 5300

FIT TO K 5301

MINED OUT

MINED OUT

MINED OUT


MINED OUT

MINED OUT

YOUGHIOGHENY

RIVER

BALTIMORE AND OHIO RAILROAD

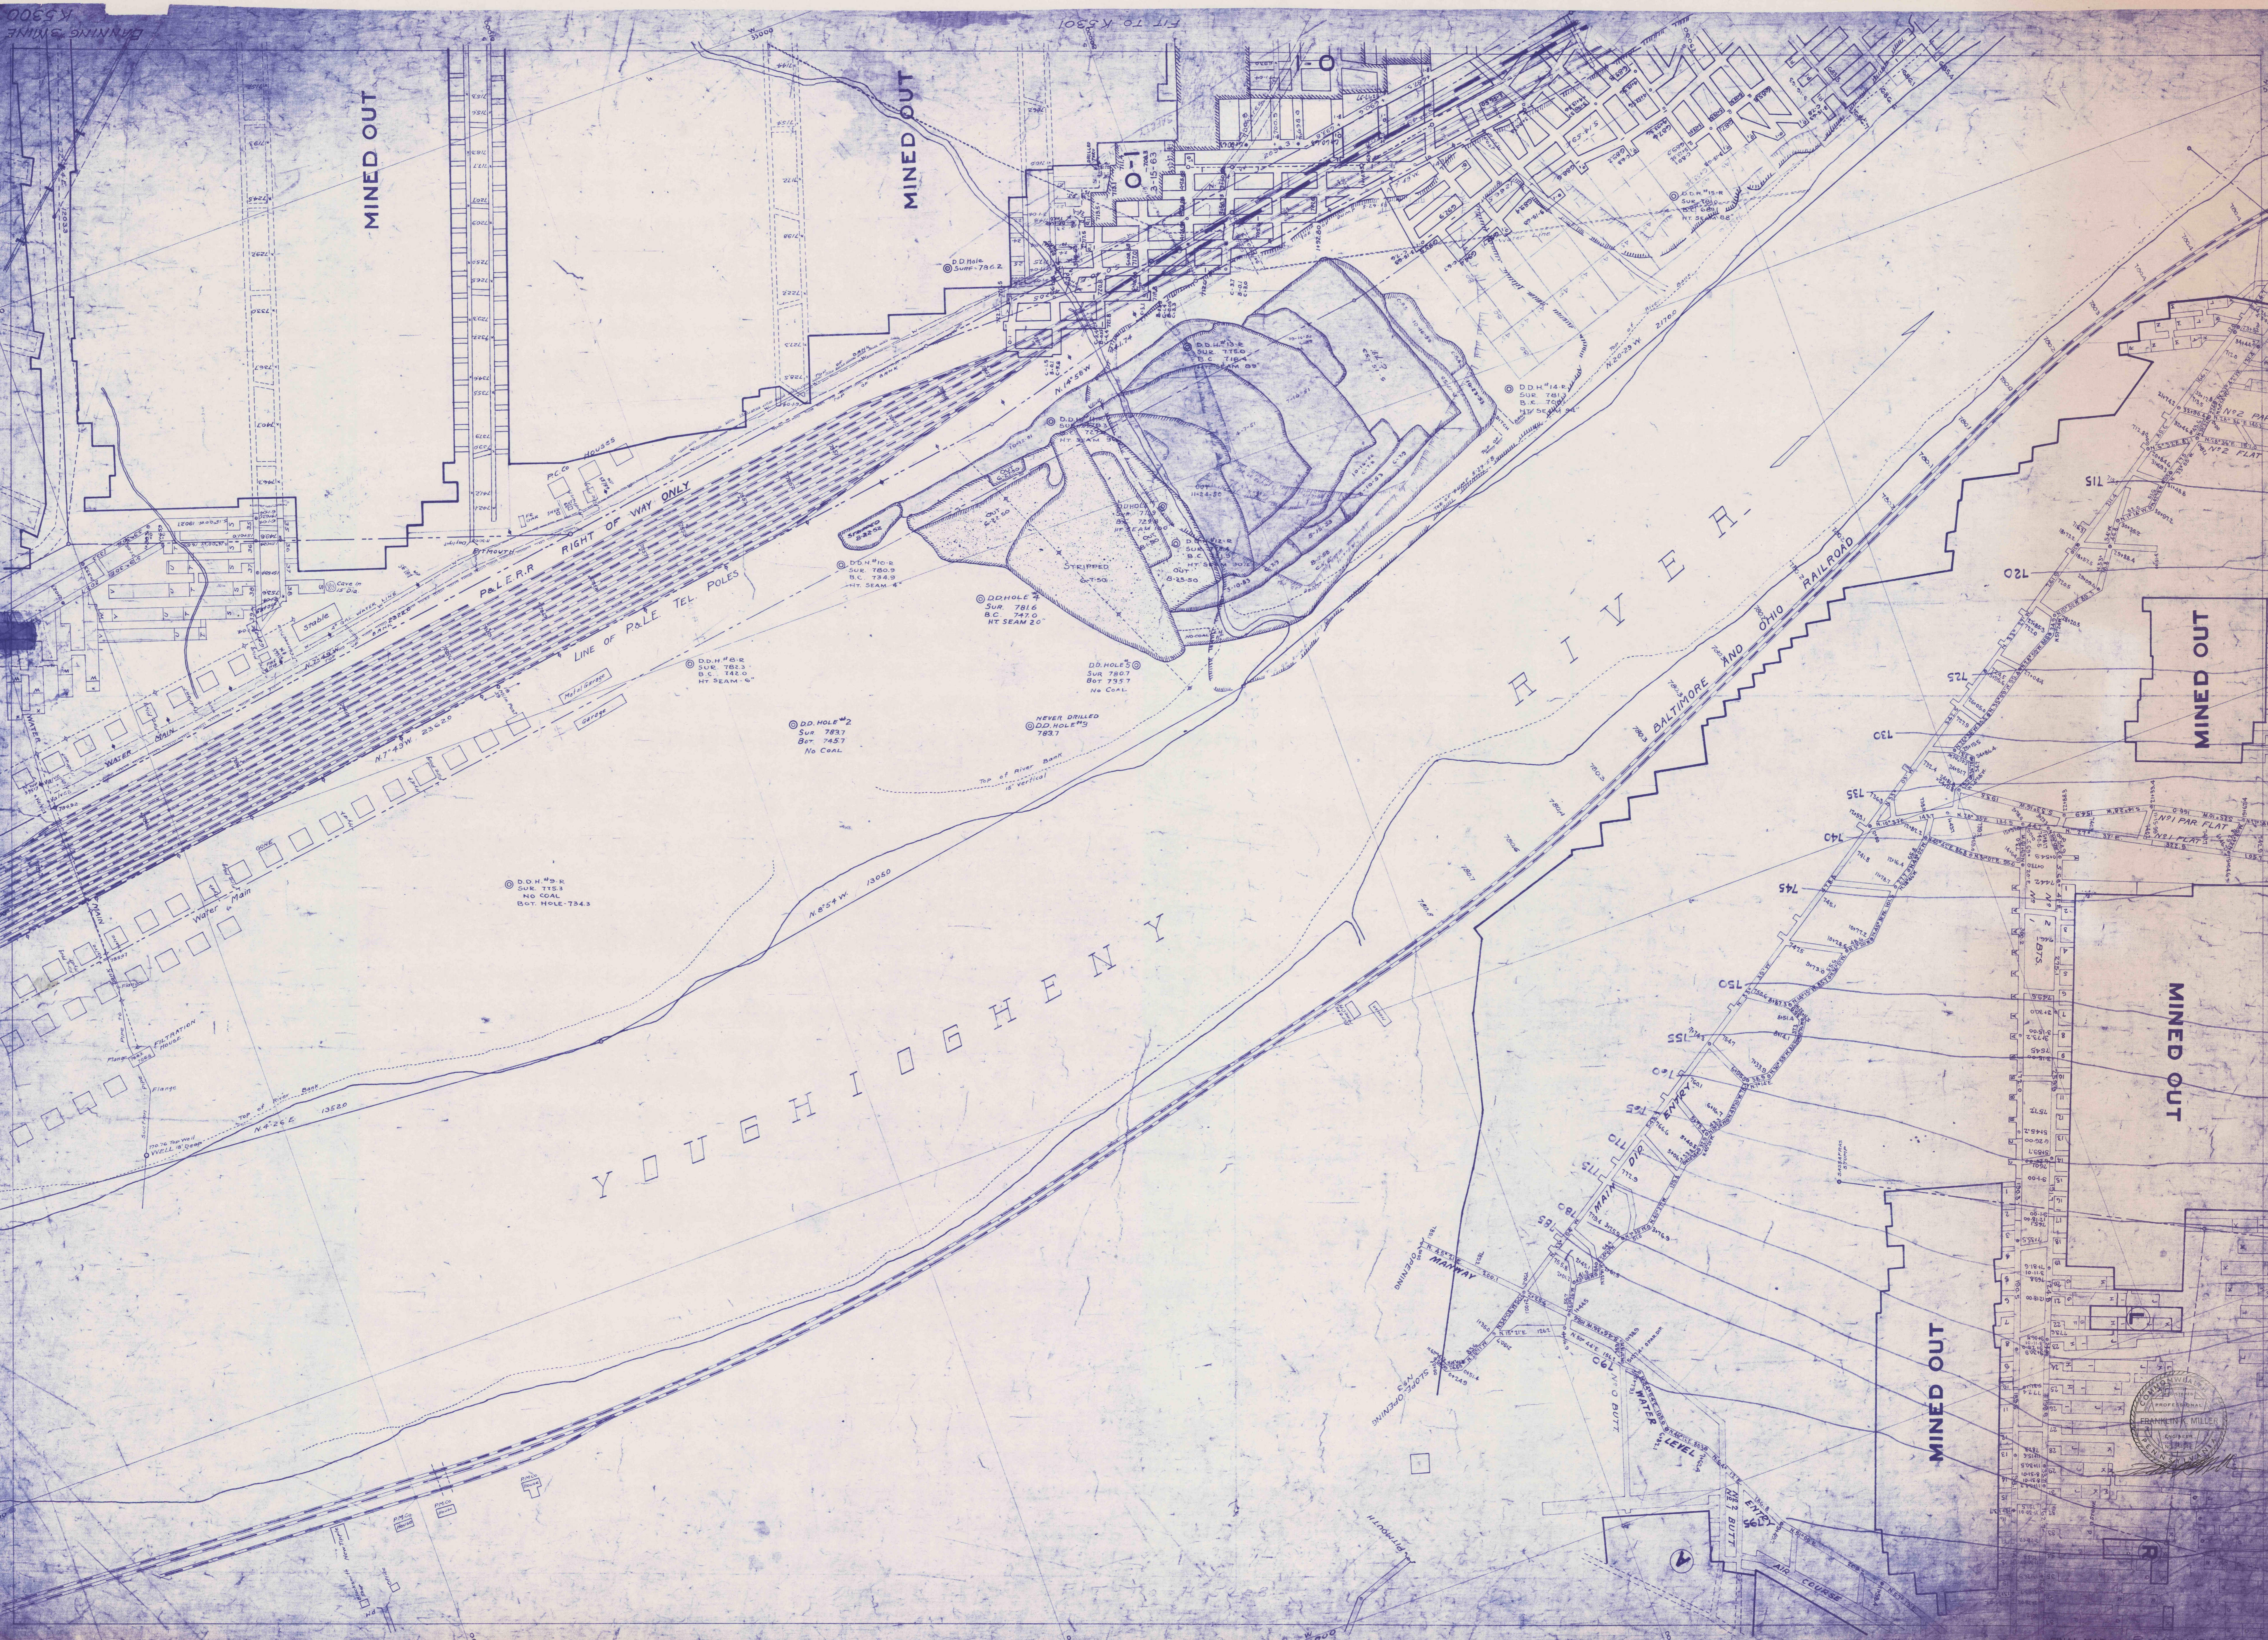

FIT TO K-5303

