

D. P. LUCE TRACT
23.42 AC
Surface purchased 8-24-22

MINED OUT

MINED OUT

MINED OUT

MINED OUT

F. V. LARIMER.

182.5 ACRES. COAL.

M. G. FLORO
MINED OUT

54.632 AC.
LESS 0.375 " P.R.W. VARY.
54.257 " NET
P.C. CO. SURF. 7-13-37


MINED OUT

MINED OUT

BANNING #1

K5244	K5247	K5248
K5245	K5246	K5249
K5254	K5286	K5287
K5256	K5285	K5288
K5297	K5298	K5301
K5296	K5299	K5300

LEASED BY LOREN RUSSETT
P.C. CO. FOR A PERIOD OF 20 YRS
CROP LEASE DATED 9-24-37
0.927 AC.

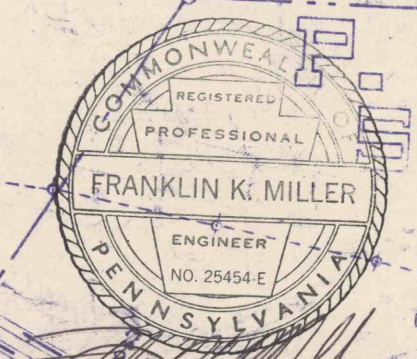

P. C. CO. SURFACE
L. M. LARIMER
S. 181A