


JOHN J. THOMPSON & ABNER McCLAIN  
270.74 AC. COAL

FIT TO K 5290

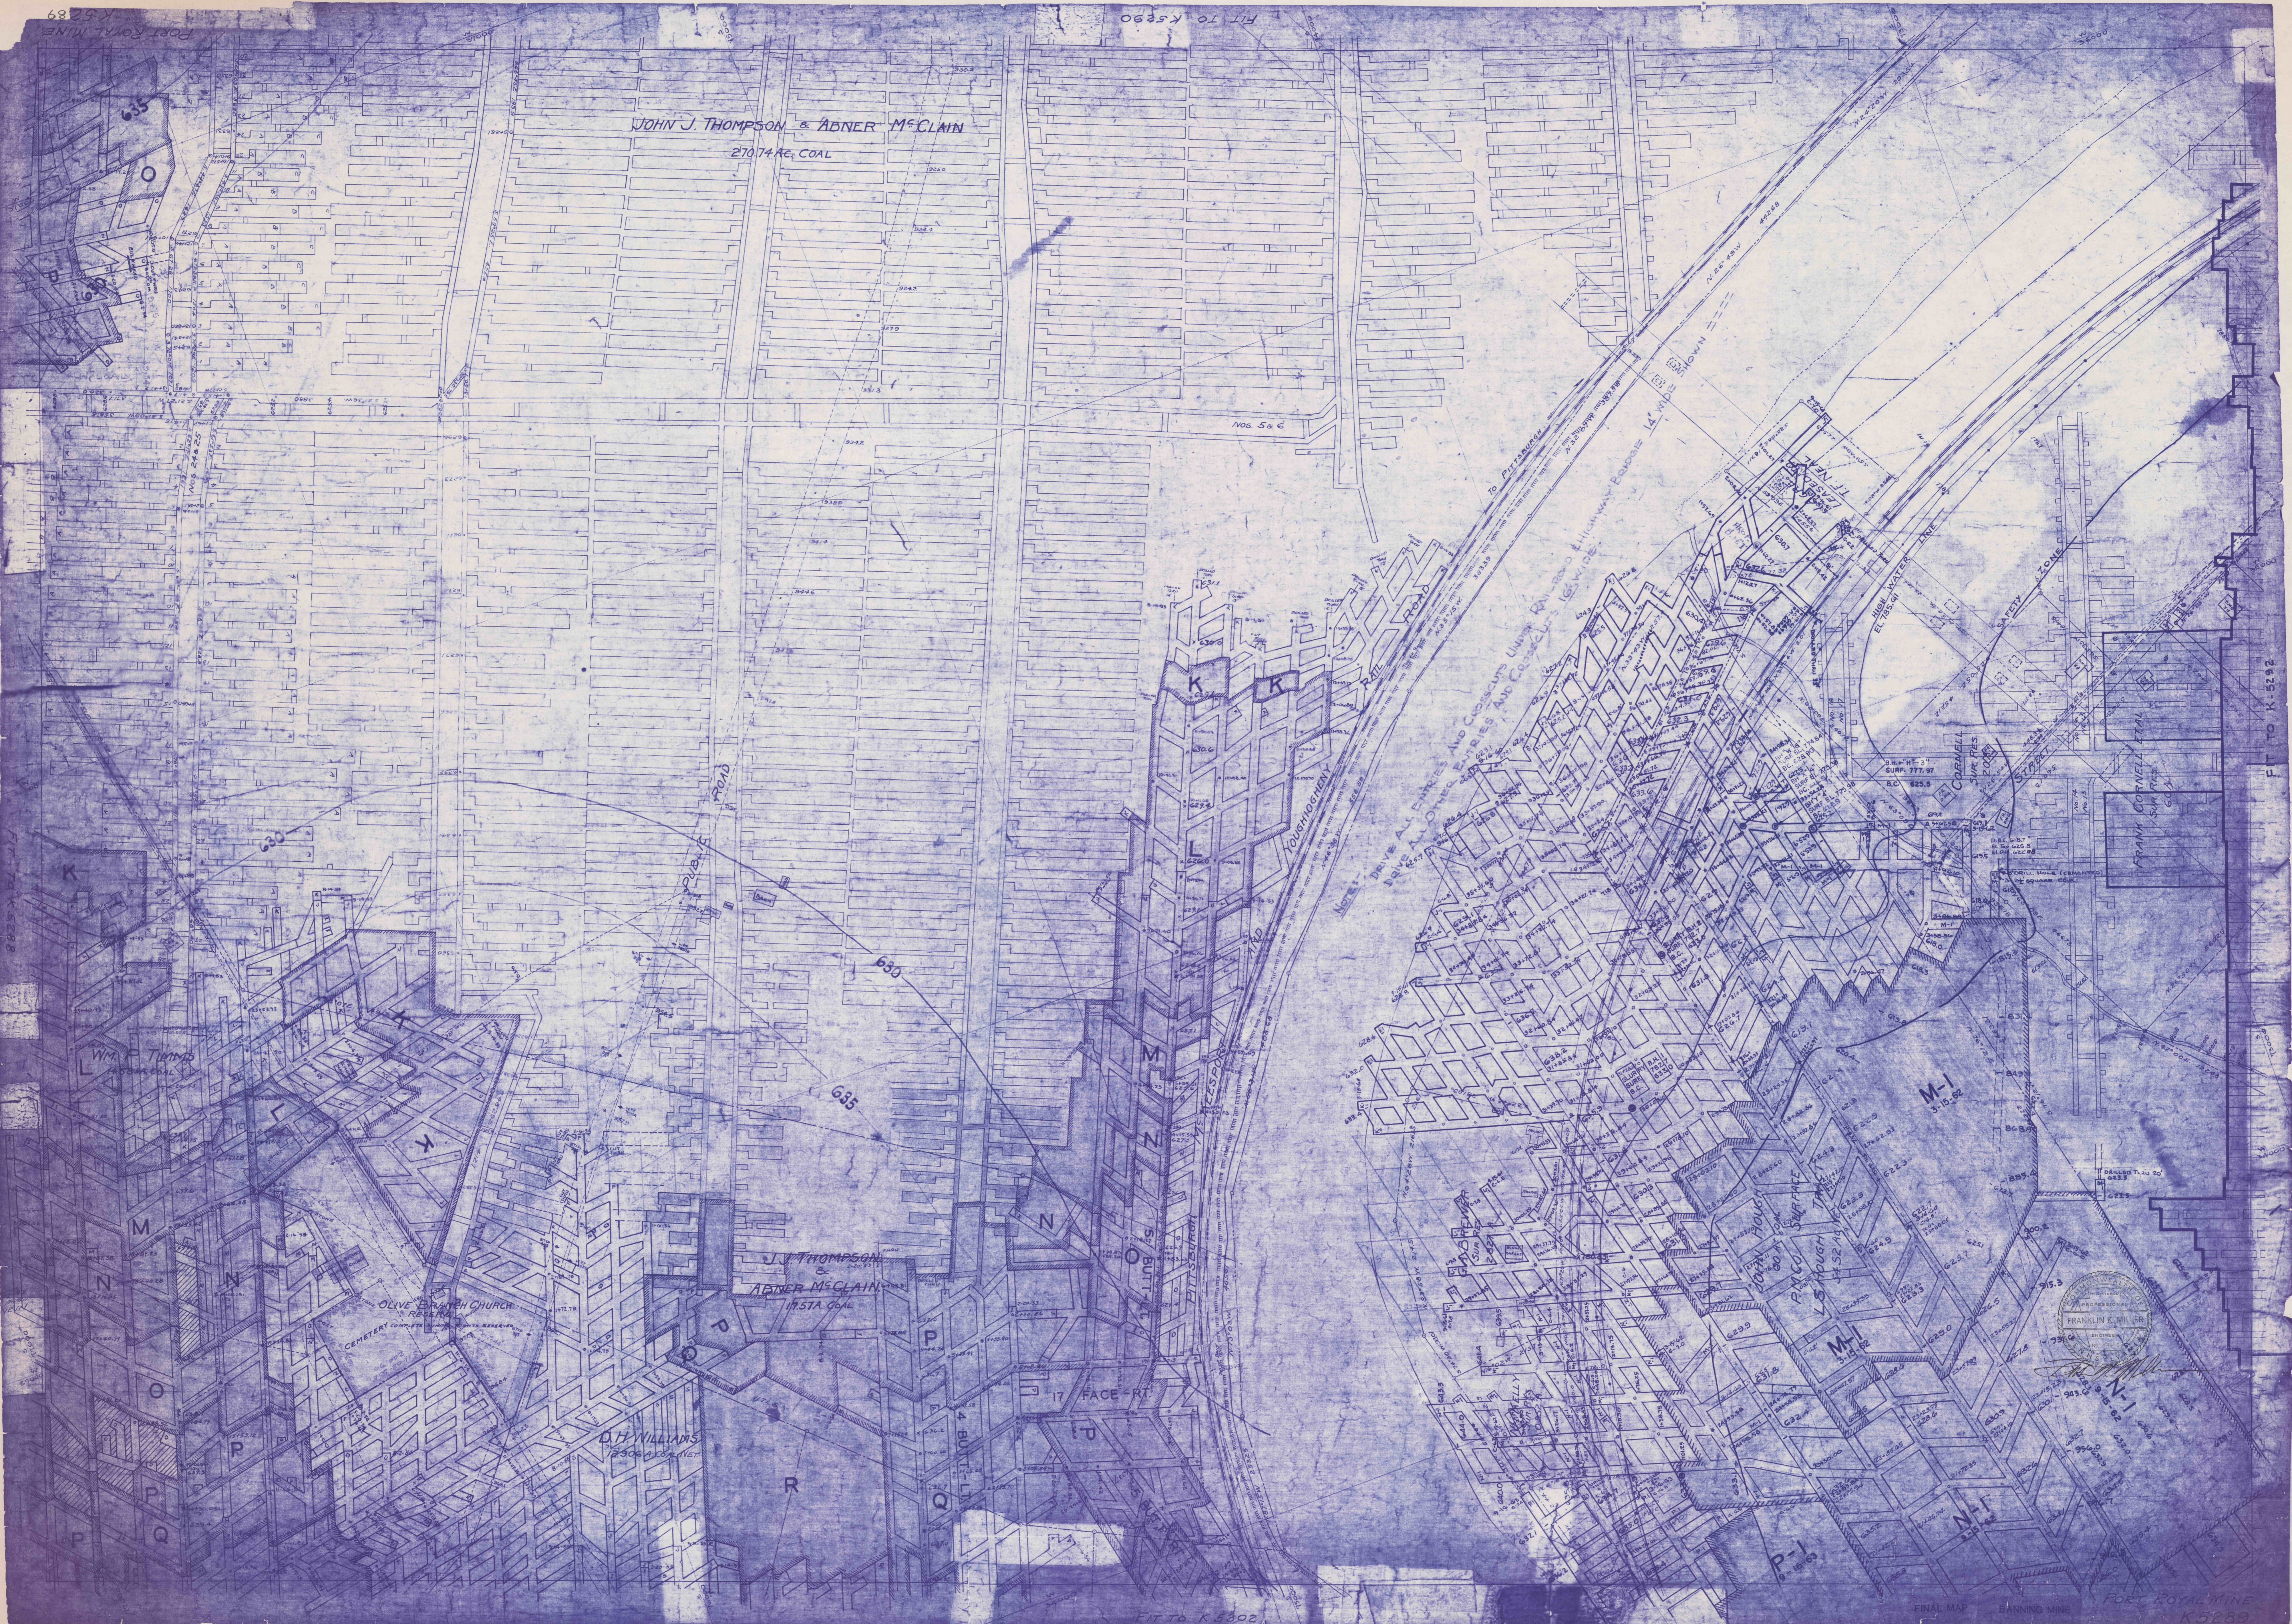

FIT TO K 5302

FINAL MAP BANNING MINE

Fort Royal Mine  
K 5289