


FIT TO K-5277

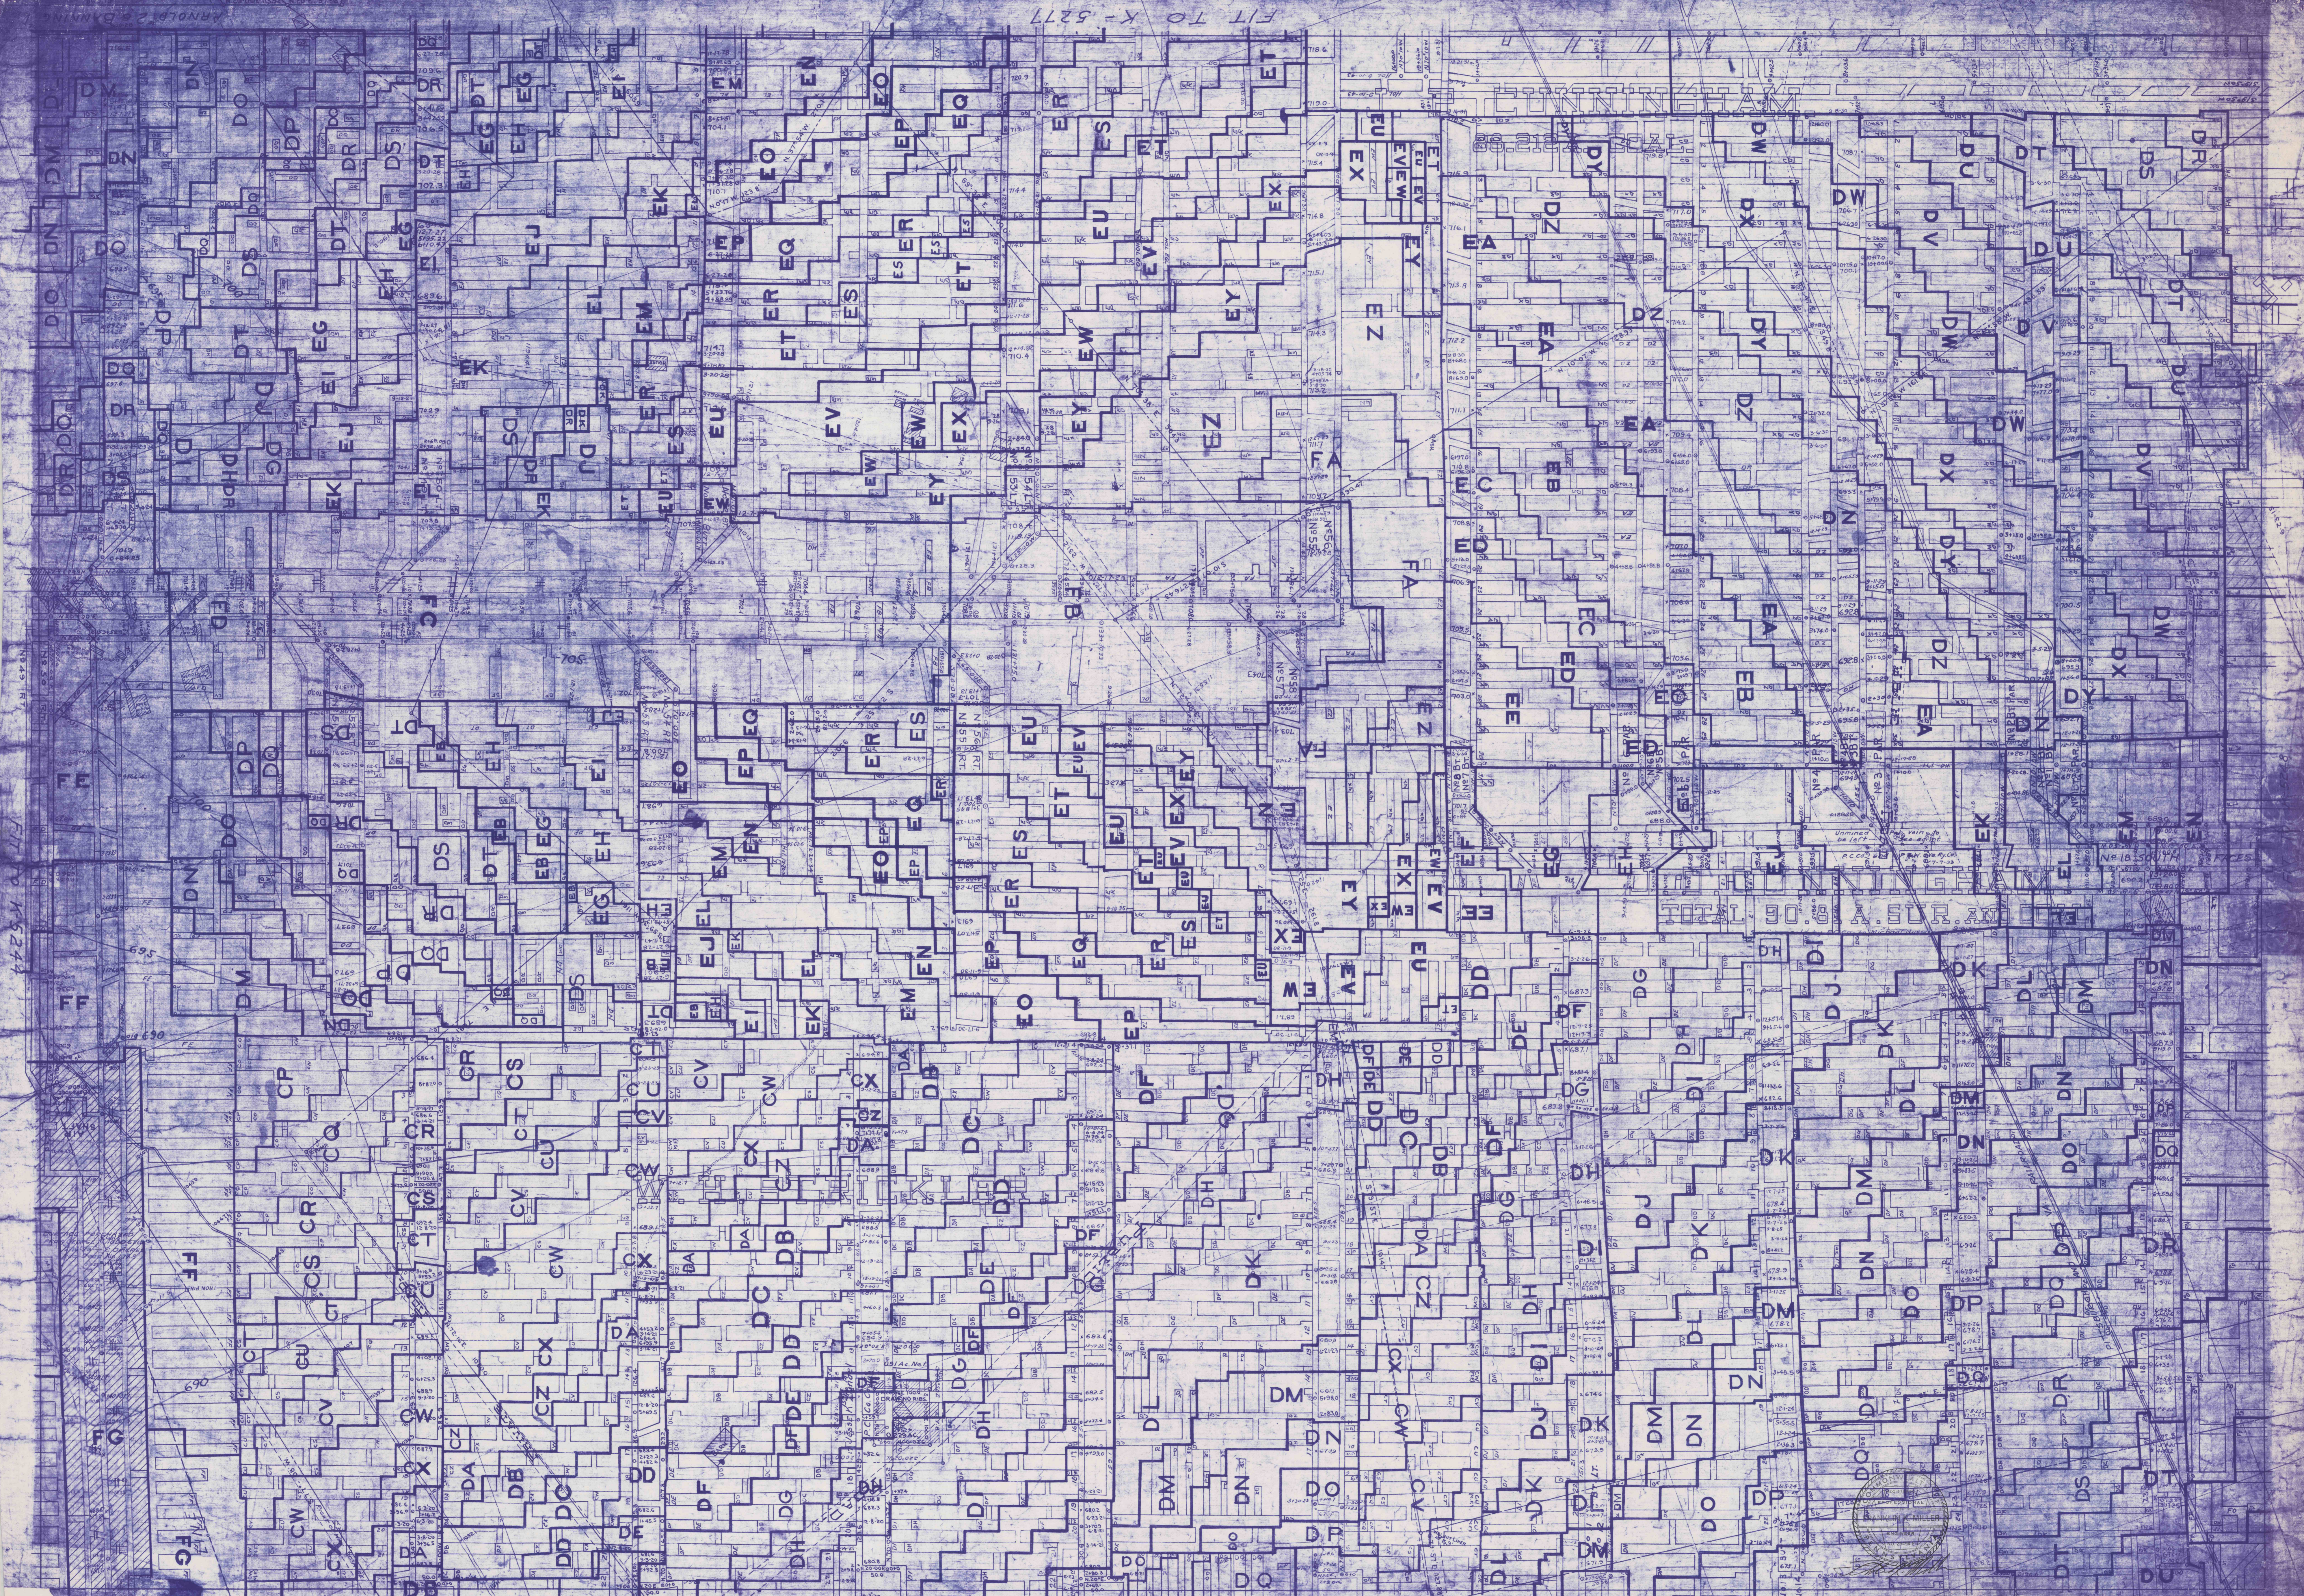

FIT TO K-5246