


BOUNDARY LINE  
EXCHANGE LINE  
5925-Y 01 LT  

ARNOLD 2 MINE  
FIT TO K-5247  
FIT TO K-5245  
FIT TO K-5243  
ARNOLD 2 MINE  
FIT TO K-5244

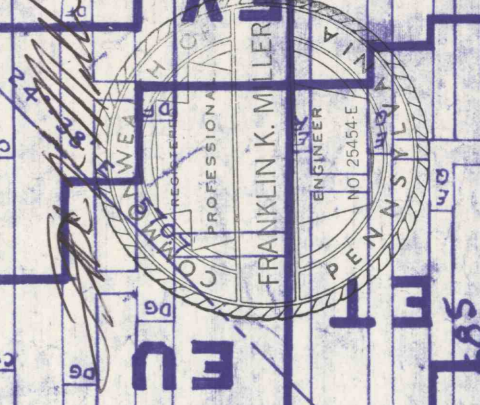

MINED OUT  
MINED OUT  
MINED OUT

MINED OUT