


EQUITABLE MINE K-5345

FIT TO K-5345

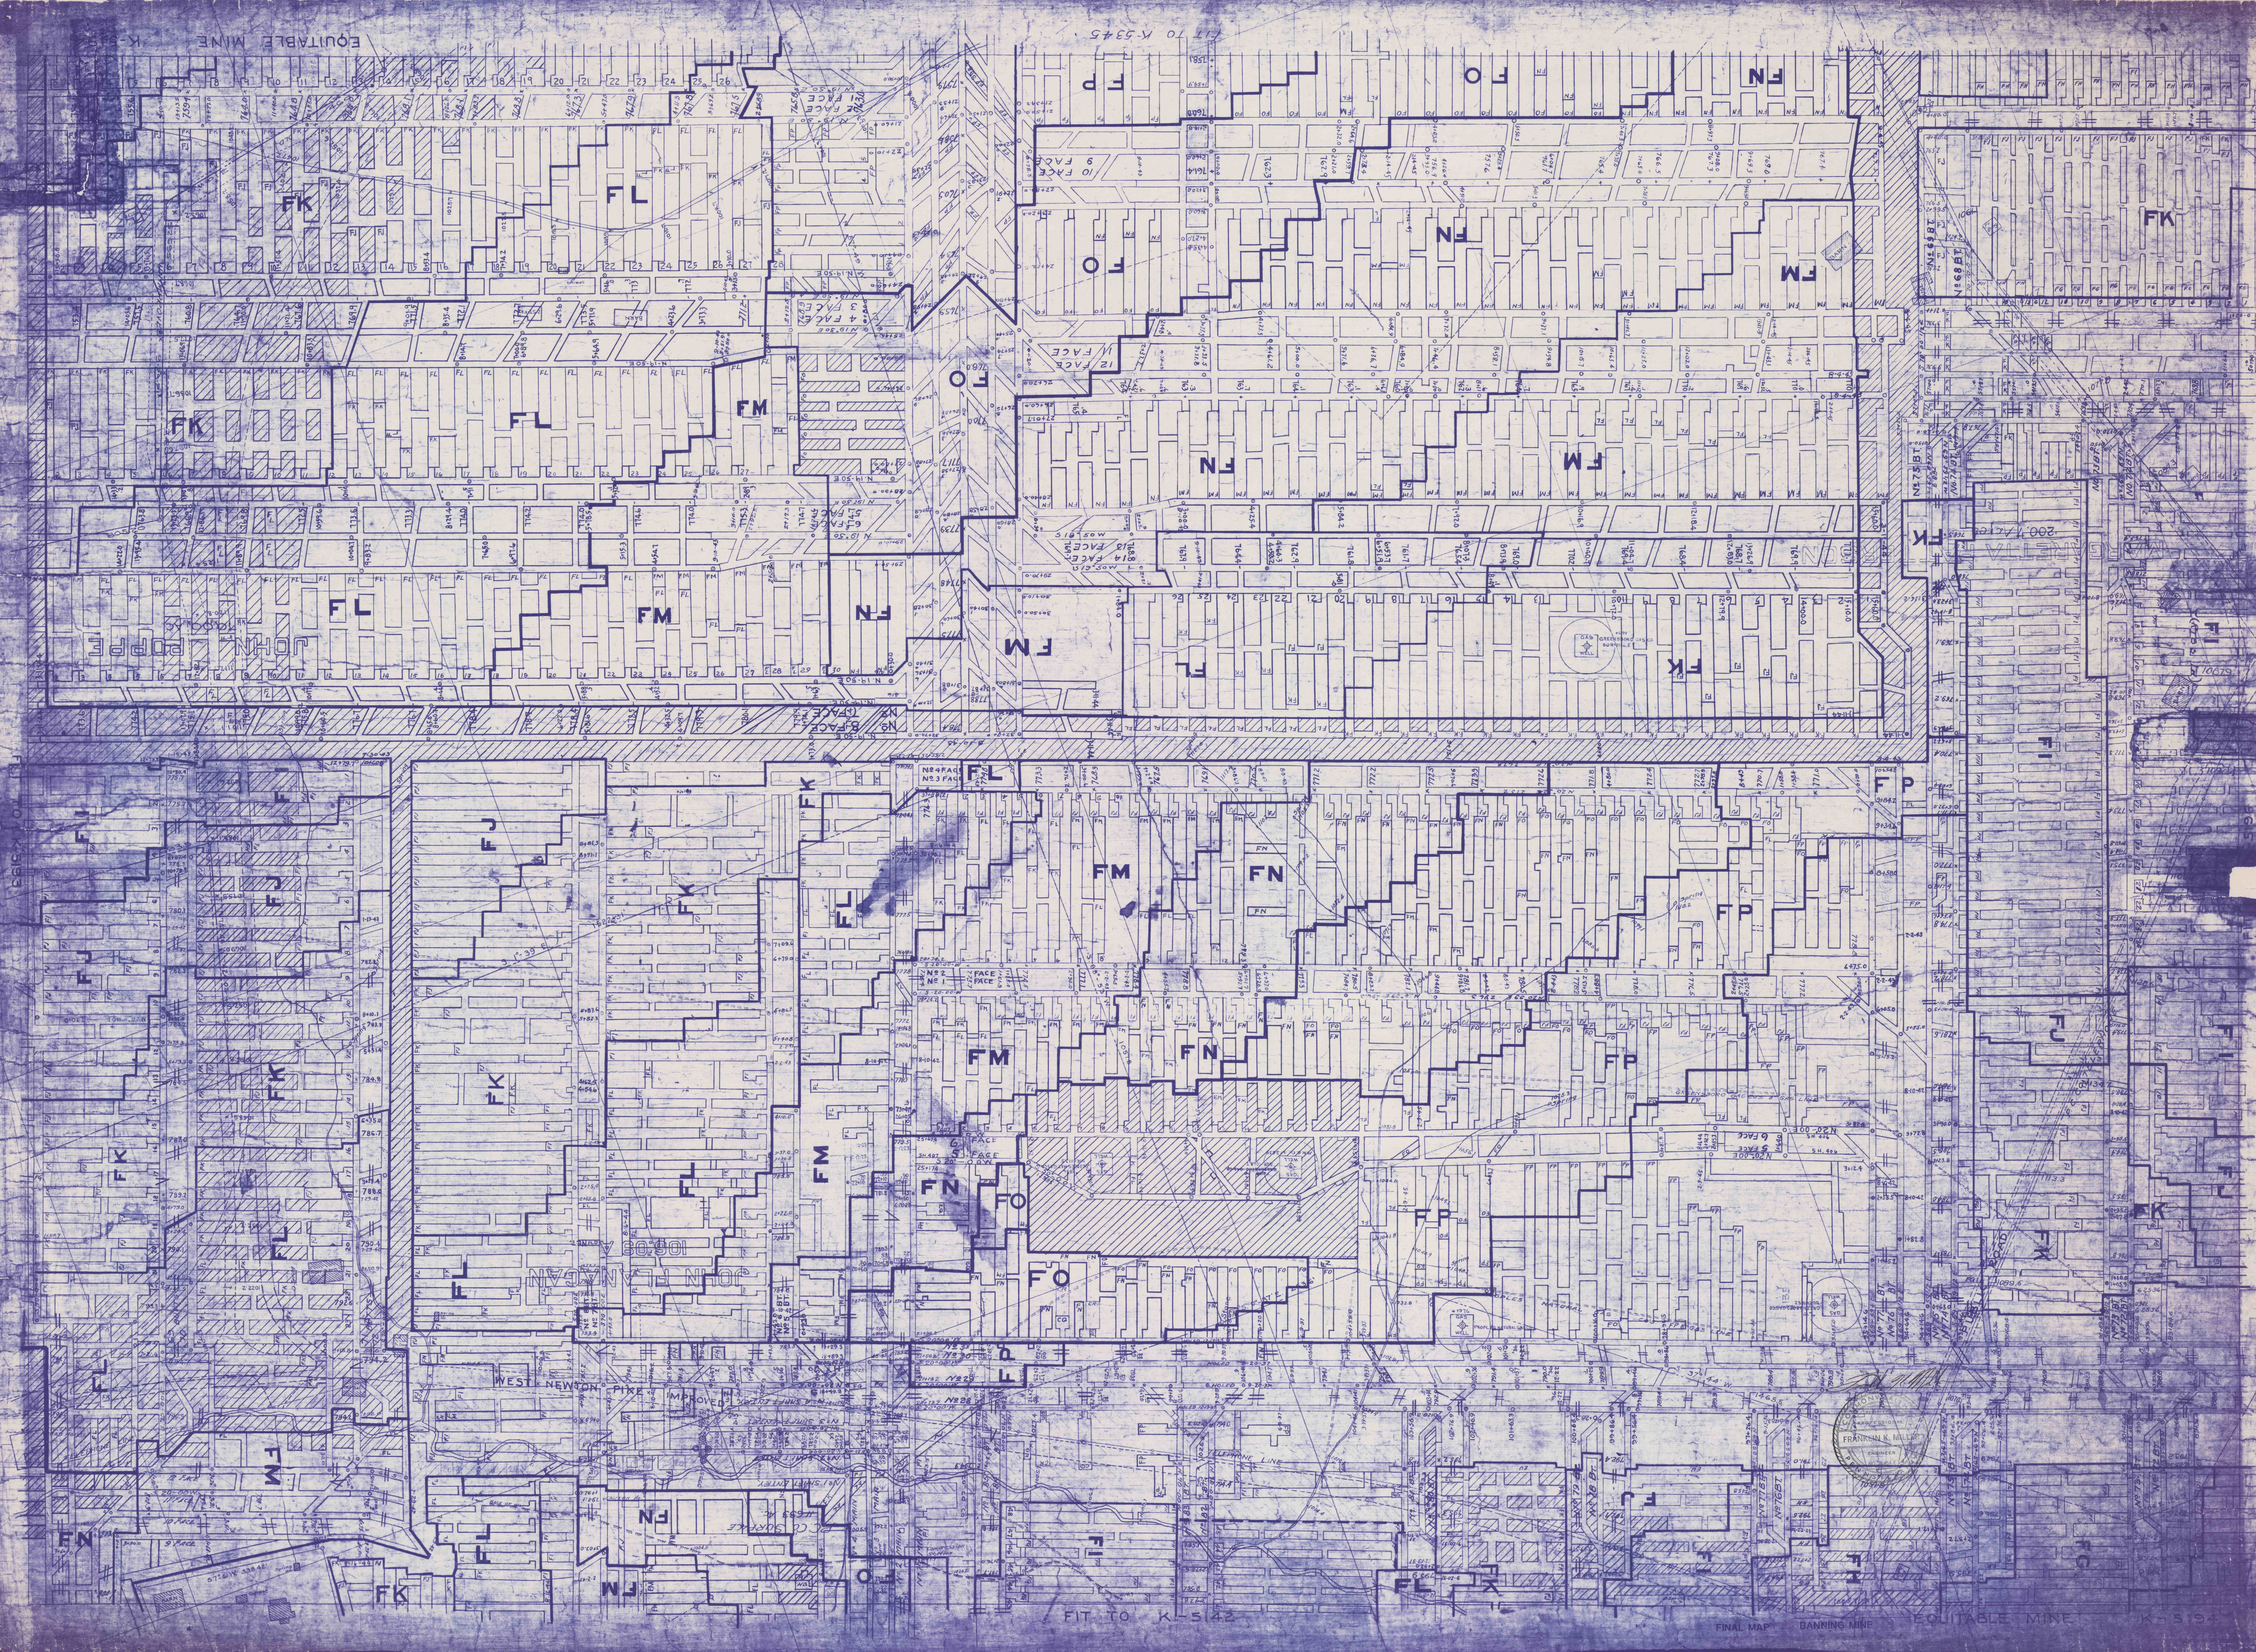

FIT TO K-5345

FINAL MAP BANKING MINE EQUITABLE MINE K-5345