

BANNING MINE K-5167

FIT TO K-5160

AMERICAN TIN PLATE CO.  
9.99 AC.

LATTIMORE TRACT  
68.67 AC.

H. GRESSLEY  
3.6 AC.


D. B. GREENWALT  
137.52 AC.

RESERVE  
2.144 AC.

HY GRESSLEY  
14.4 AC.

FIT TO K-5364

FIT TO K-5166

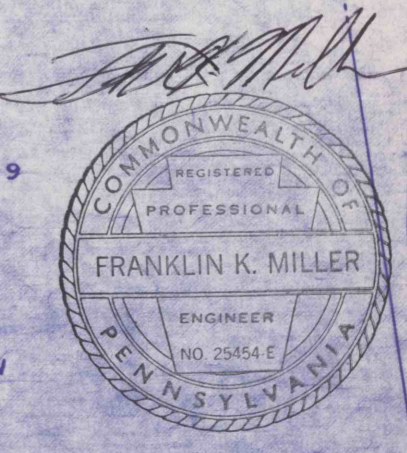

FIT TO K-5168

FINAL MAP

BANNING MINE

K-5167