


FT 10 N-515

SCHOOL LOT
RES 0.8 AC

CARRIE MOORE

WM. COR. HRS
63.05 AC

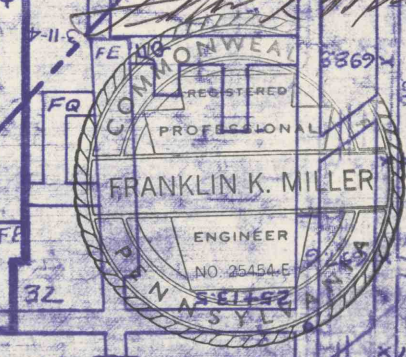

FT 10 N-515

FINAL MAP BANNING MINE WEST NEWTON