


BANNING MINE K-5462

FIT TO K-5462

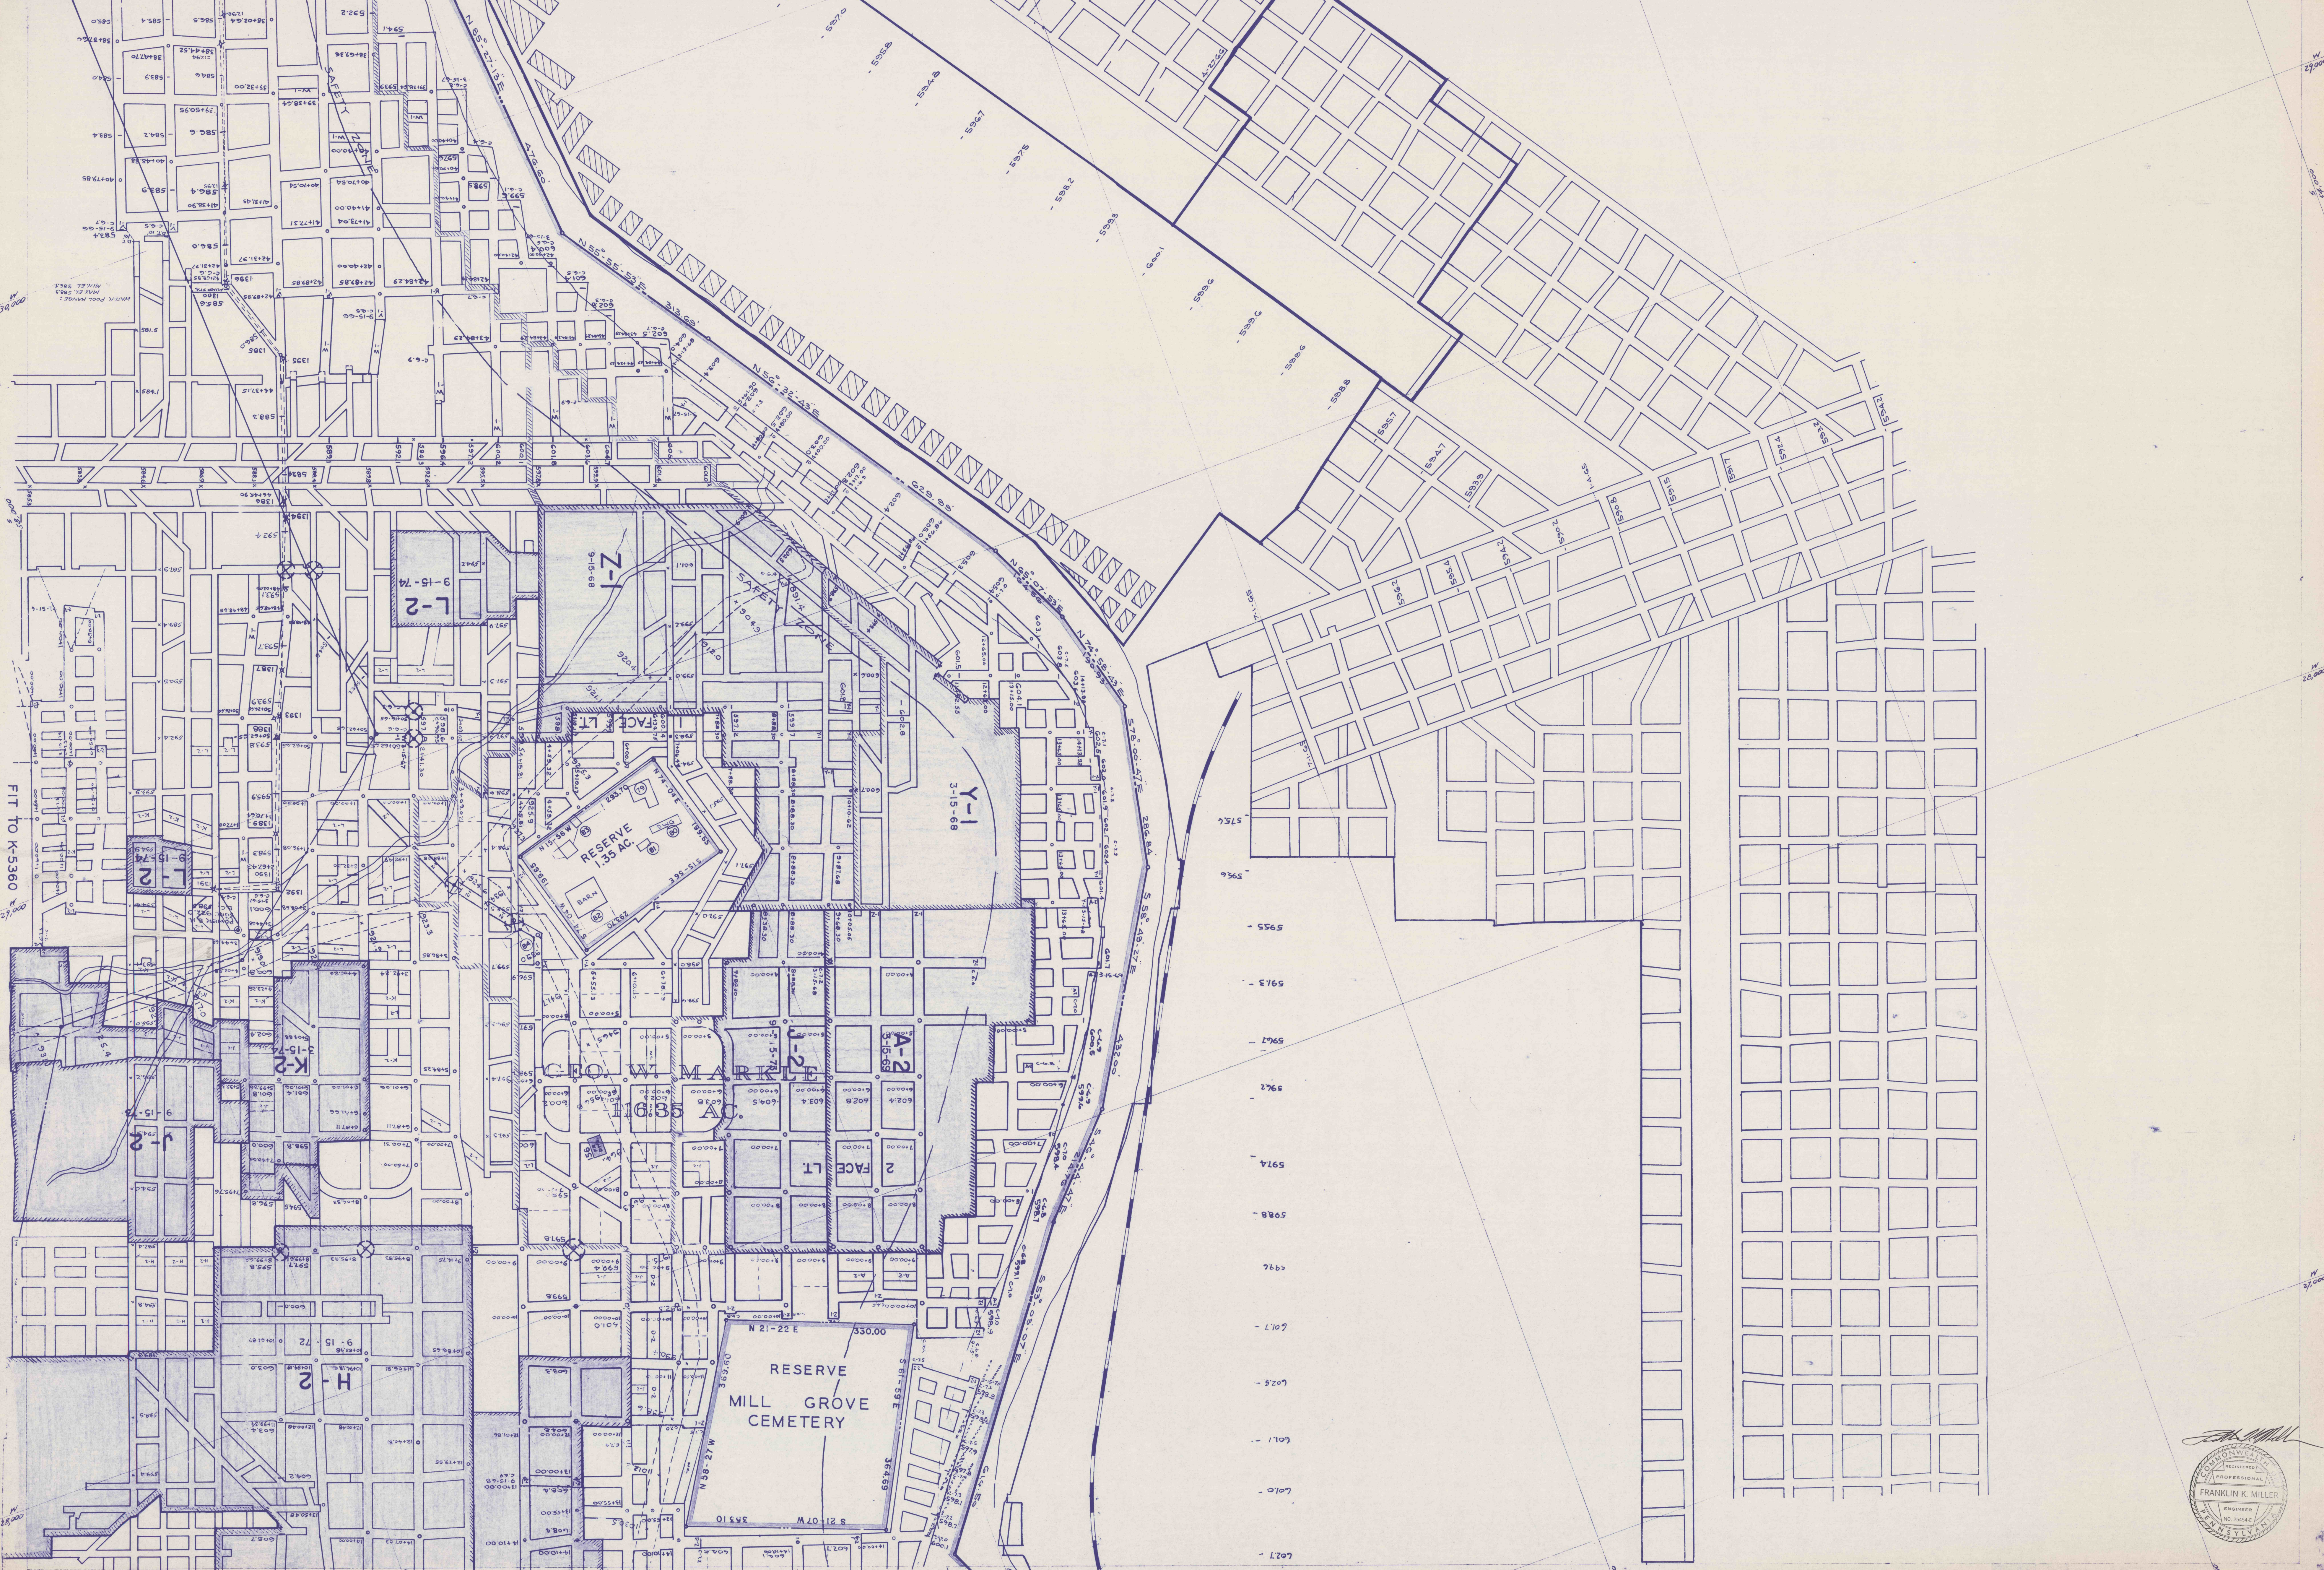

FIT TO K-5360

FIT TO K-5410

