


Fit to K-5345

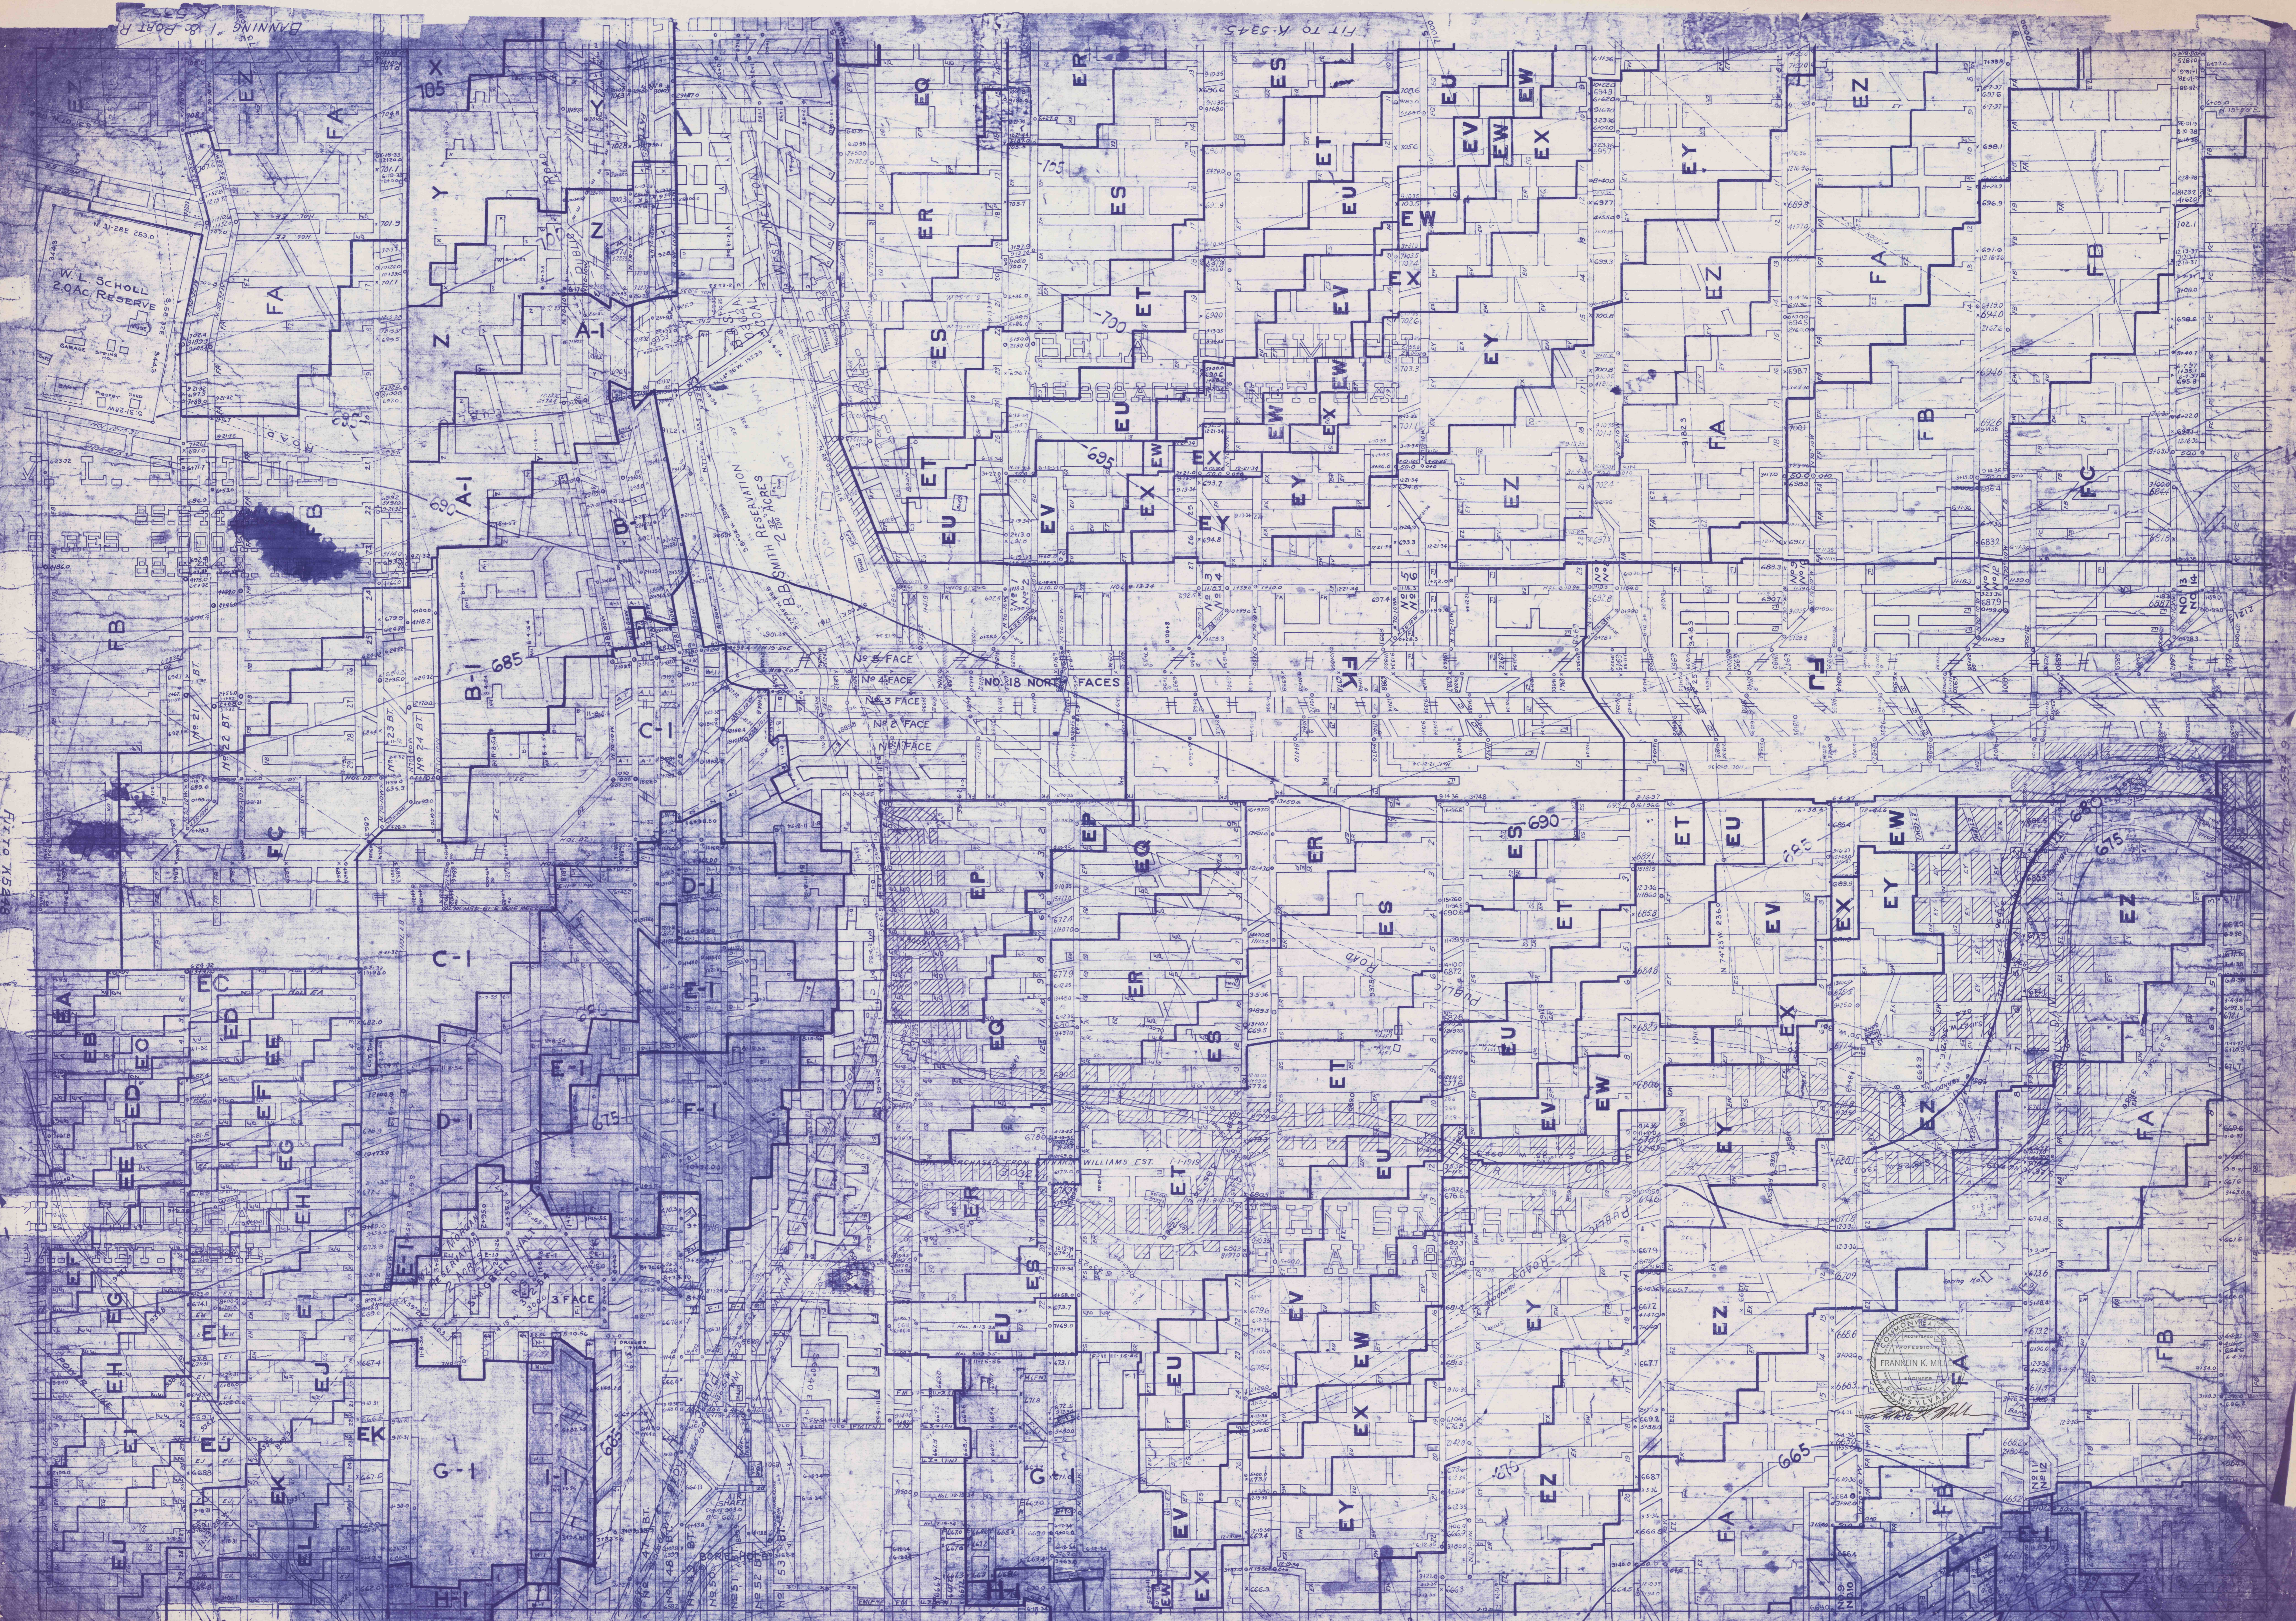

Fit to K-5351

FINAL MAP BANNING MINE BANNING 11 & PORT ROYAL MINES