



Fit to N-5282

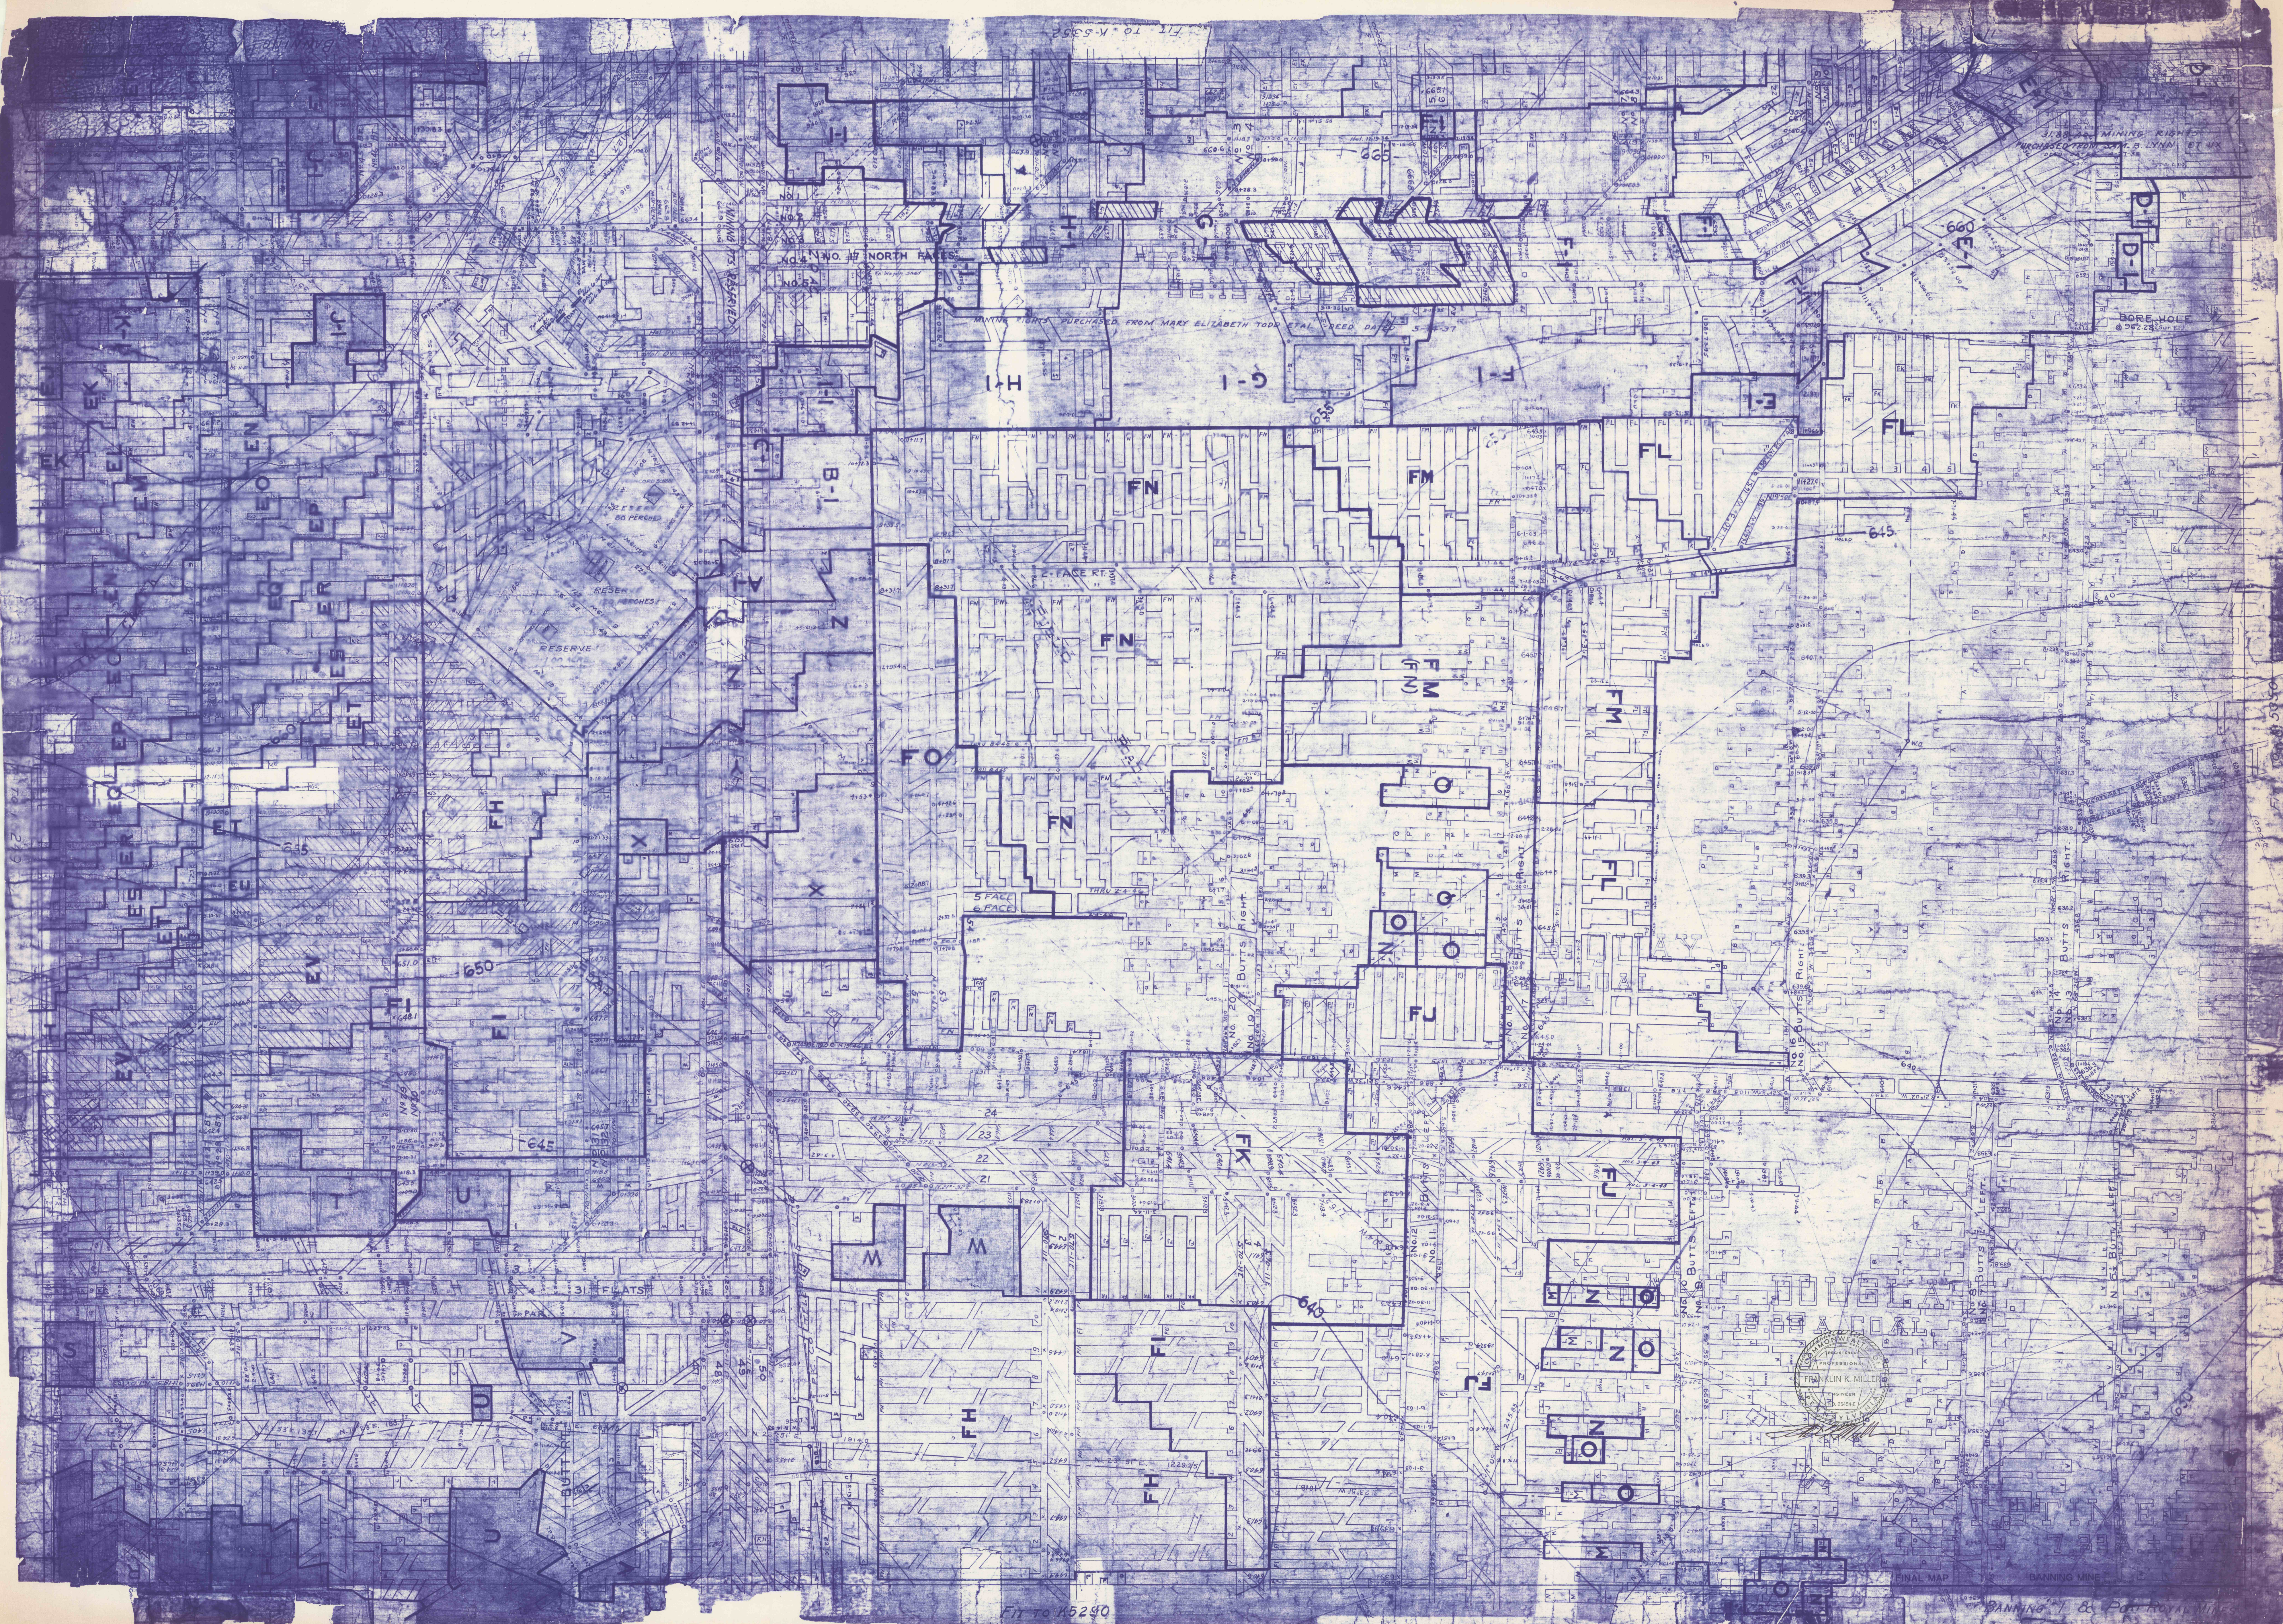

Fit to N5290

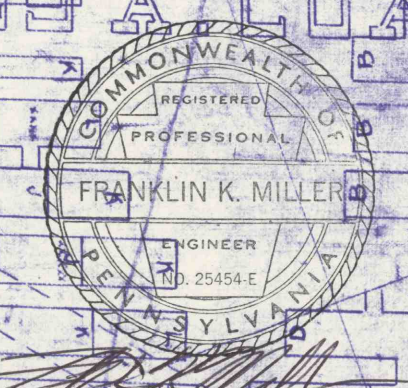

FINAL MAP
 BANNING LINE
 BANNING & PATRICK