


SHORE 215 AC

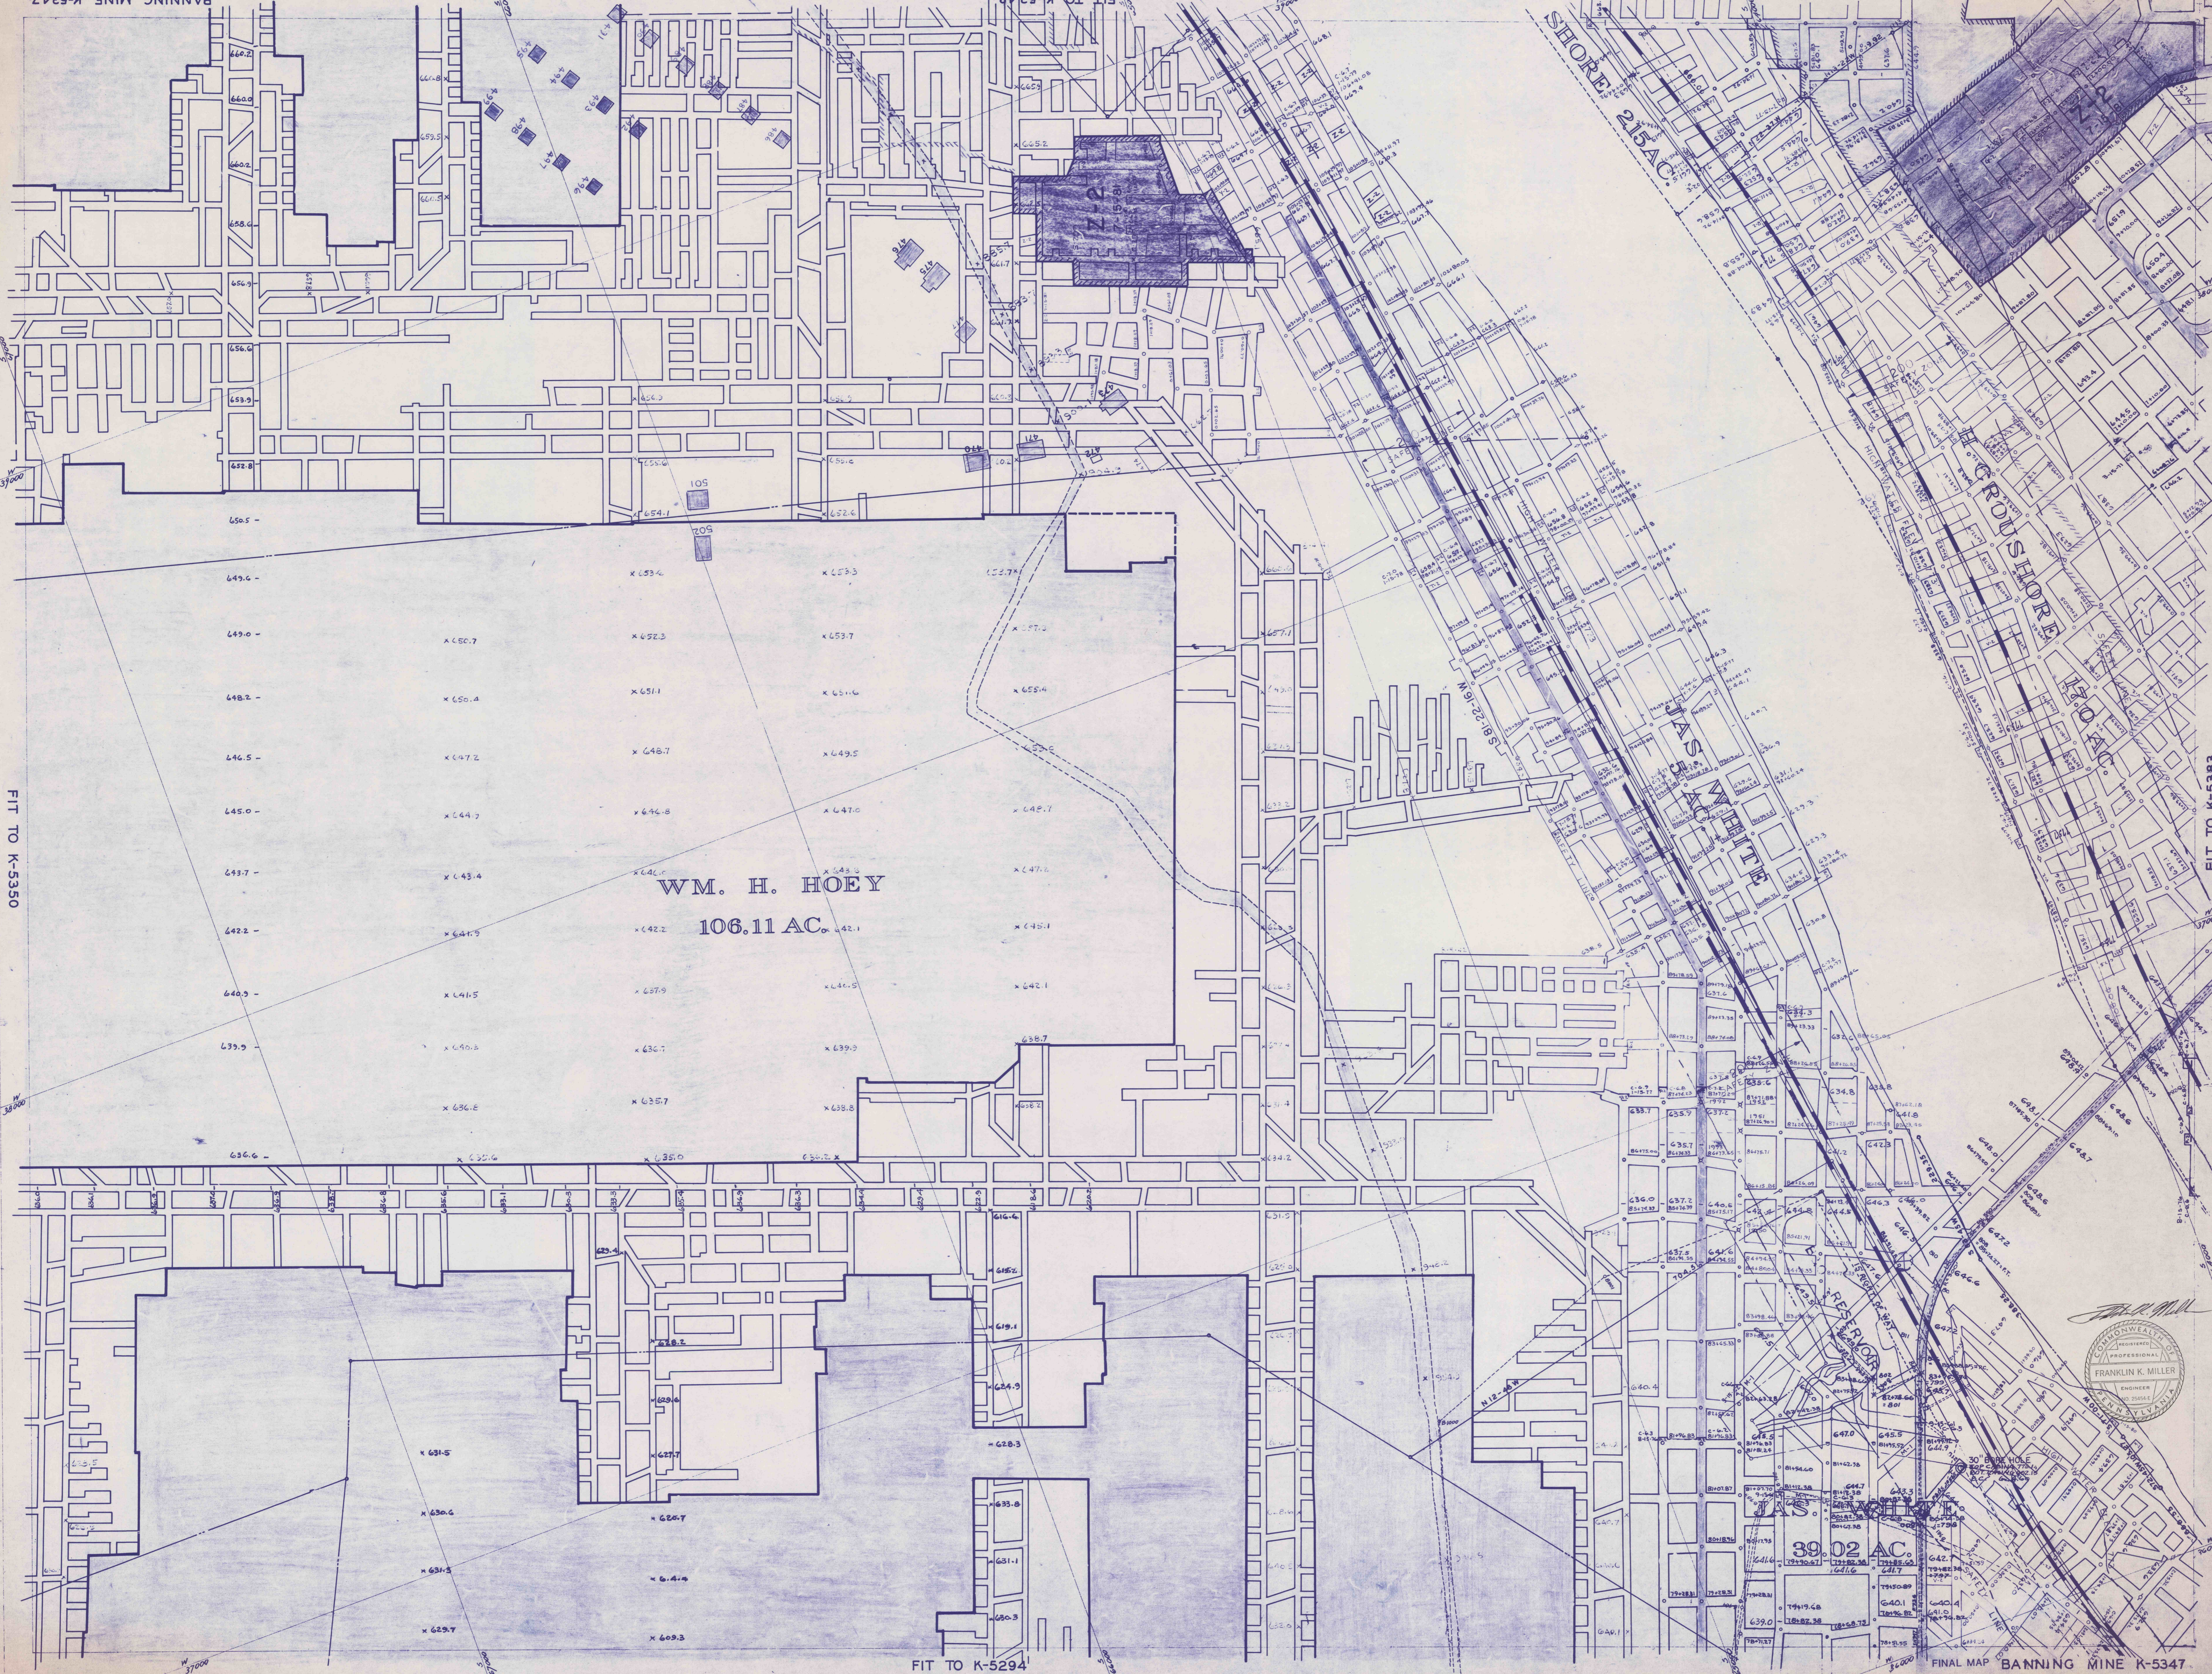

FIT TO K-5350

FIT TO K-5383

WM. H. HOEY
106.11 AC

39.02 AC

