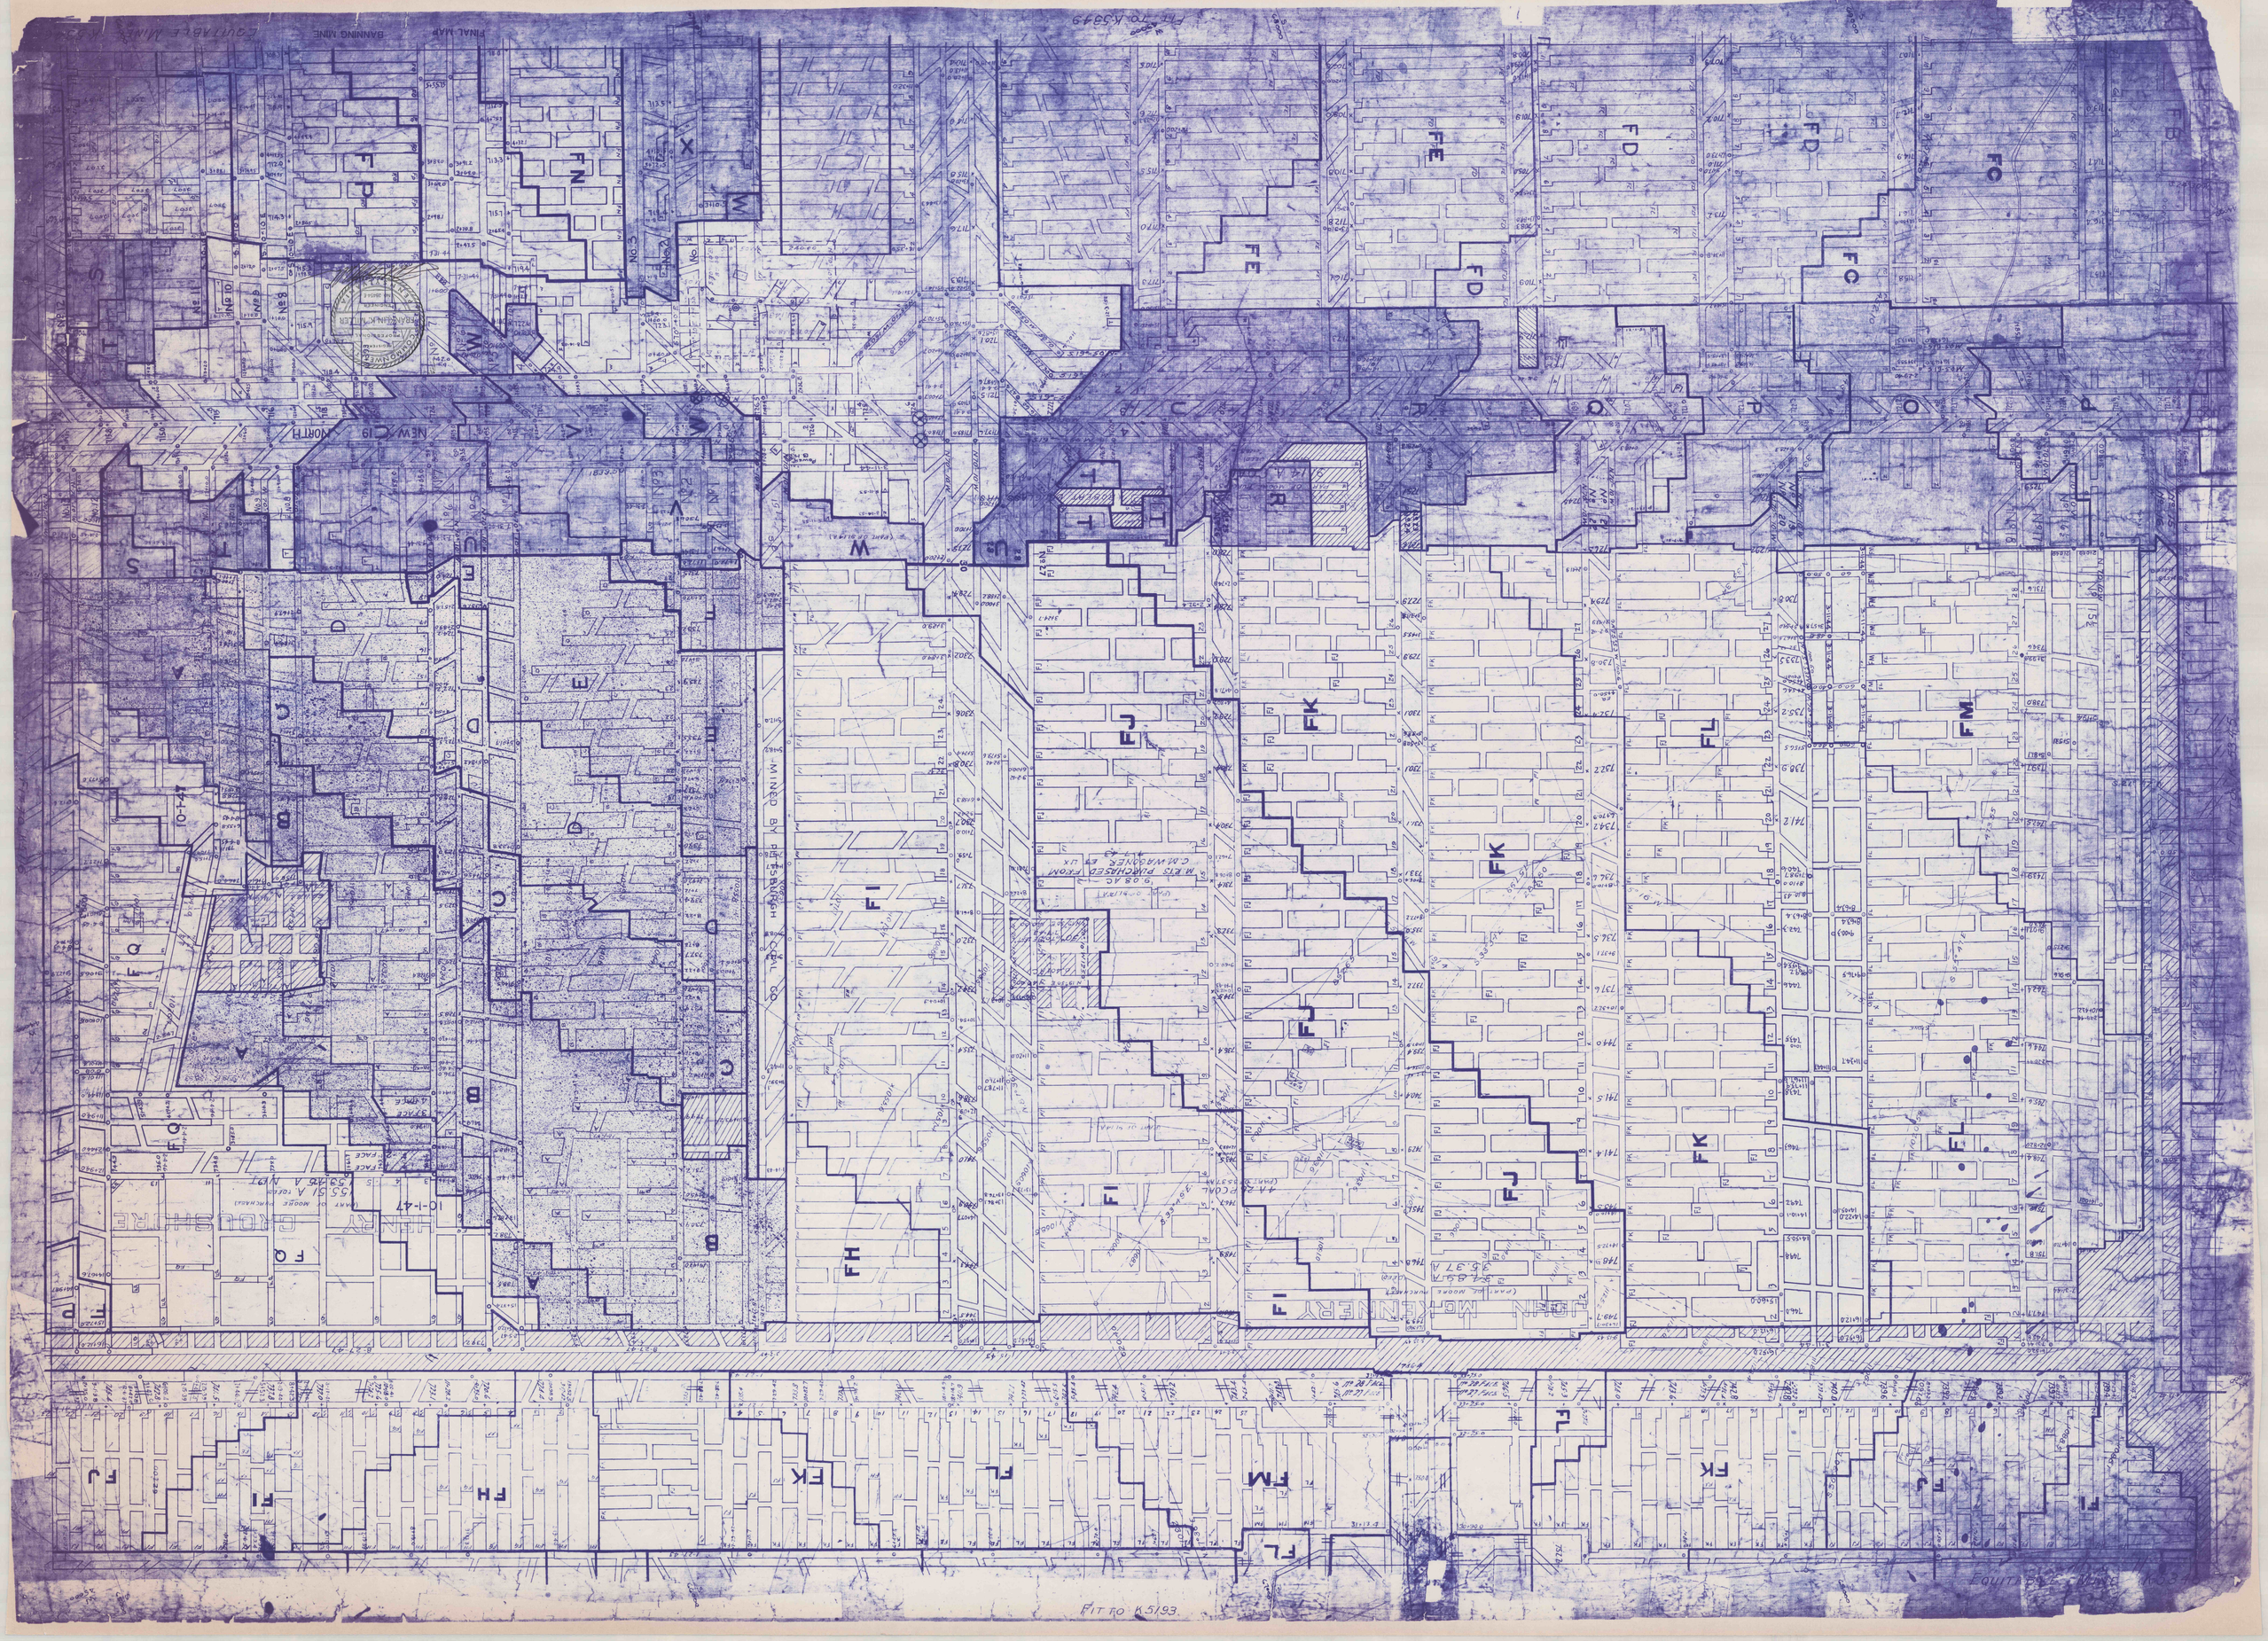
NEW CIP NORTH
FINAL MAP
EQUITABLE MINE
BANNING MINE
FILED NO. K-5349
FILED NO. K-5193
EQUITABLE MINE
NO. 3
NO. 4
NO.