


BANNING MINE K-5412

FIT TO K-5413

T. A. NOBLE
3.781 AC

FIT TO K-5306

FIT TO K-5411

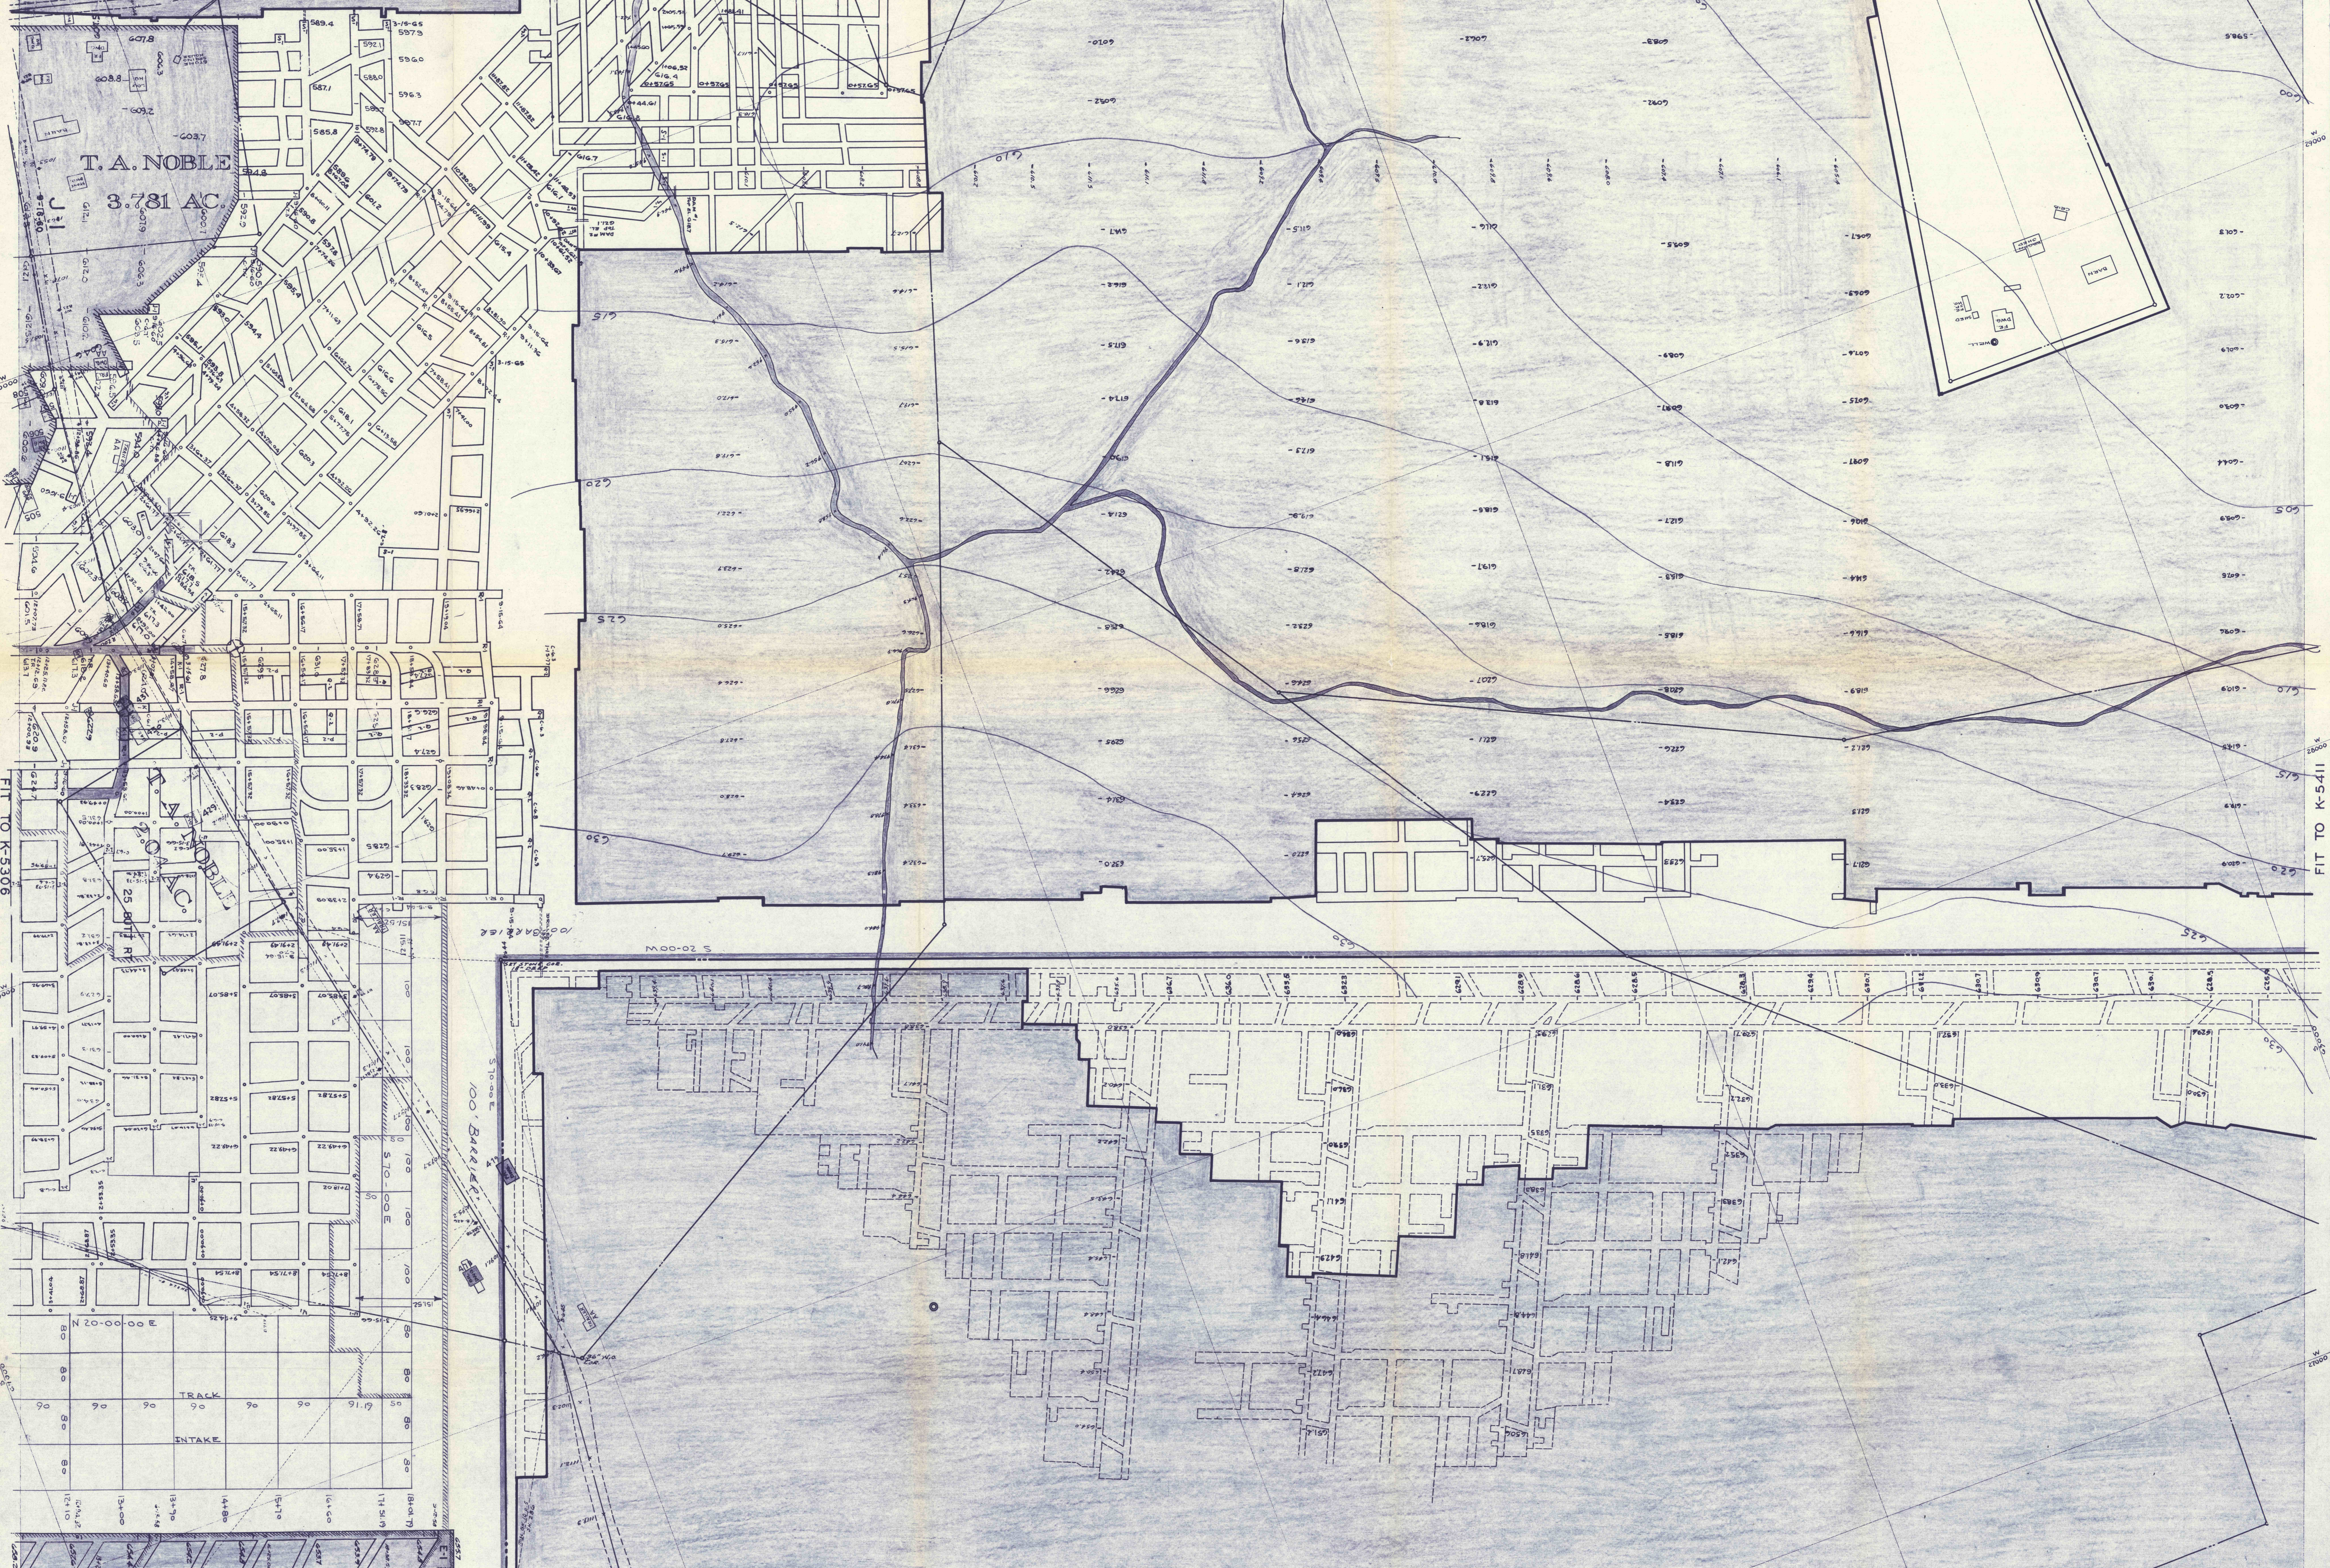

FIT TO K-5308

BANNING MINE K-5412