

STREAM to SOUTH BRANCH


PENNA. STATE GAME LANDS
warrant 3575

Cle 146

PENNA. DEPT. of FORESTS and WATERS

GREEN GLEN CORP.

LEGEND
BELTS
DEVELOPMENT PLANS
DOORS
ESCAPE WAY
GAS WELLS WITHIN MINE
INTAKE AIR CURRENT
OVERCASTS
PERMANENT STOPPINGS
REDUCED VOLUME INTAKE AIR CURRENT
REGULATOR
RETURN AIR CURRENT
SEALS (if and when needed)
TEMPORARY STOPPINGS
UNDERCASTS
LINE BRATTICE

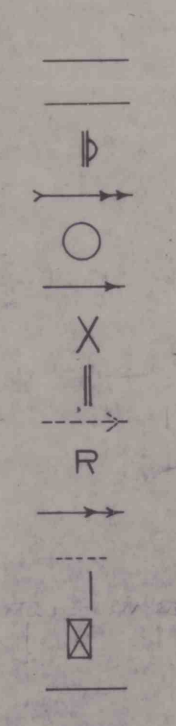

GENERAL: The following information shall be submitted to the District Manager:
1. Company name: GLEN IRVAN CORPORATION
Mine name: BARK CAMP No. 2
Post Office Address: P.O. Box 38
Town, County, State: Penfield, Chester Co., Pa.
Telephone number: 84-837-2965
USDM Identification No.: 38-02137-0
Operator's name: RYAN STOKER
Operator's title: VICEPRESIDENT
Operator's address: 501 BARKER SUMNER, Pa.
Operator's telephone No.: 84-677-7250
2. Indicate if the mine is:
 less than one year or
 greater than one year
3. Number of employees: Surface
Underground
Total

LEGEND
 Contemplated Mining 8 1/2 To 5 1/2 247 Acres.
 Mining Completed Area
Permit No. 73-3

Glen Irvan Corp.
Bark Camp No. 2
Huston Township Clearfield Co. Pa.

SCALE - 1 inch = 100 feet
FEBRUARY 2, 1971
CLEARFIELD, PA.
JOHN W. HESS
ENGINEER

NO MINES ABOVE OR BELOW
To the date 8/9/72 this is a complete and accurate map of all the workings and workings set signs of the Bark Camp No. 2 mine.
John W. Hess