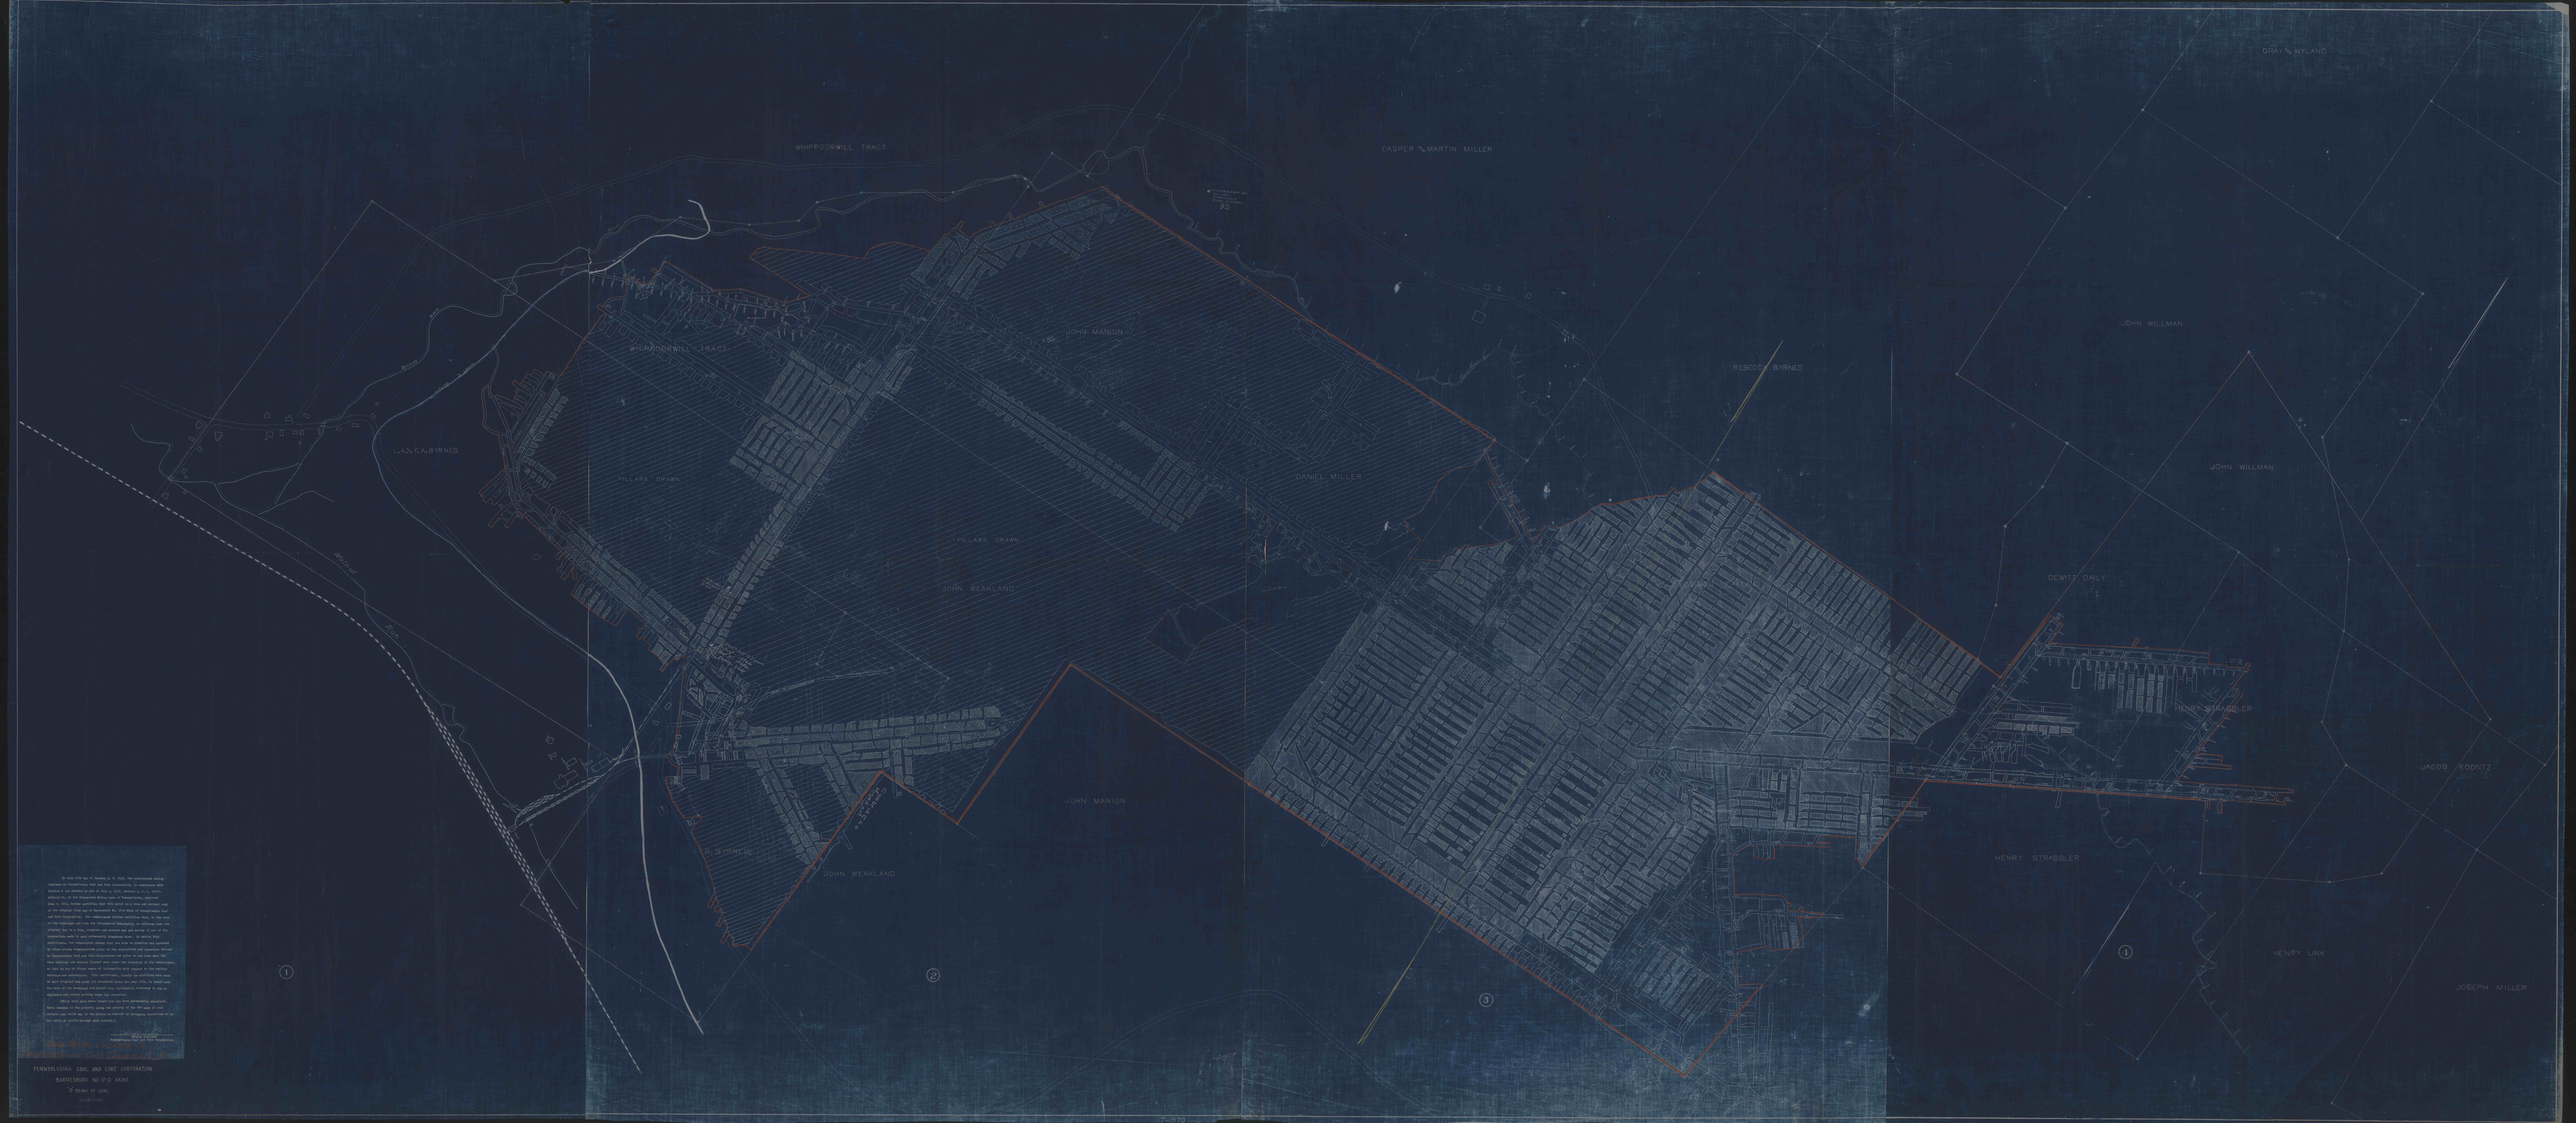

PENNSYLVANIA COAL AND COKE CORPORATION

BARNESBORO No 17-D MINE

Scale of Coal

Scale 1:240