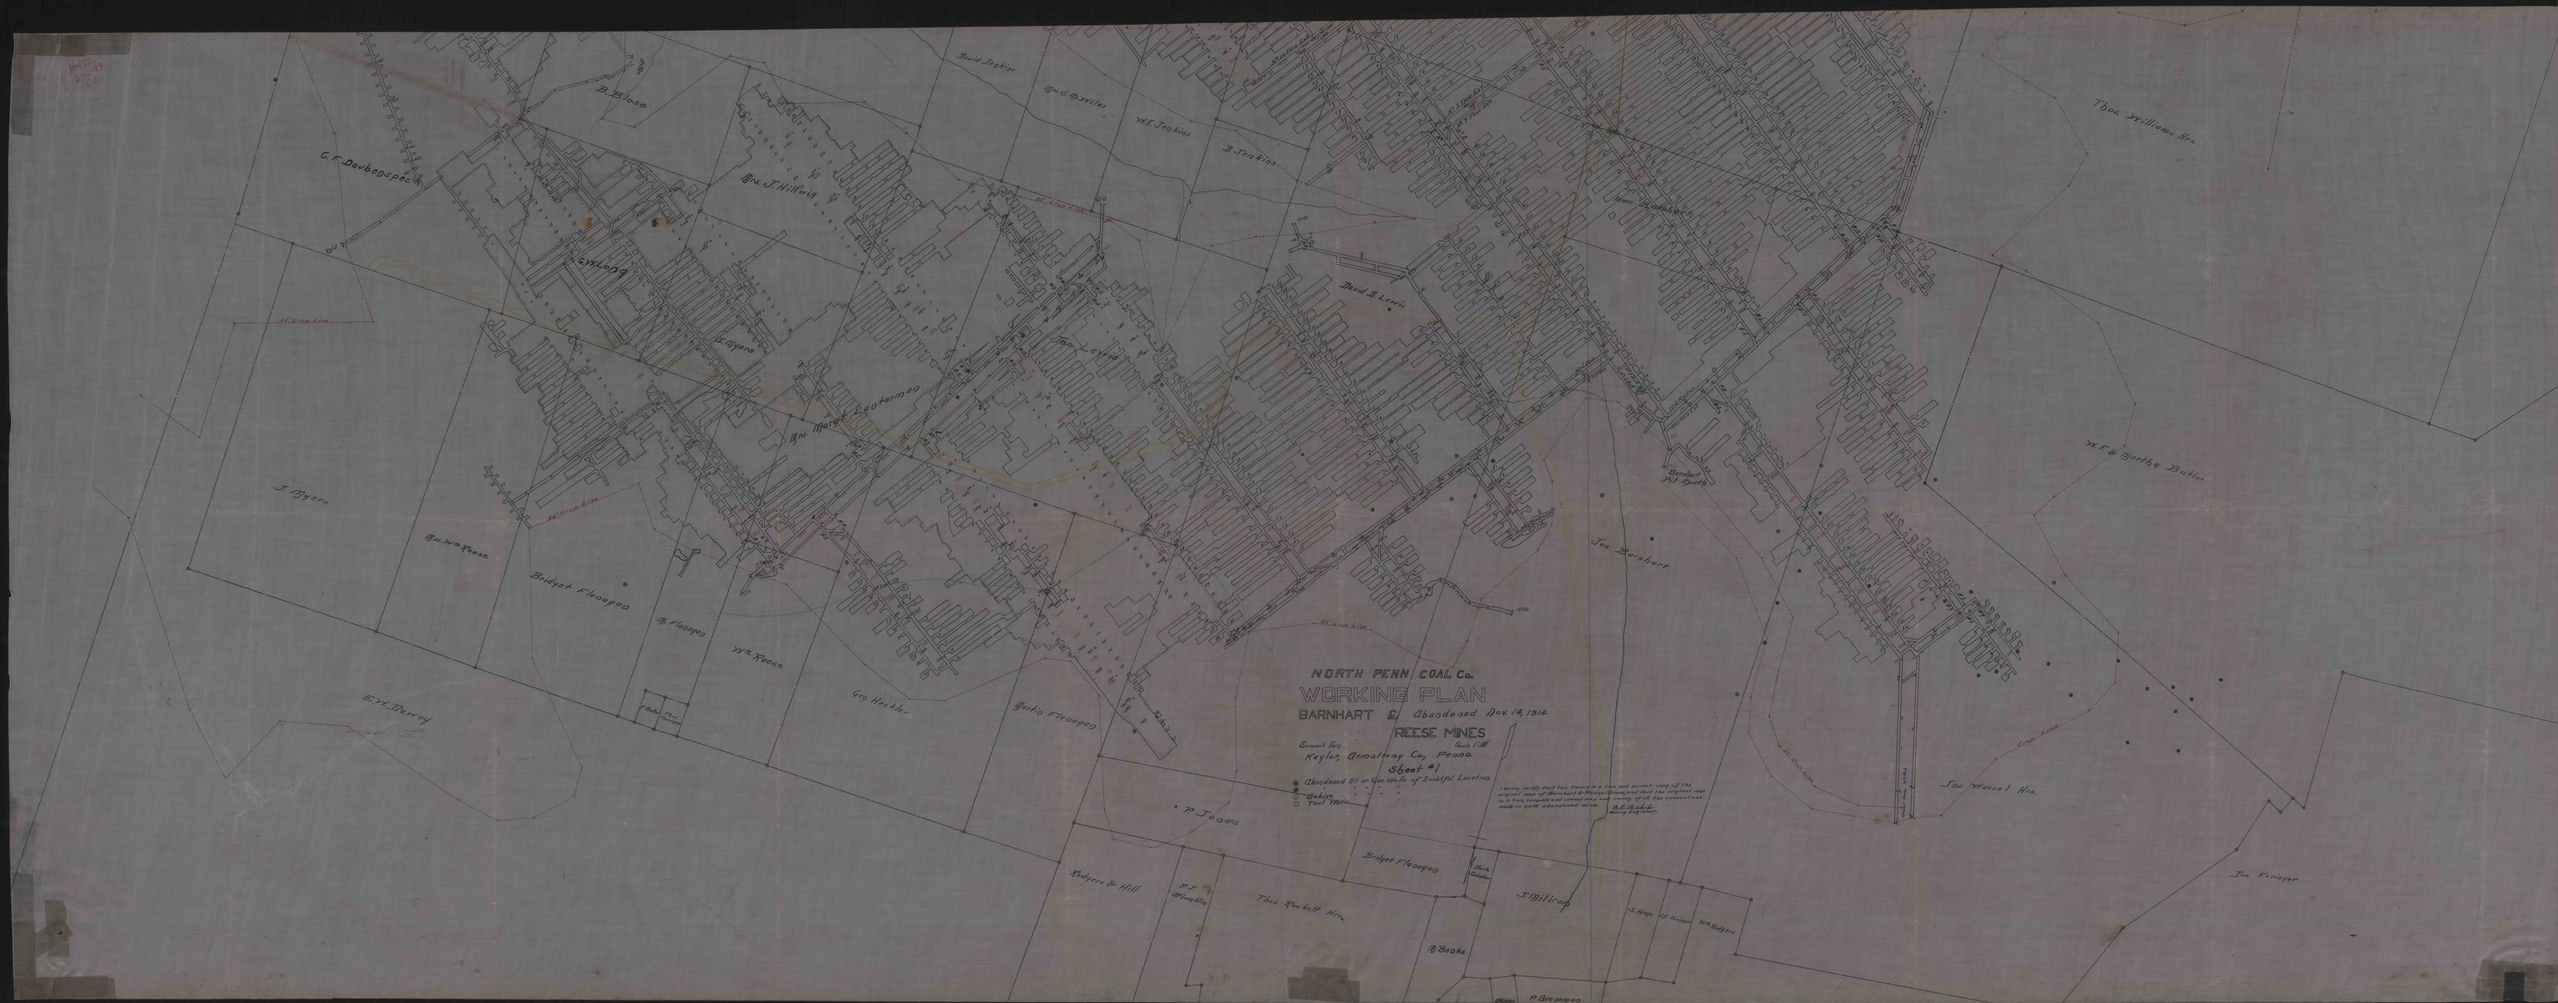
NORTH PENN COAL Co.
WORKING PLAN
BARNHART & REESE MINES
Abandoned Nov. 14, 1914
Taylor, Armstrong Co., Penna.
Sheet #1
Abandoned Oil or Gas Wells of Doubtful Location
Active
Test Wells
I hereby certify that this map is a true and correct copy of the original map of Barnhart & Reese Mines, and that the original map is in the company's vault, and that all the corrections made in red, are correct.
B. E. Baker
Mine Inspector.
C. F. Daubenspeck
B. Close
Geo. F. Hilliard
Geo. Ayers
Geo. Mary Lautermoo
J. Ayers
Geo. Reese
Bridget Flanagan
P. Flanagan
Wm. Reese
Geo. Hacker
Gertie Flanagan
E. V. Berry
P. Jones
Bridget Flanagan
Robert & Hill
M. F. Mitchell
Thos. Rockliff Hrs.
J. Billing
P. Beahe
P. Brennan
Jas. Barnhart
Bernhart Pit Drift
Thos. Williams Hrs.
M. F. & Martha Butler
Jno. Wrassel Hrs.
Jas. Forsyth