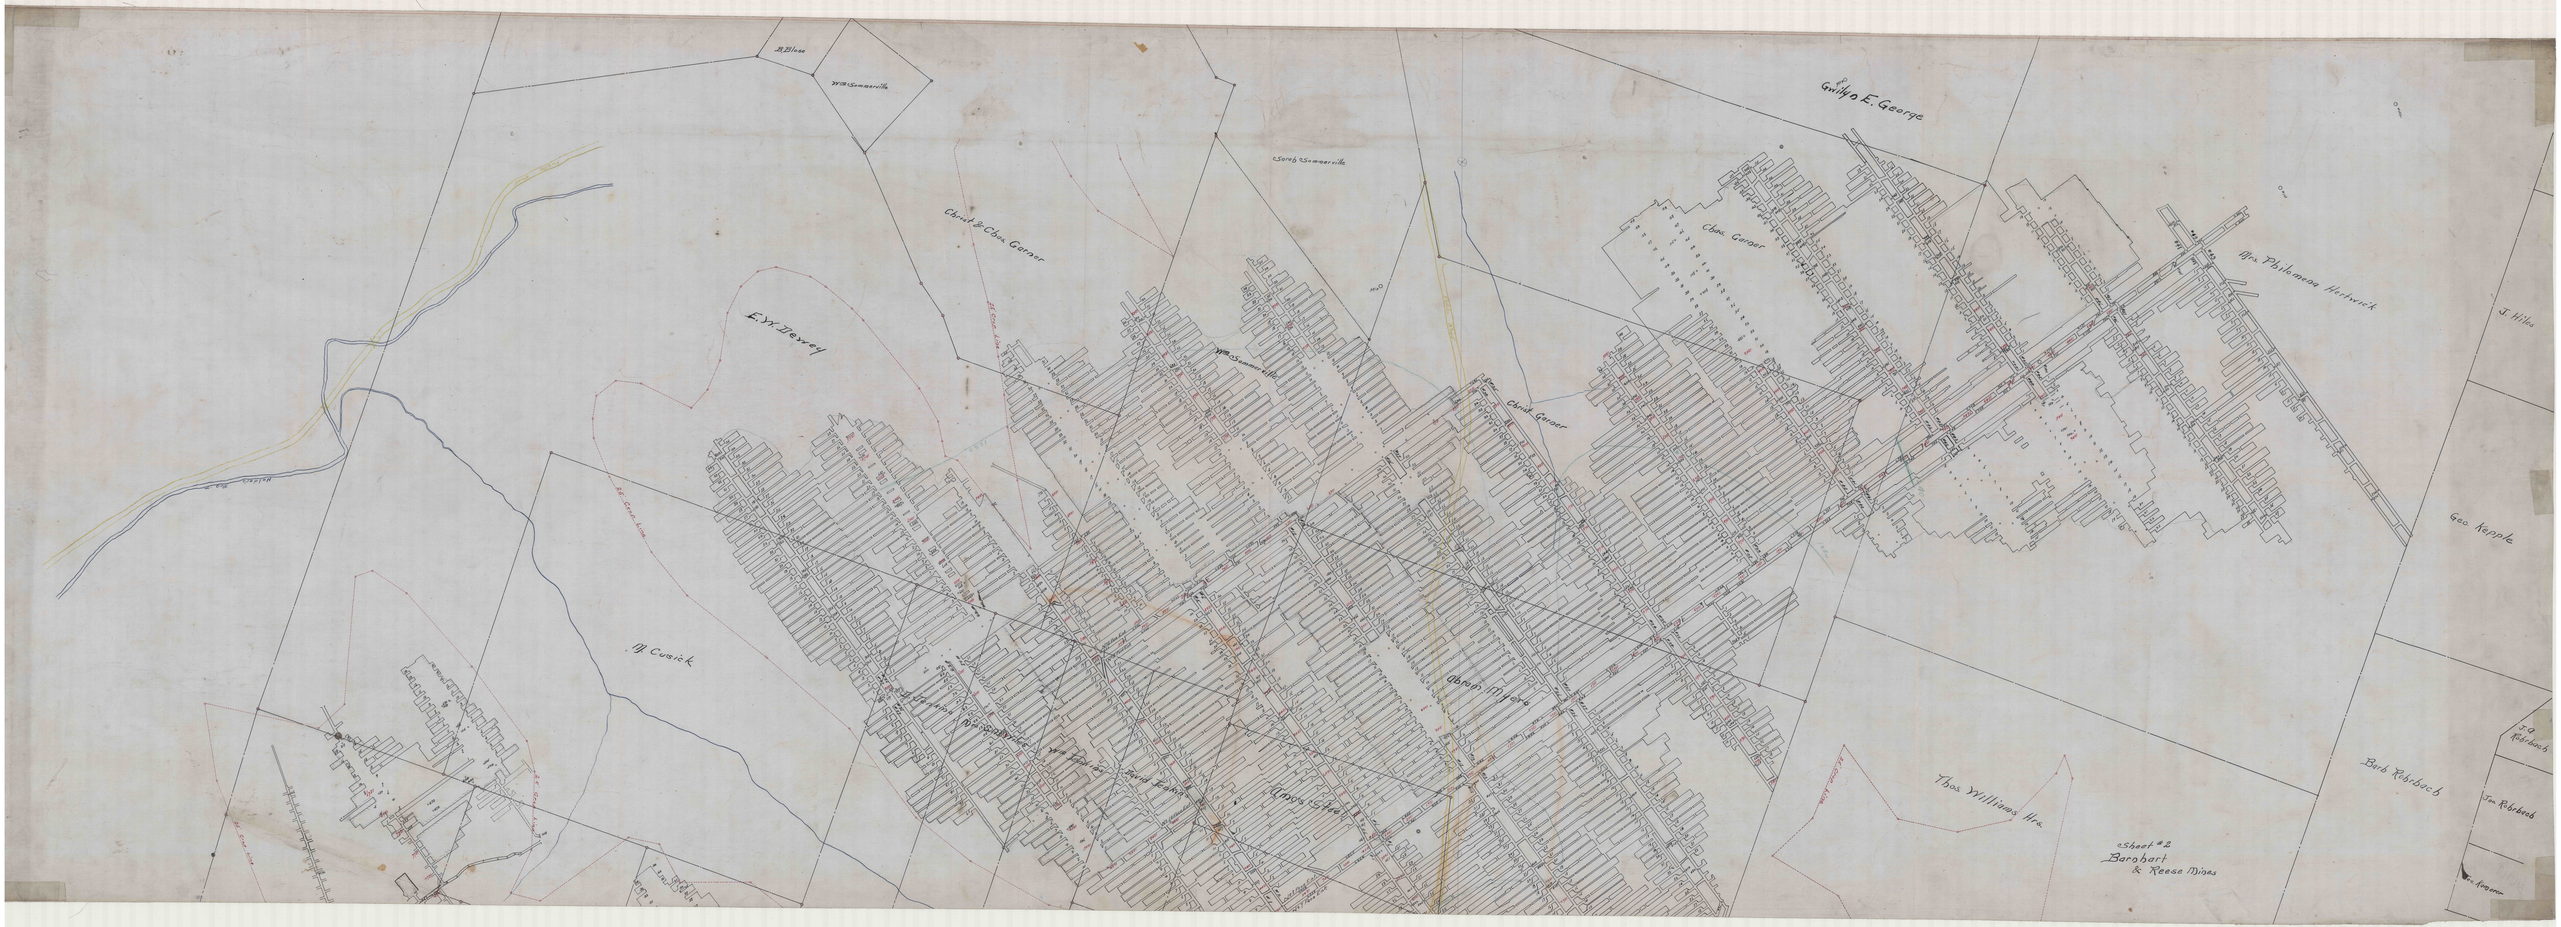
R. Bloss
Wm Somerville
Chas & Chas Garner
E.M. Dewey
M. Cusick
Wm Somerville
Chas Garner
Chas Garner
Chas Garner