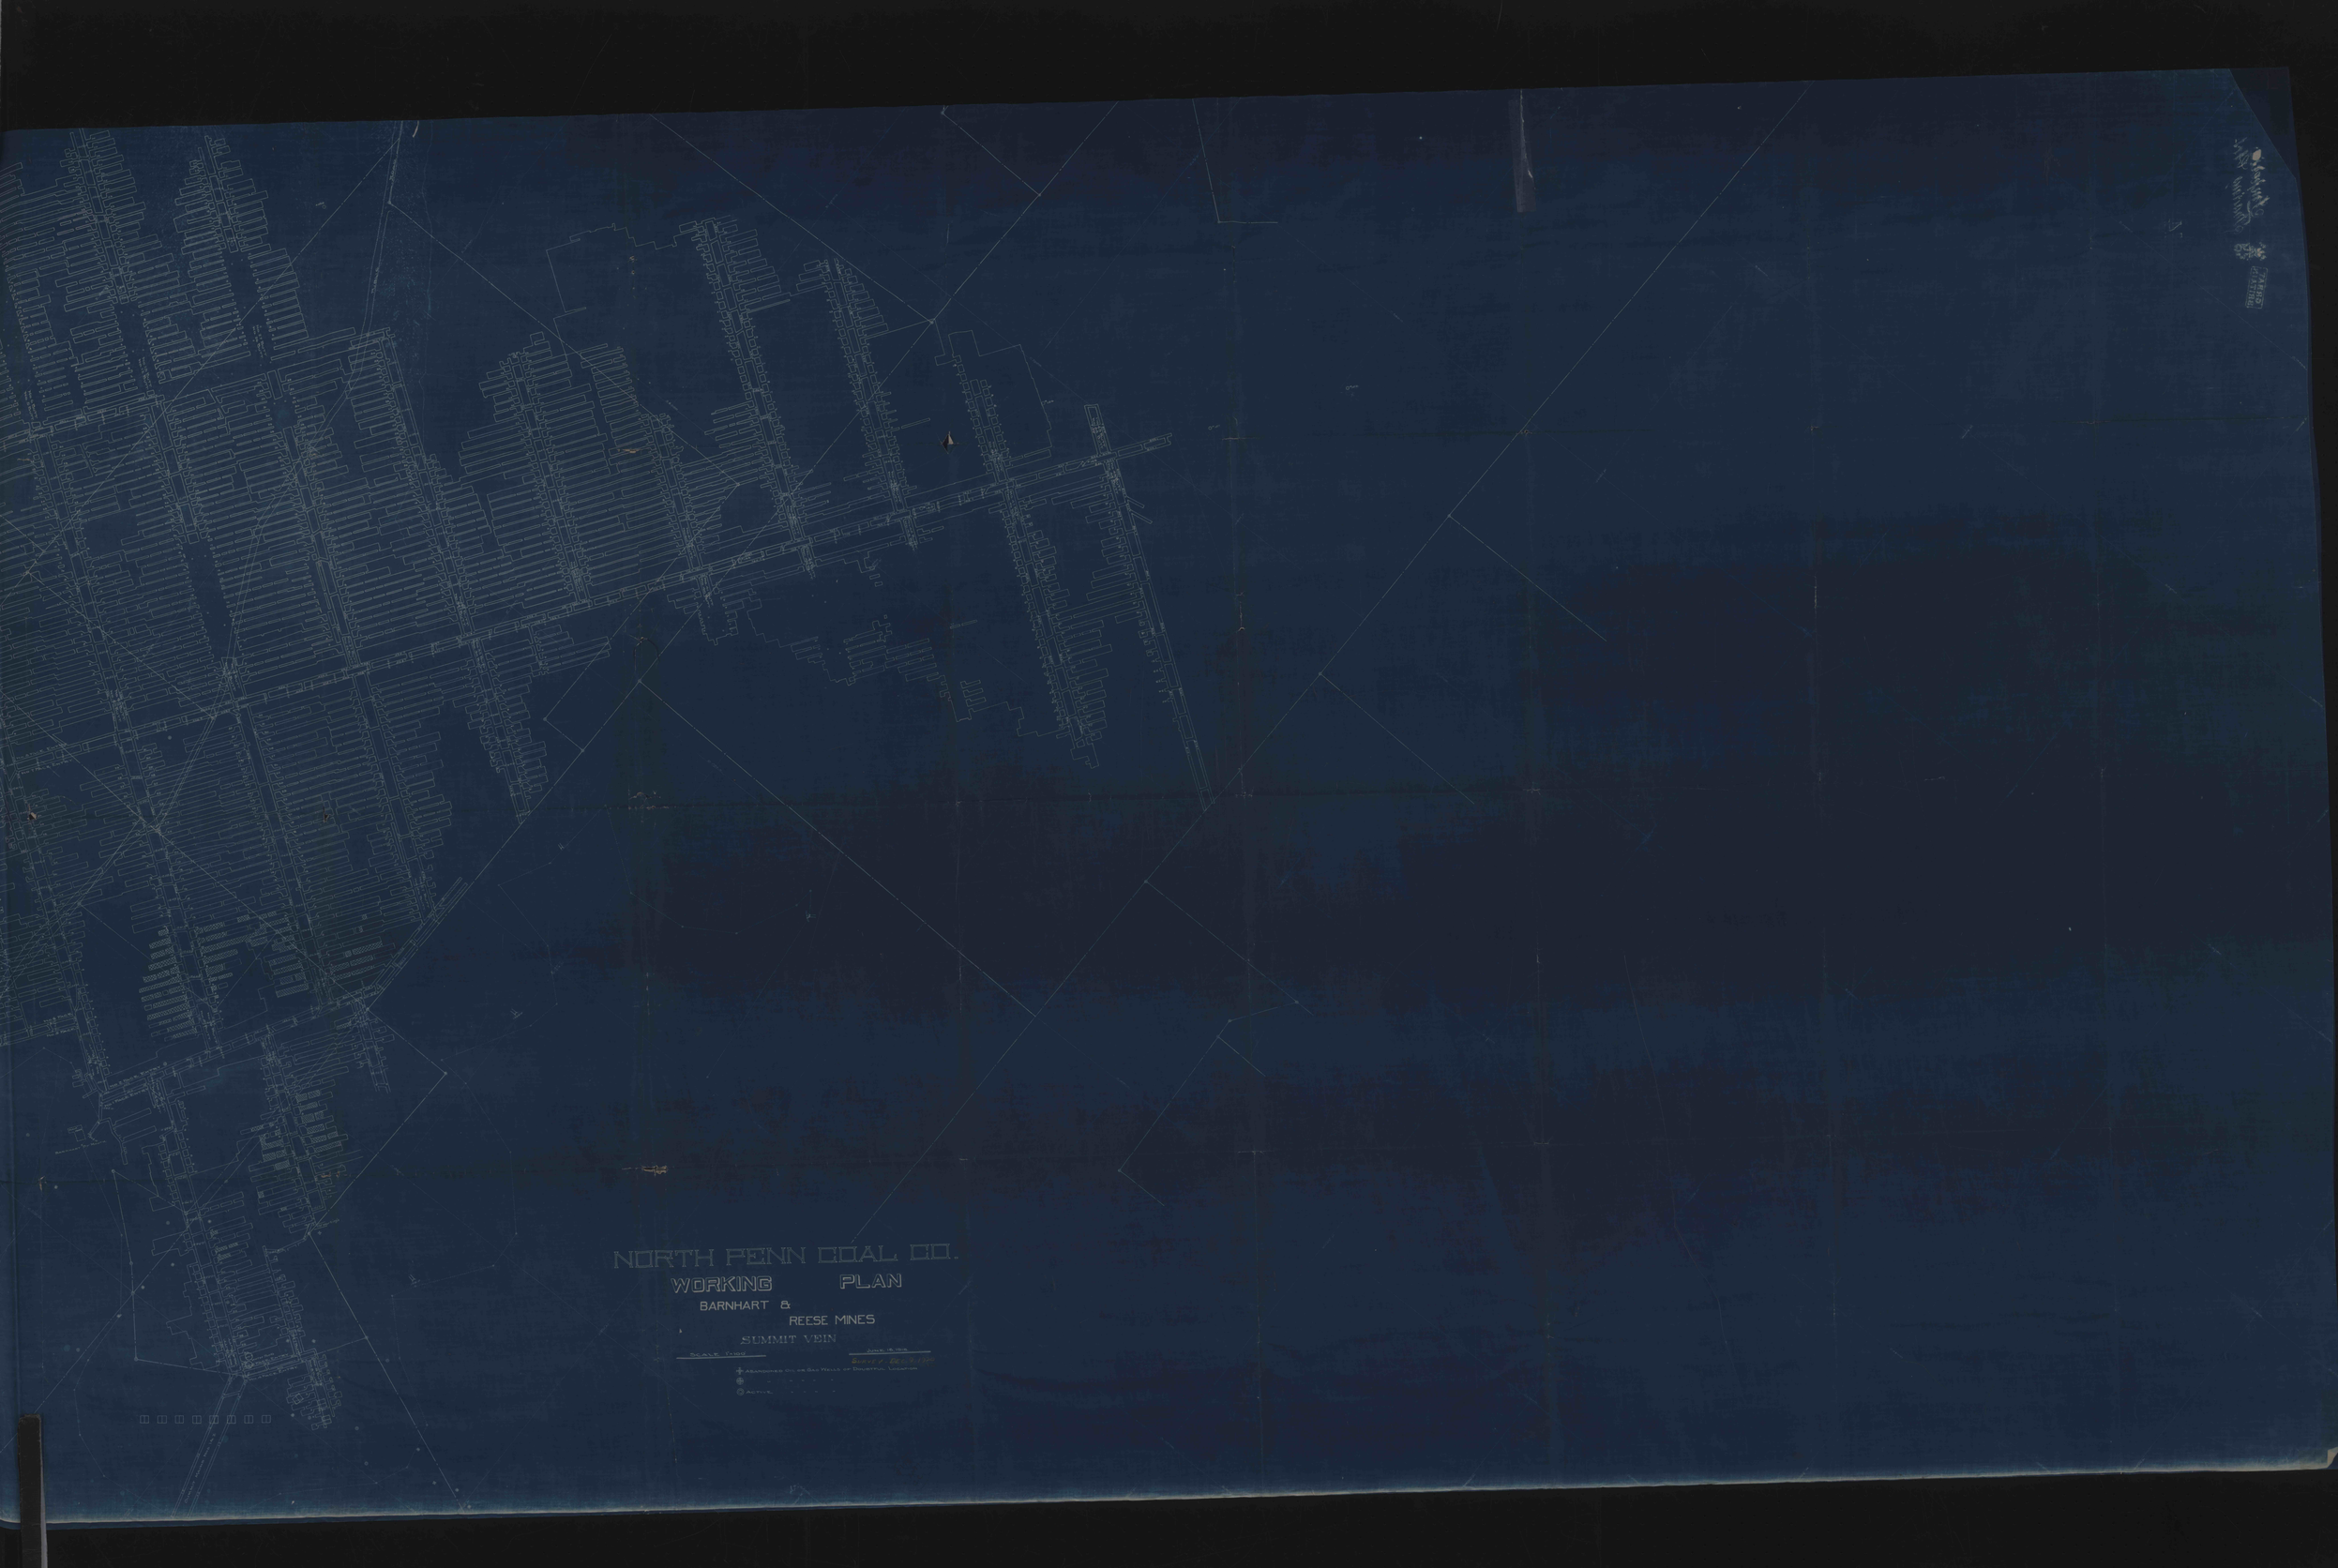

NORTH PENN COAL CO.

WORKING PLAN

BARNHART &

REESE MINES

SUMMIT VEIN