


LOWRY STRONG

L. H. FOEHRNBACH - FEE

L. H. FOEHRNBACH - FEE

CICERO HRS - SURFACE
LEASURE BRO'S - COAL

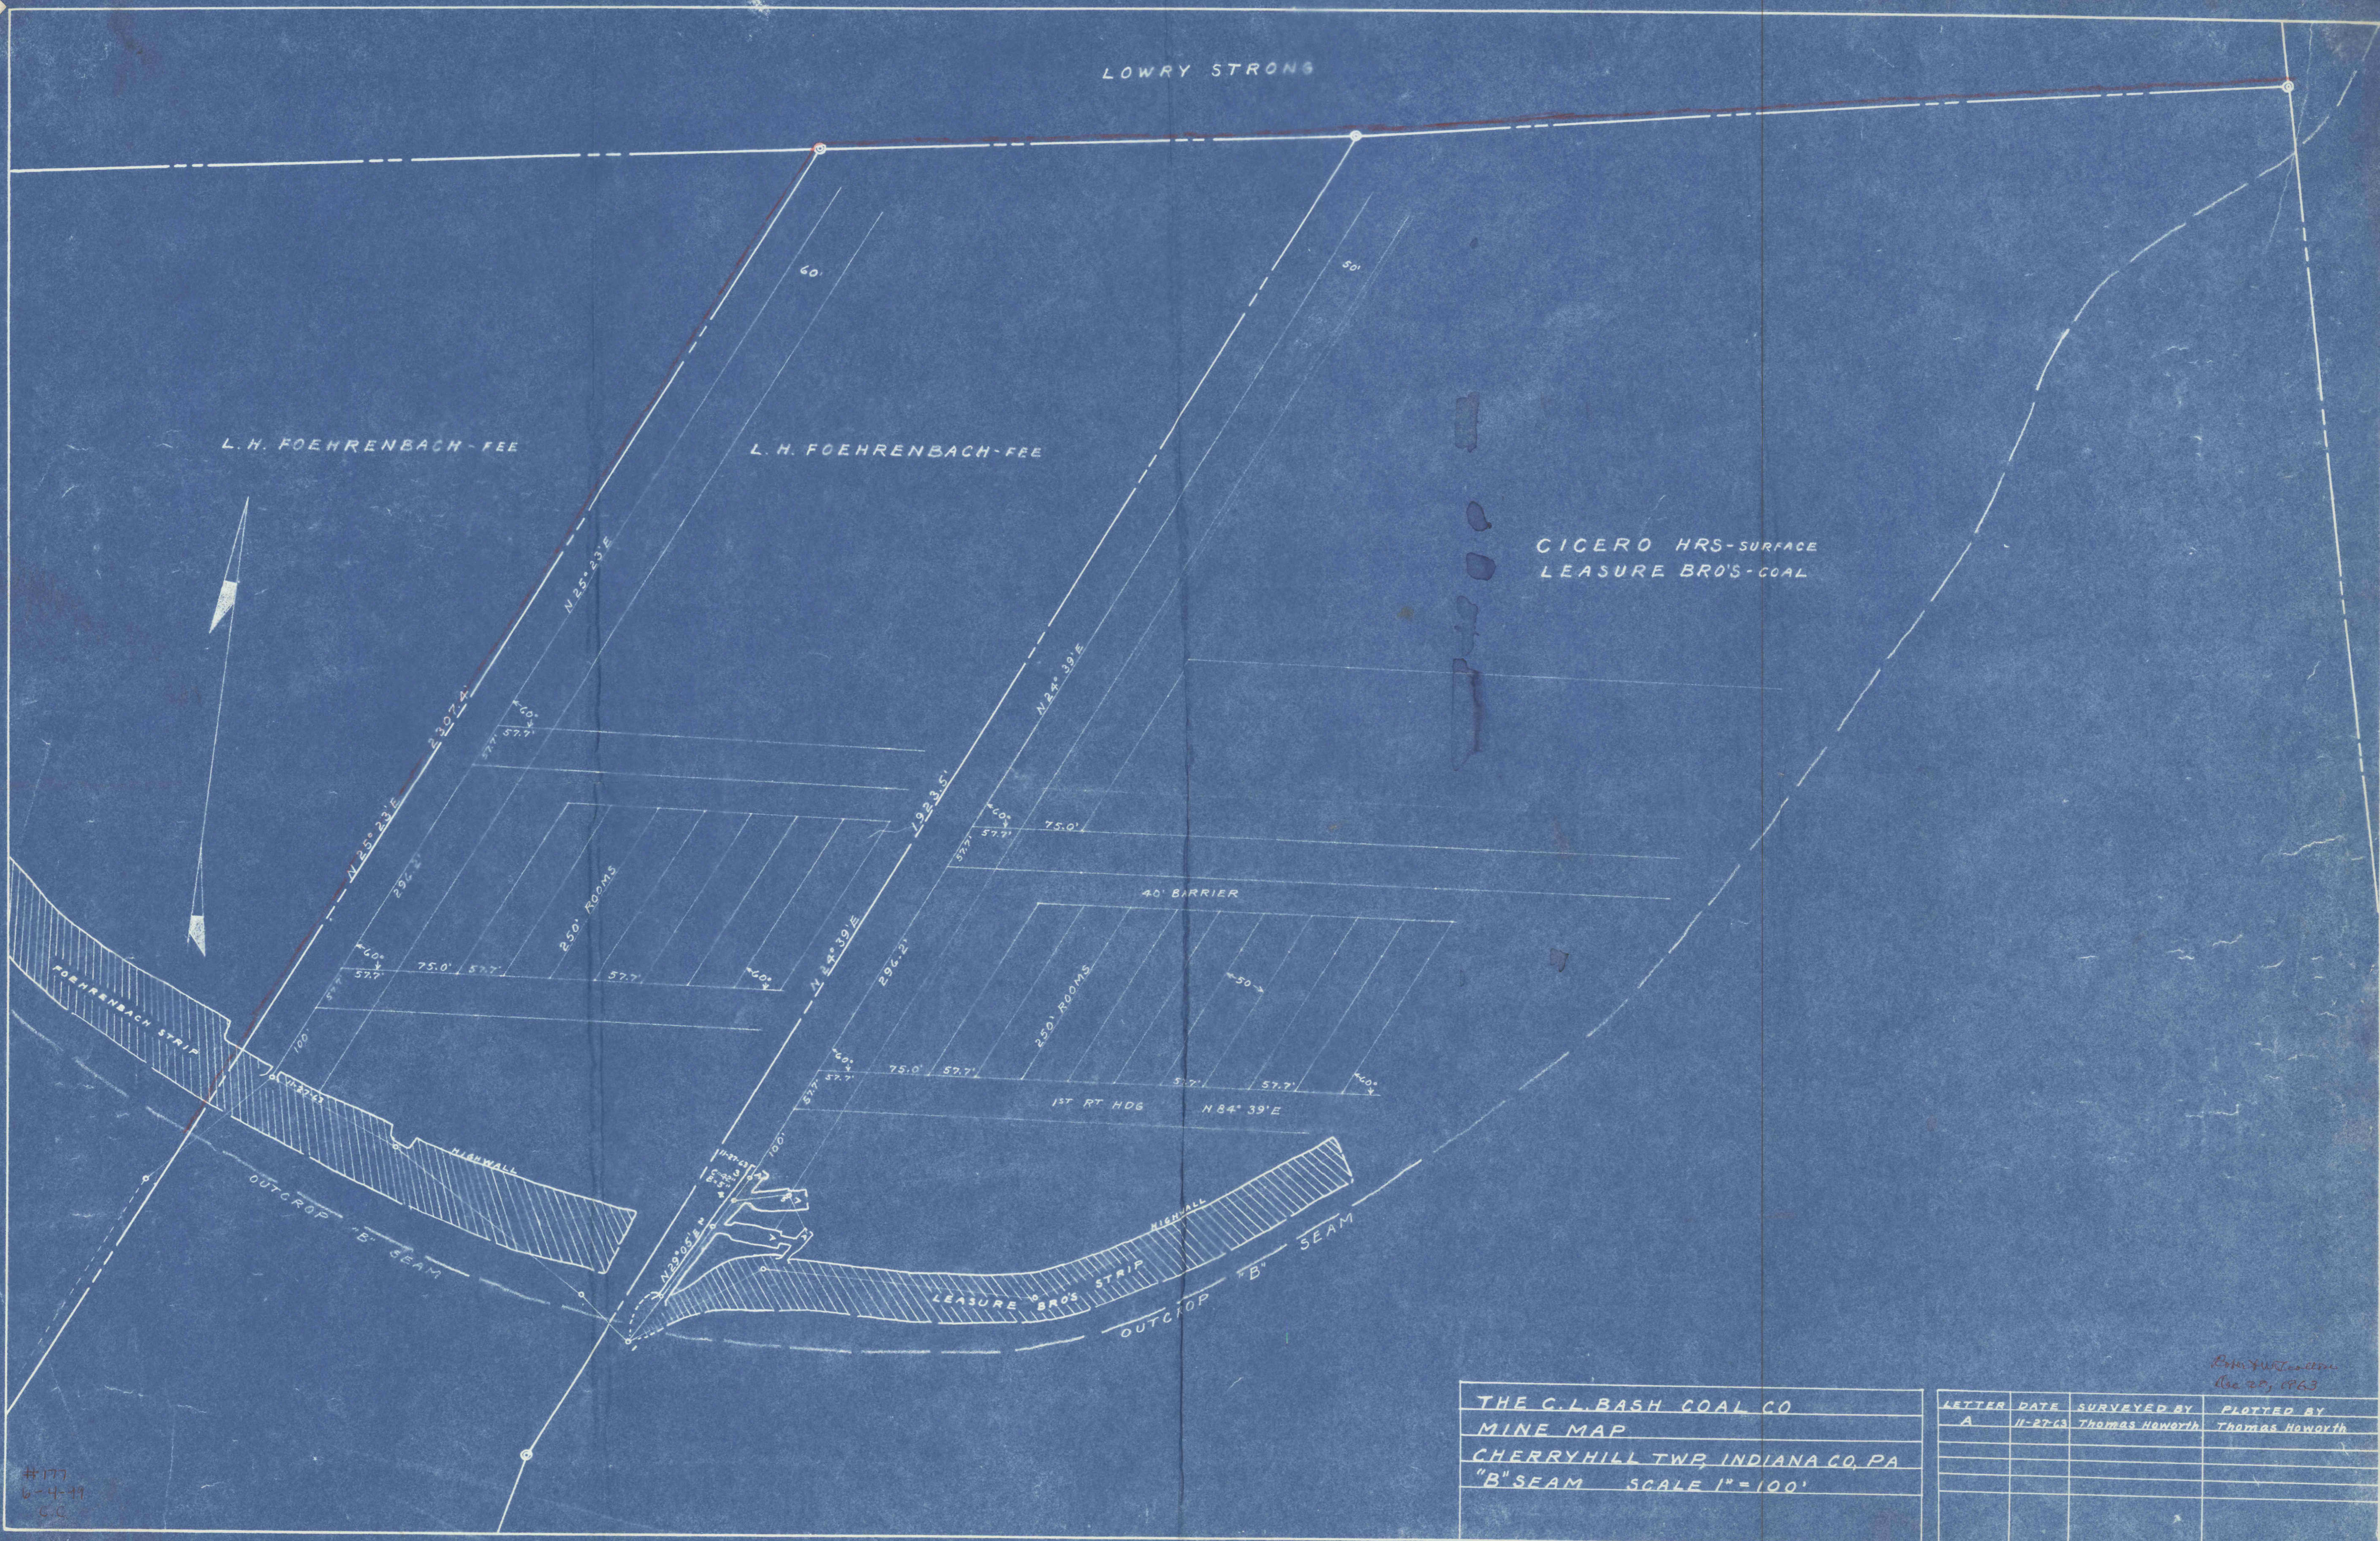

THE C. L. BASH COAL CO
 MINE MAP
 CHERRYHILL TWP, INDIANA CO, PA
 "B" SEAM SCALE 1" = 100'

LETTER	DATE	SURVEYED BY	PLOTTED BY
A	11-27-63	Thomas Howarth	Thomas Howarth

Checked by
 (See 28, 1963)

#177
 6-4-11
 C.C.