


#180
6-7-99
C.C.

ELY & FRENCH
NOW - JOHN J. BAUGHMAN MINE



Pittsburgh Consolidation Coal Co.
M.R.D. Torrence Tract.

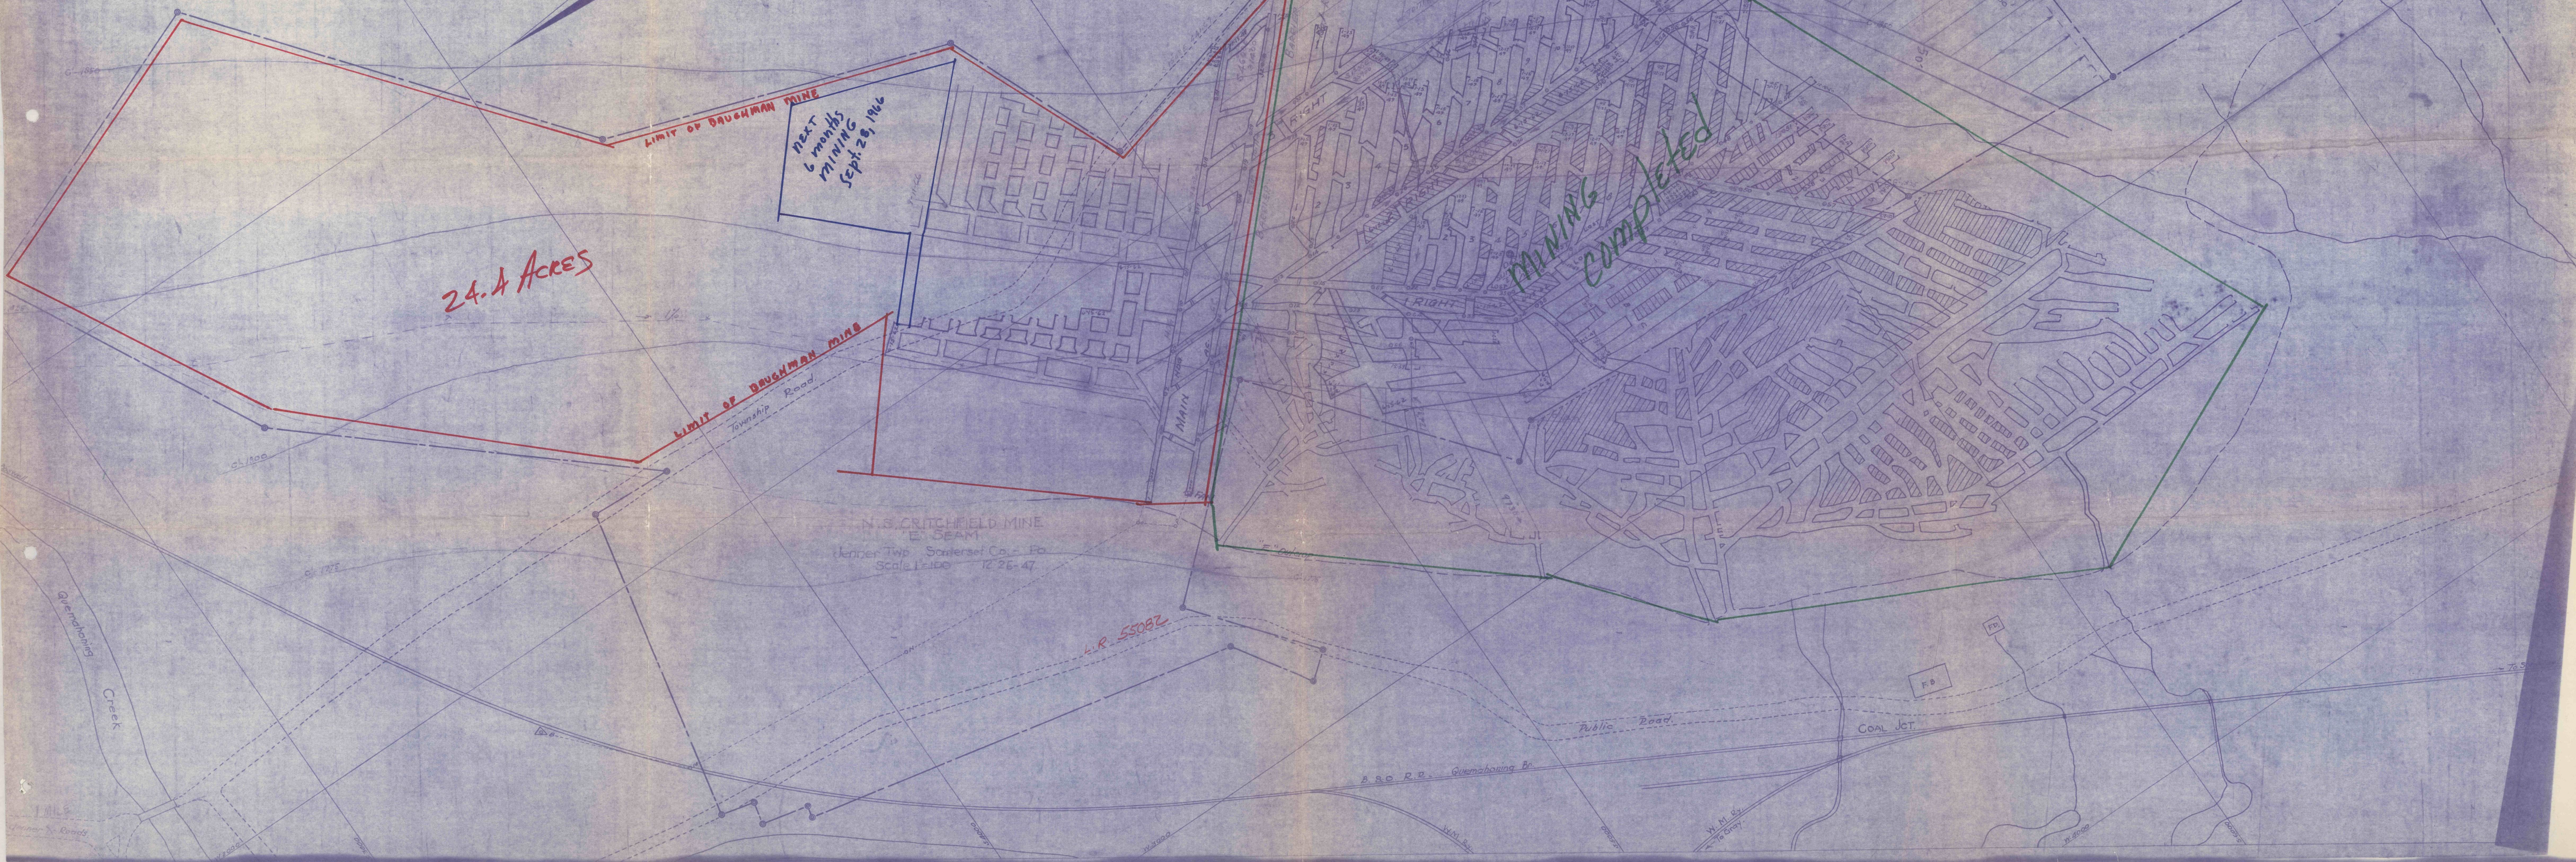

24.4 ACRES

LIMIT OF BAUGHMAN MINE
NEXT 6 MONTHS MINING

MINING COMPLETED

N.S. CRITCHFIELD MINE
"E" SEAM
Jenner Twp. Somerset Co. - Pa.
Scale 1"=100' 12-26-47

L.R. 55082

COAL JCT.

A.S.C. R.R. - Quenahoning Br.

W.M. by
The Company

Quenahoning
Creek

N. PATRICK

DeLope Tract

RIGHT

RIGHT

MAIN

Jenner Twp. Roads