
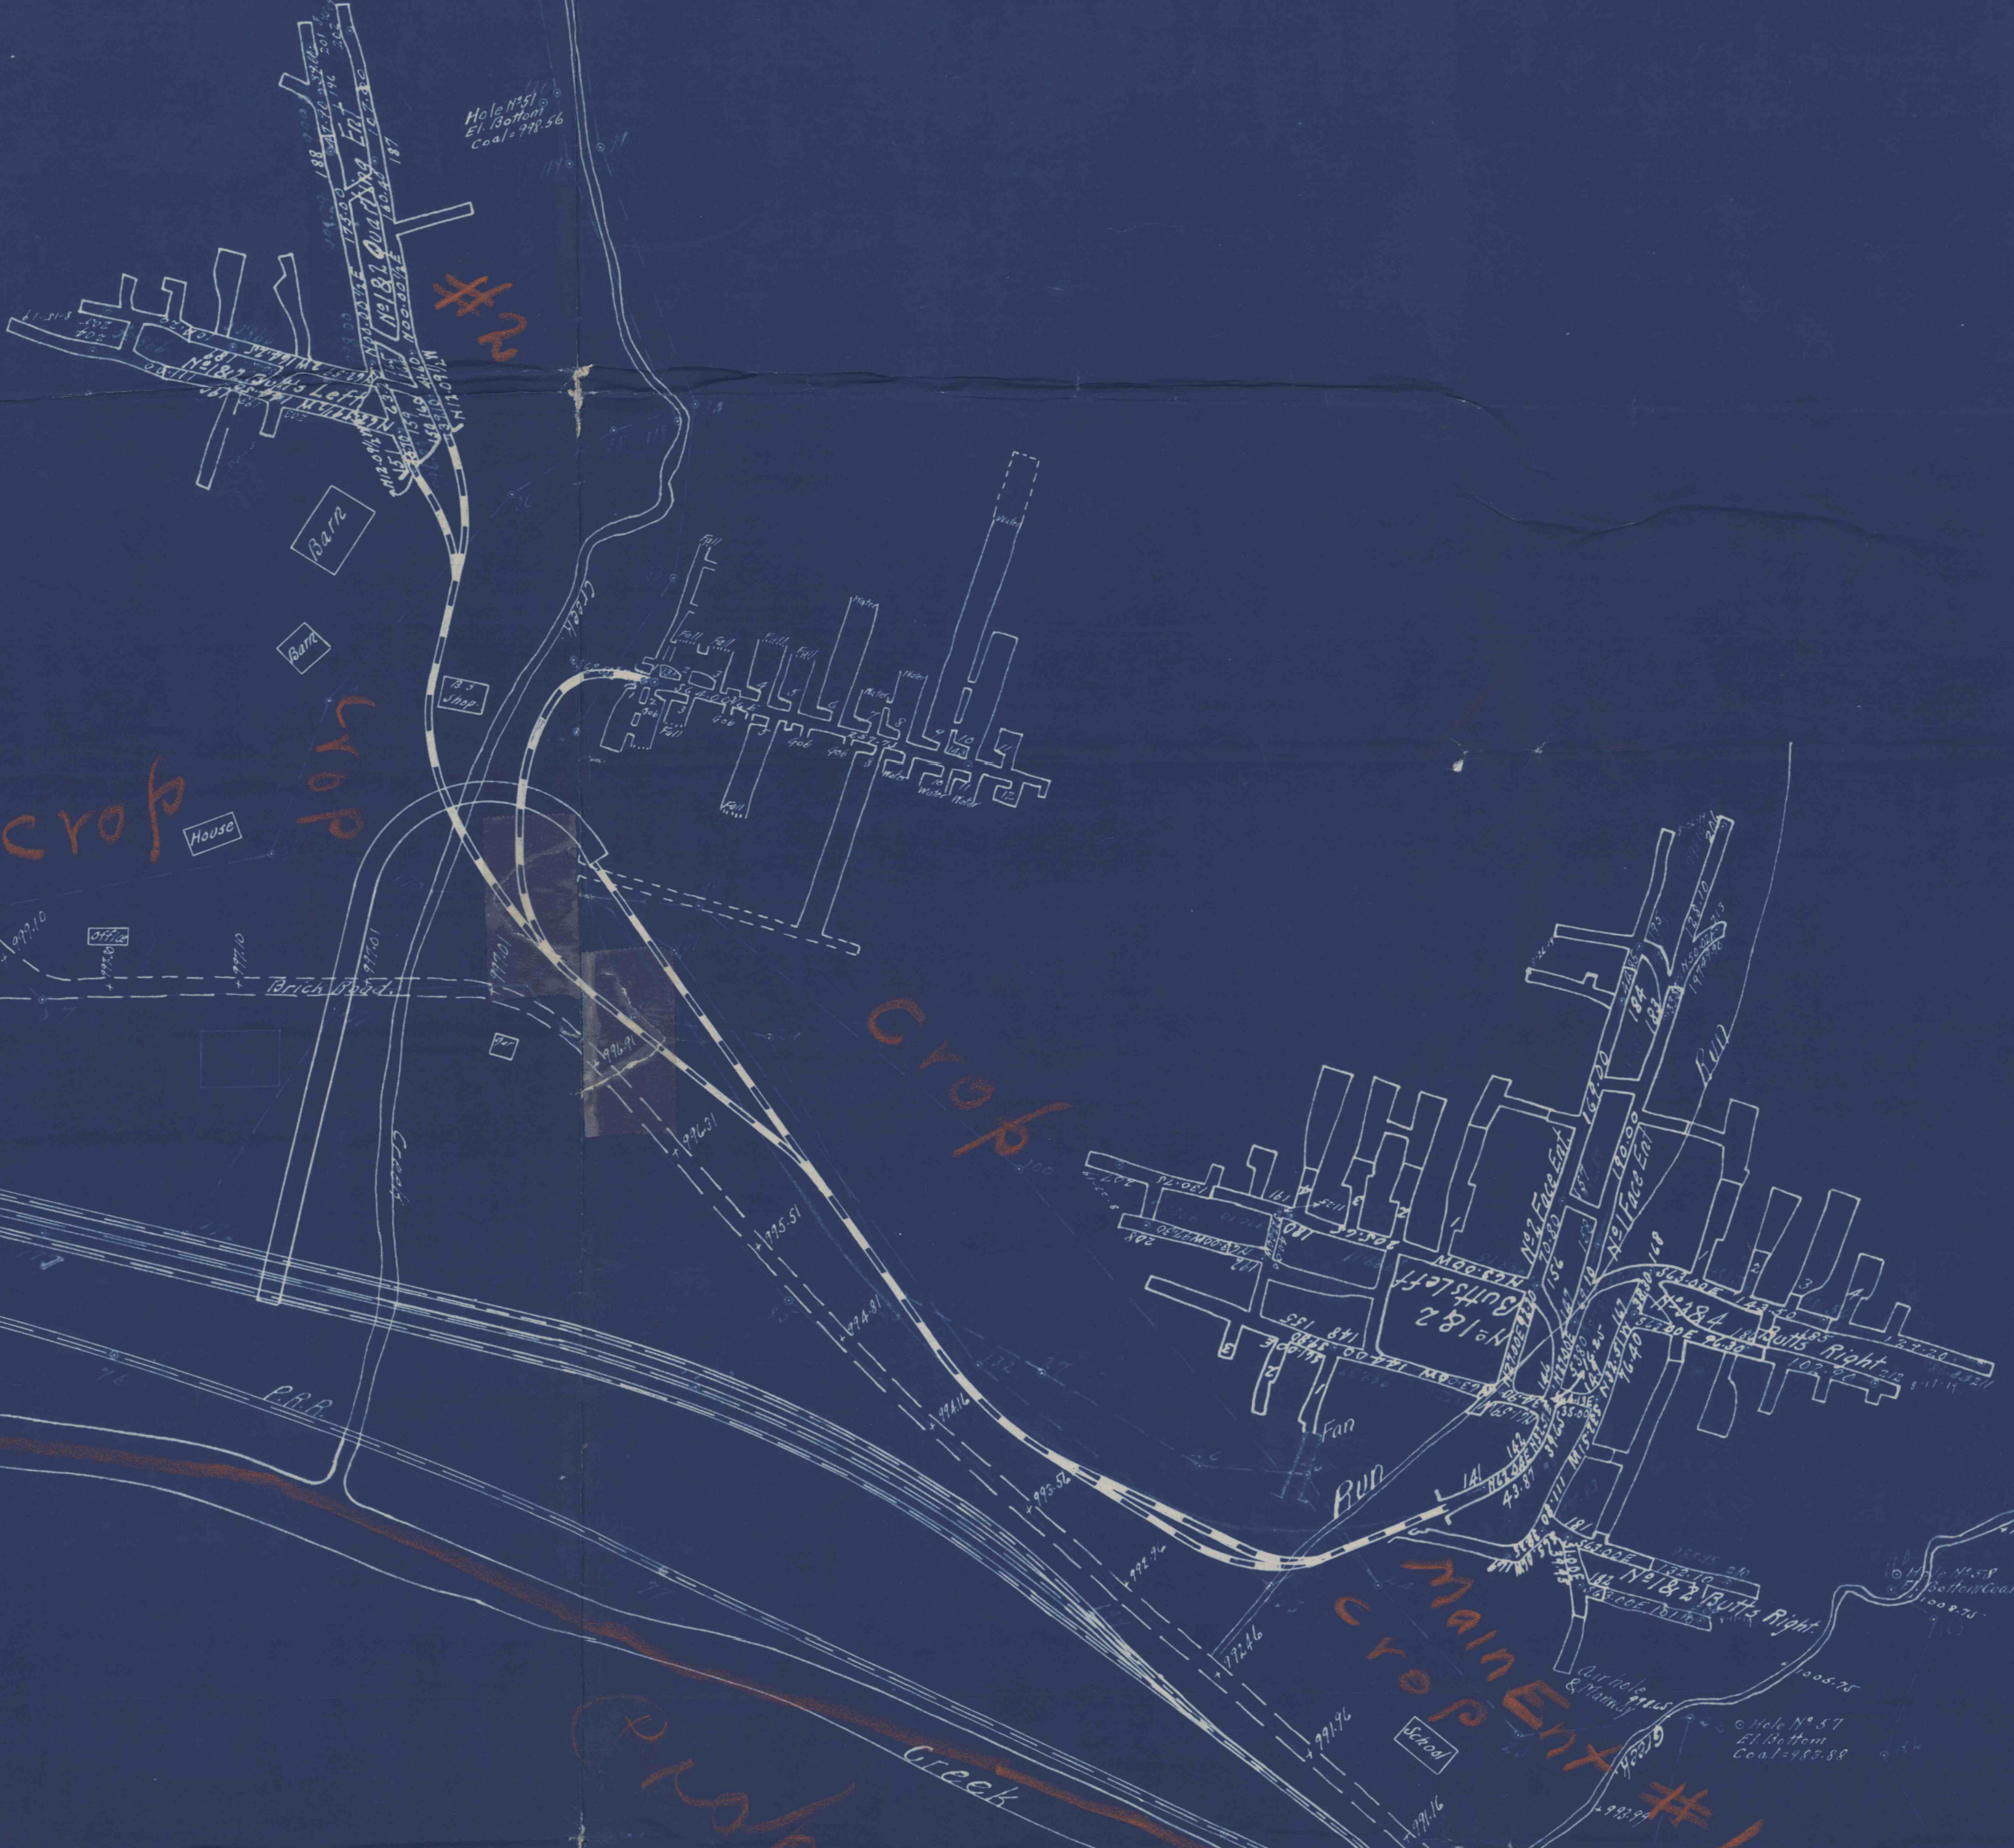


Property line

Pittsburg Vein 5'-6" Thick
148 Rows
Solid coal

25 Acres strip
of coal in this
area

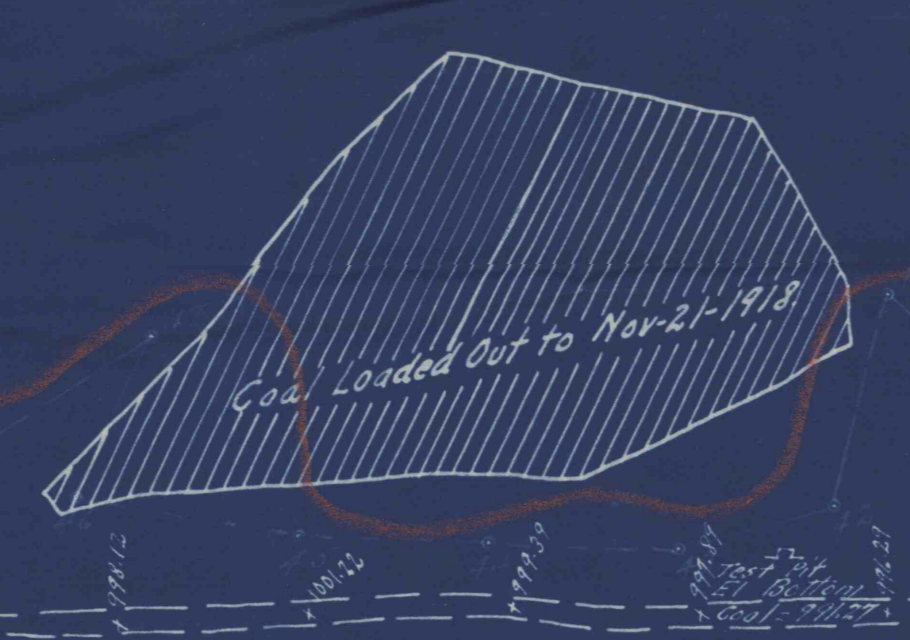

230 Acres in Fee



Chartiers Twp
Washington Co Pa

PLAN OF
BEECH HILL MINE
EXPORT COAL CO
SCALE 1=100