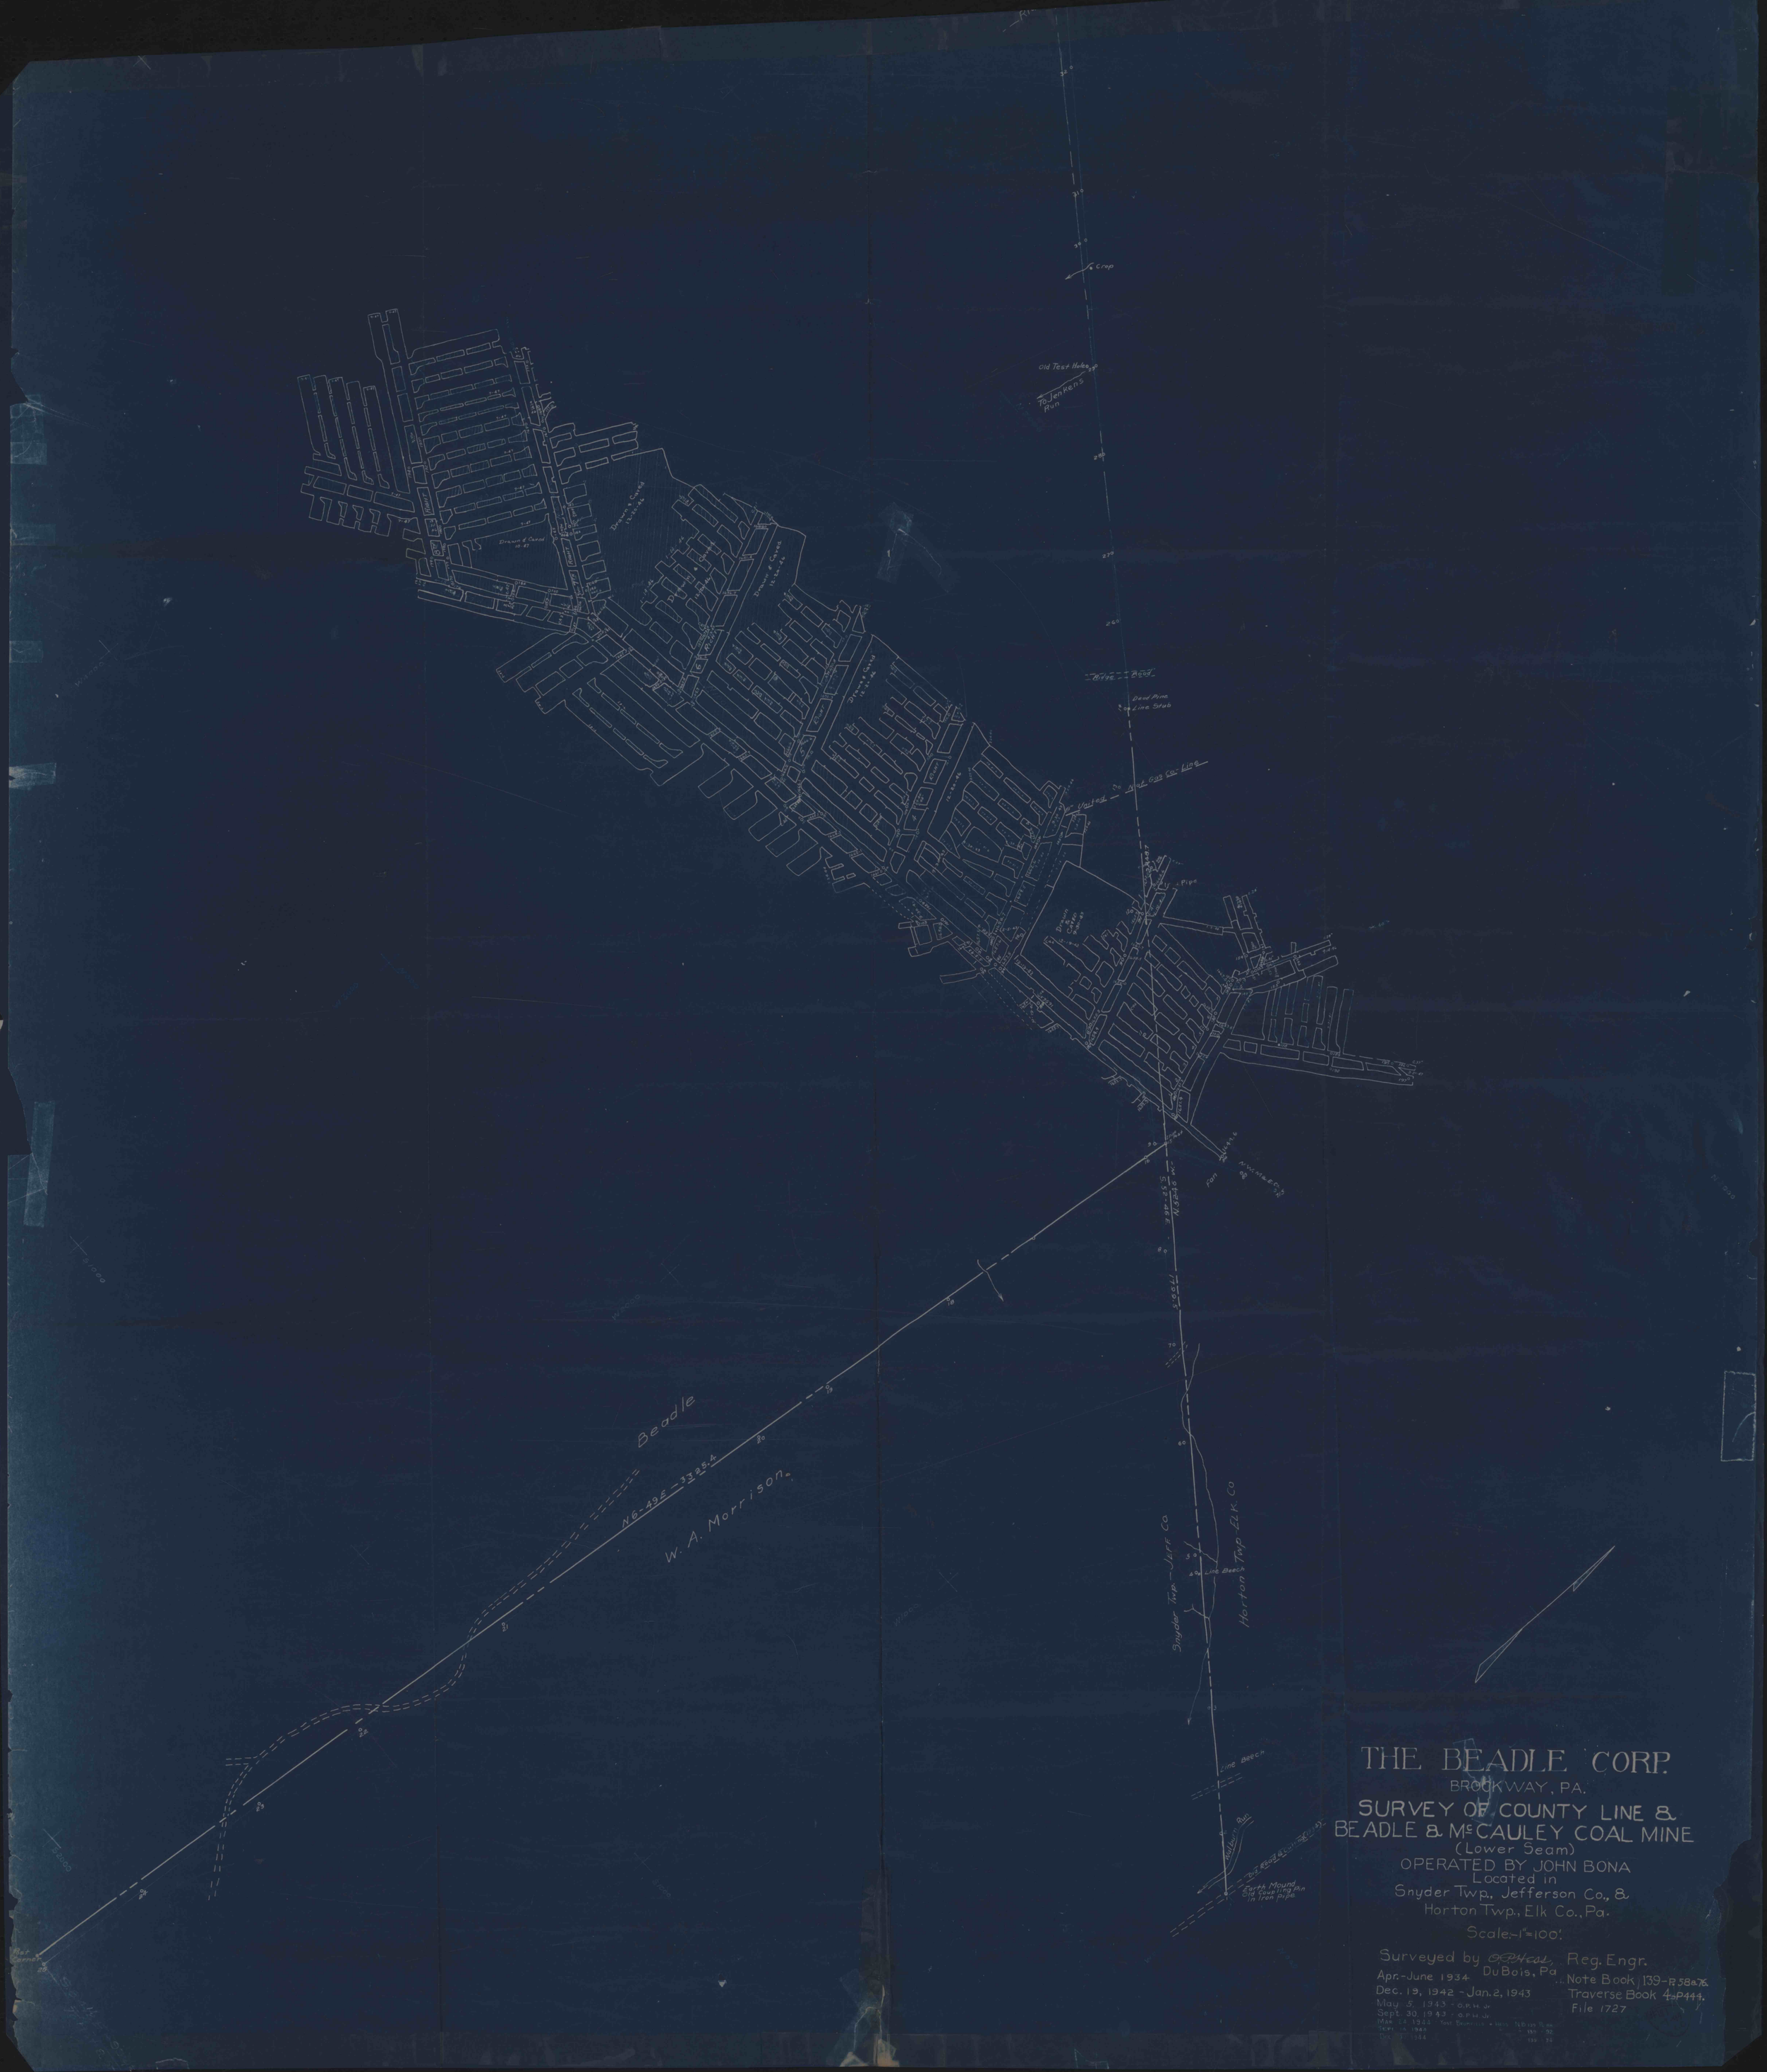
Crop
Old Test Holes
To Jenkens Run
Drown & Cased 13.3.44
Drown & Cased 10.43
Drown & Cased 13.3.44
Drown & Cased 13.3.44
Drown & Cased 13.3.44