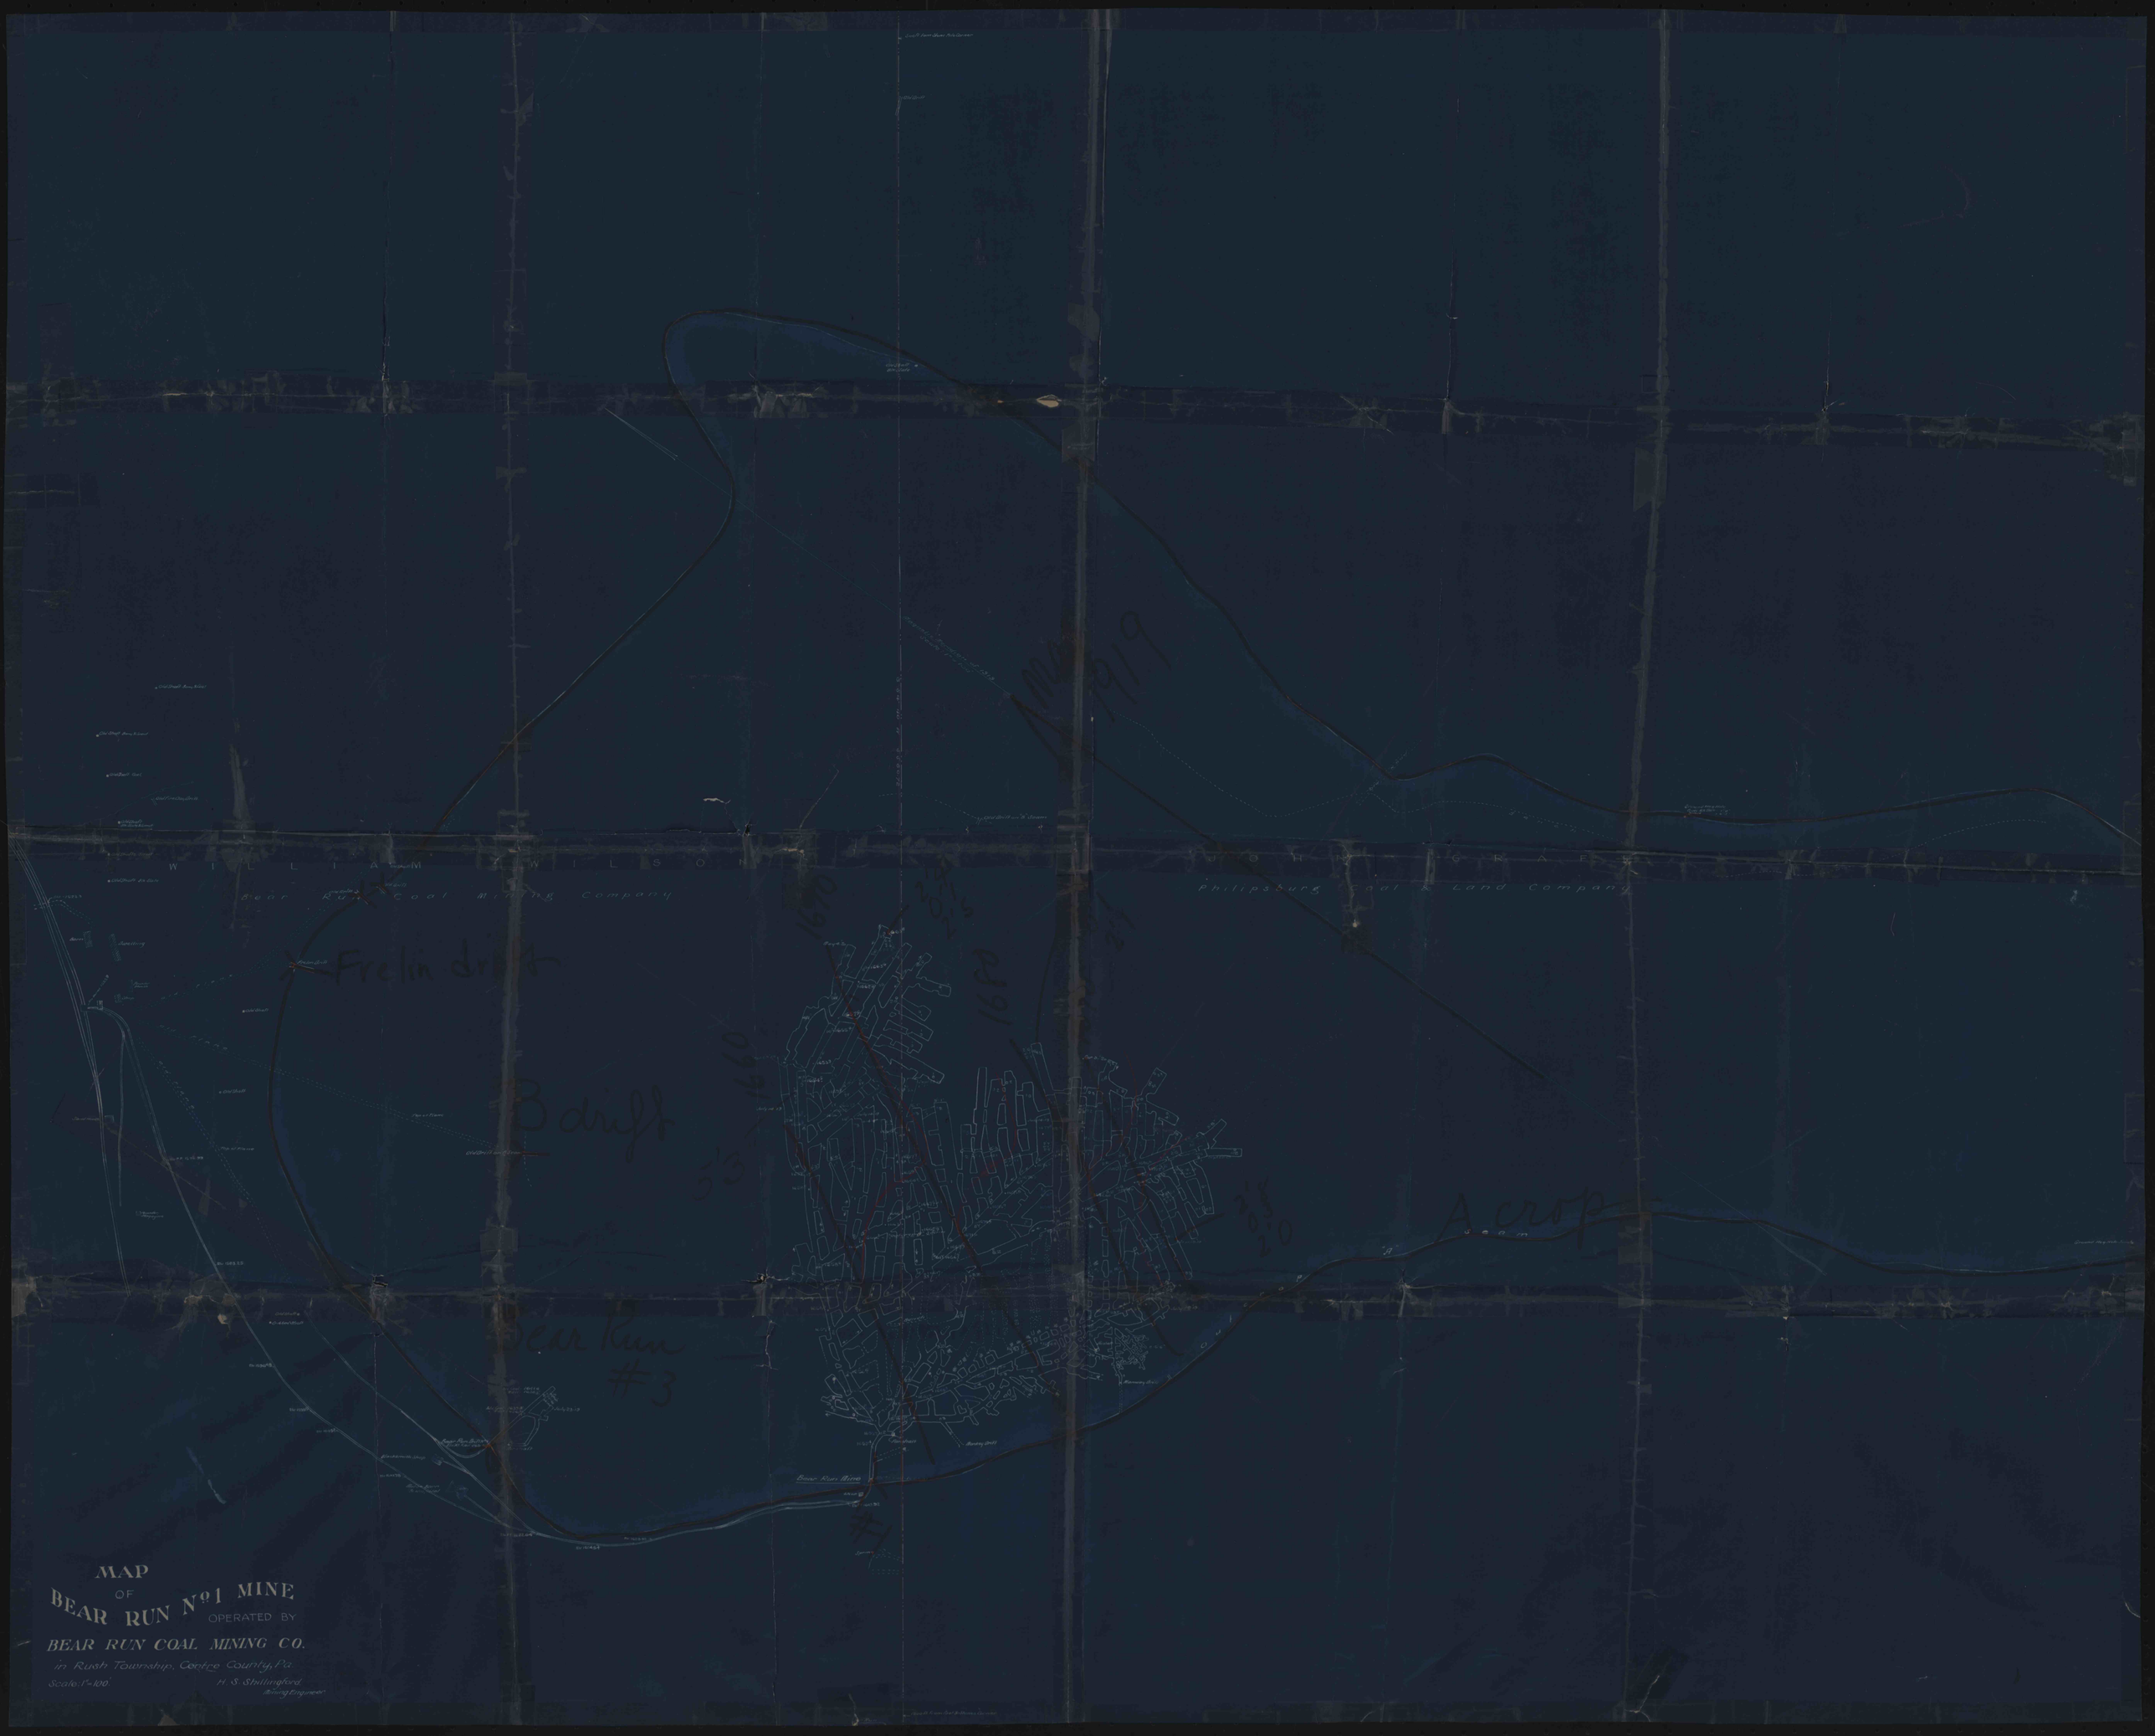
Bear Run Coal Mining Company
Philipsburg Coal & Land Company
Frelin drift
B drift
Bear Run #3
A crop
Bear Run Mine
MAP
OF
BEAR RUN No 1 MINE
OPERATED BY
BEAR RUN COAL MINING CO.
in Rush Township, Centre County, Pa.
Scale: 1"=100'
H. S. Shillingford
Mining Engineer