


I Hereby certify that
this blue print is a true and
correct copy of the original
map of New mine,
and that the original map is
a true complete and correct
map and survey of all the
excavations made in said mine

Oliver Lee Affman
Mining Engineer

James Murdock
Tract No 723

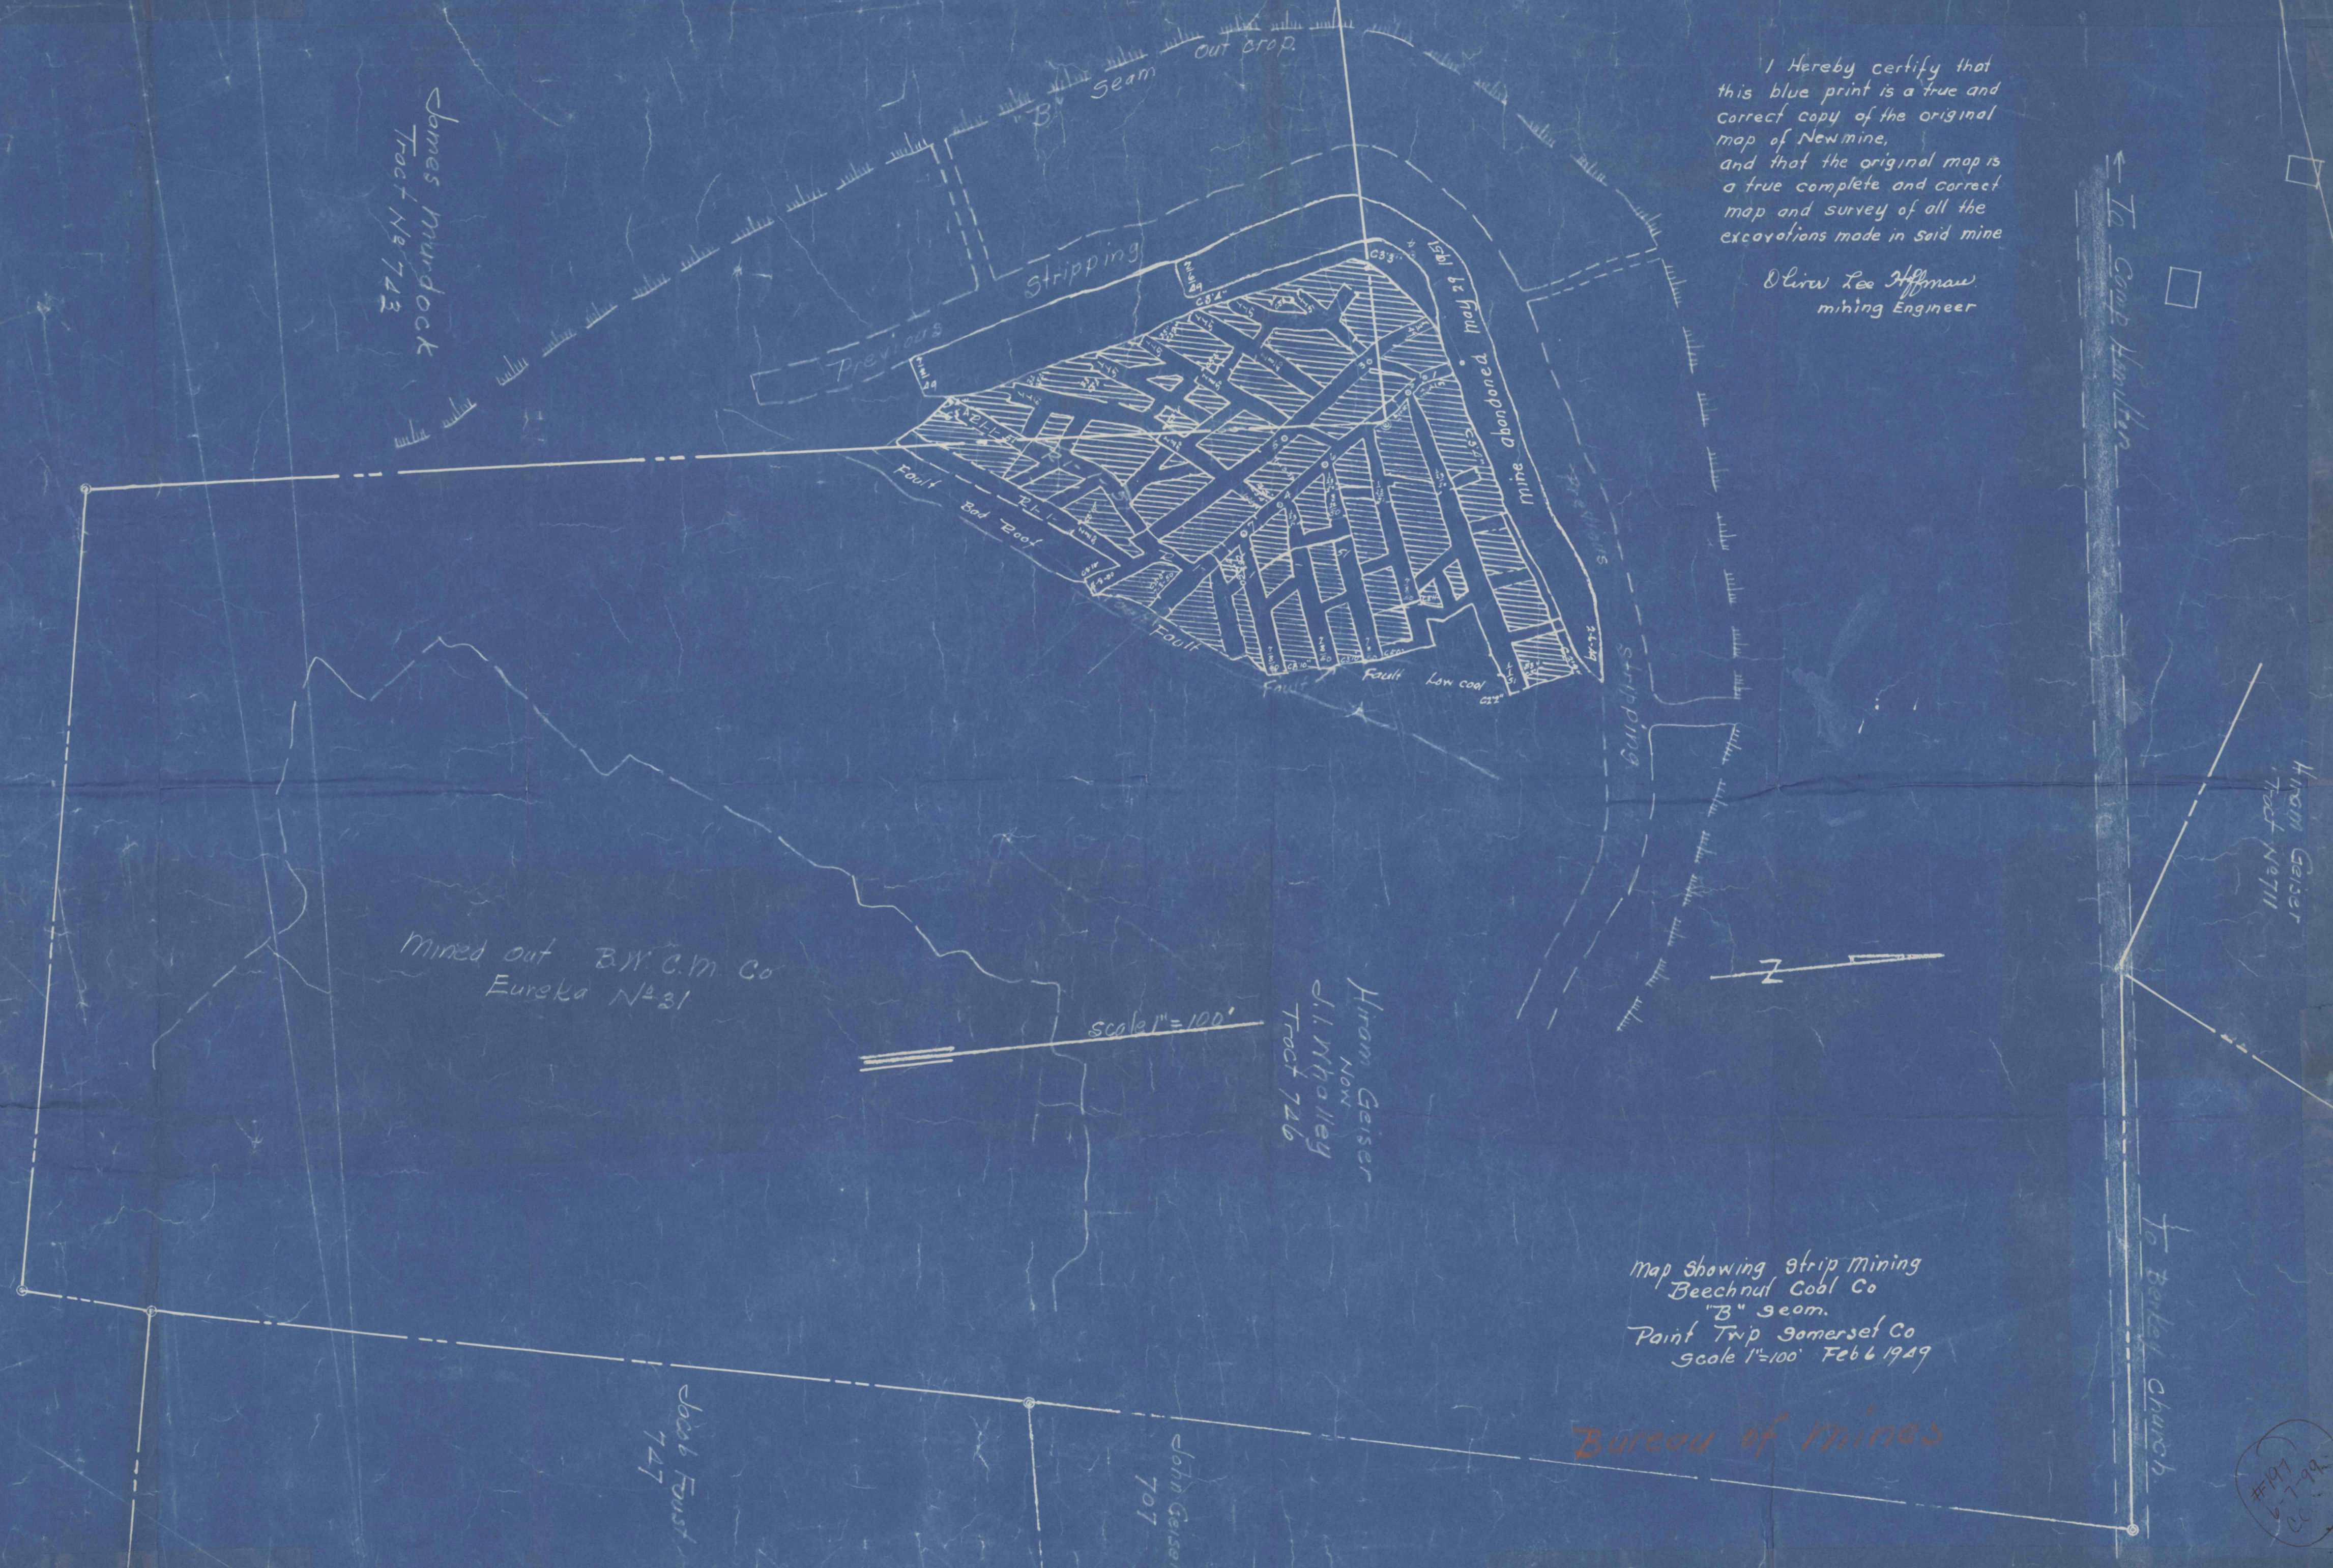

Mined out B.W.C.M. Co
Eureka No 21

Scale 1" = 100'

Hiram Geiser
New
D.I. Mholley
Tract 726

Map showing strip mining
Beechnut Coal Co
"B" seam.
Paint Twp Somerset Co
Scale 1"=100' Feb 6 1949

Bureau of Mines

#191
L.H.
7-1-49