
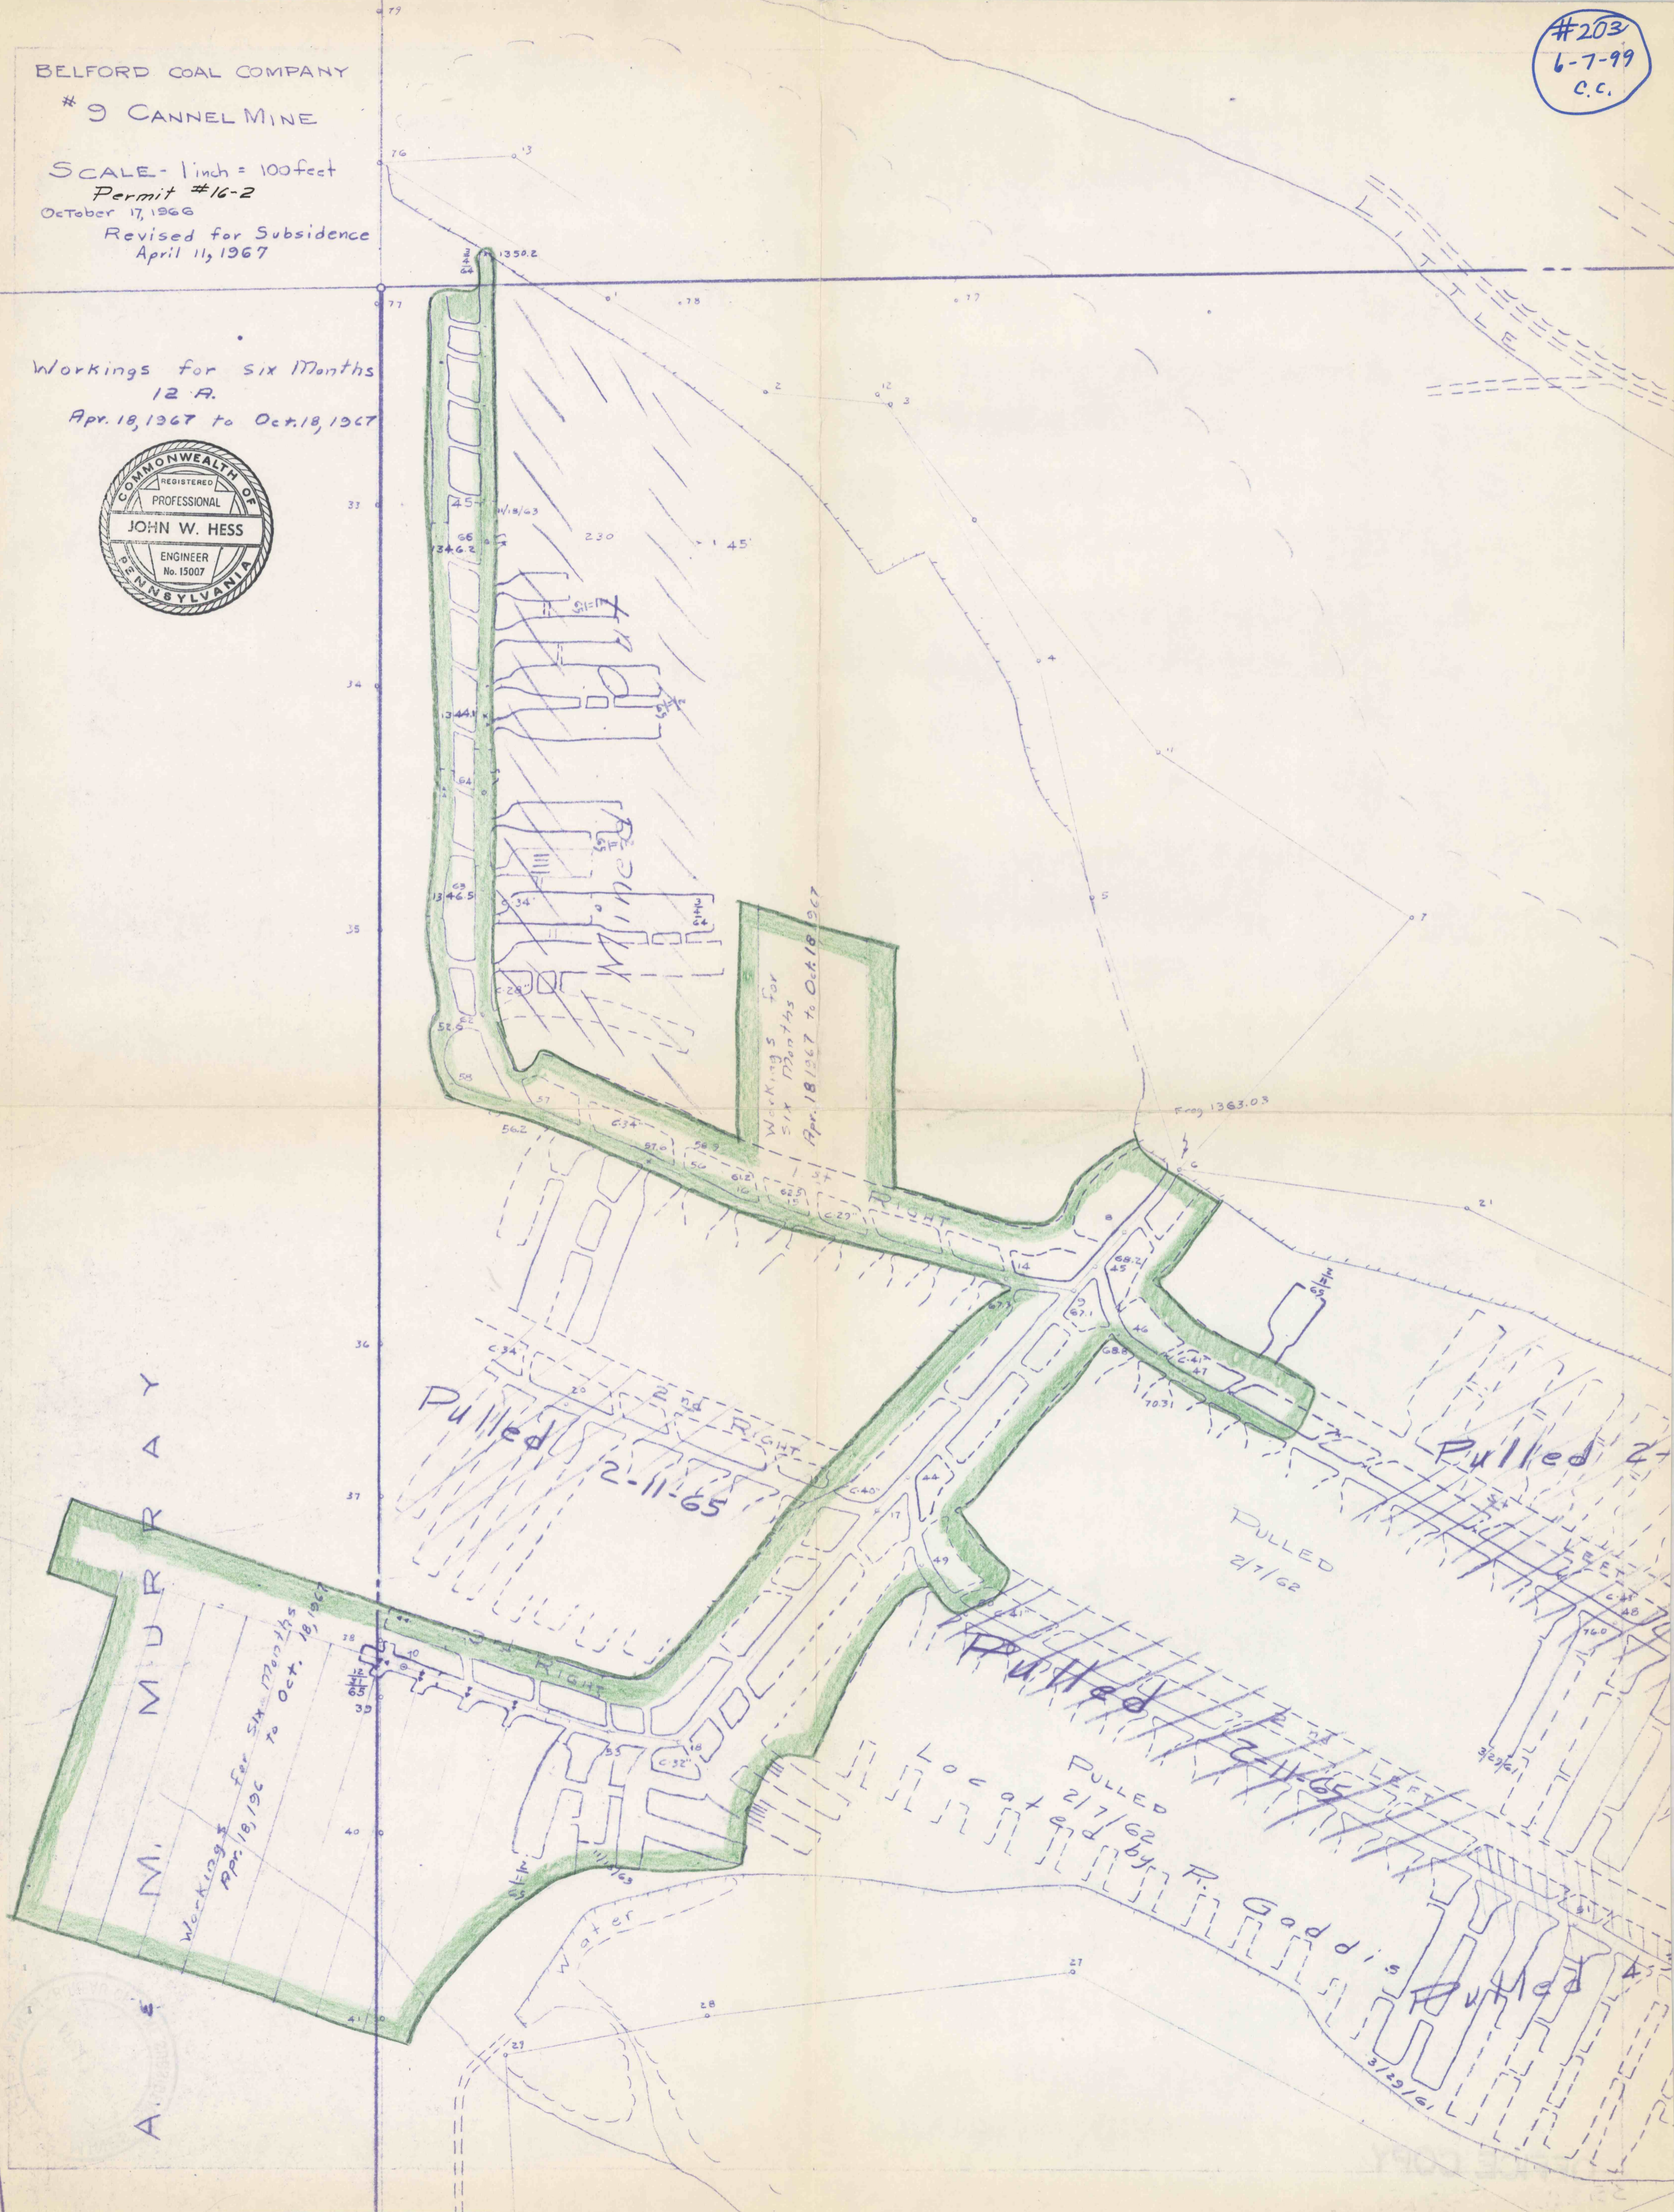


#203
6-7-99
C.C.

BELFORD COAL COMPANY
9 CANNEL MINE

SCALE - 1 inch = 100 feet
Permit #16-2
October 17, 1966
Revised for Subsidence
April 11, 1967

Workings for six Months
12 A.
Apr. 18, 1967 to Oct. 18, 1967

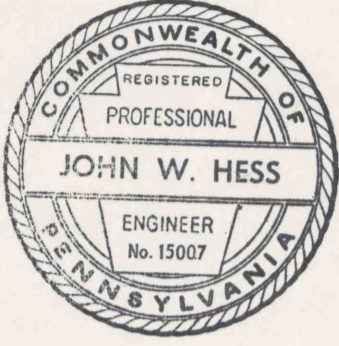

MURRAY

Workings for six Months
Apr. 18, 1967 to Oct. 18, 1967

Workings for six Months
Apr. 18, 1967 to Oct. 18, 1967

Pulled 2-11-65

Pulled 2-11-65

PULLED 2/7/62

Pulled 2-11-65

PULLED 2/7/62

Located by R. Godd's 3/29/61

