

SMITH
&
ZINDEL

SHAWVILLE COAL CO.

UNPAVED
STREAM

#12 Mine

B SEAM

Elev. 1313

JOHNSON & JOHNSON COAL CO.

2000 ft. to
Nearest Extant
North Mine elev. 1320

Belford #3
Extant Seam
Washed out
Elev. 1303

MOORE & ROUGEUX

Peck Creek

A. A. Murray Est.

KRISTIANSON
Future
Possible
Mining

Highway

Highway


Highway

Highway

PERMIT No.
16-3

LEGEND

- Contemplated Mining 37 Acres
March 13, 1967 to September 13, 1968
- Mining Completed

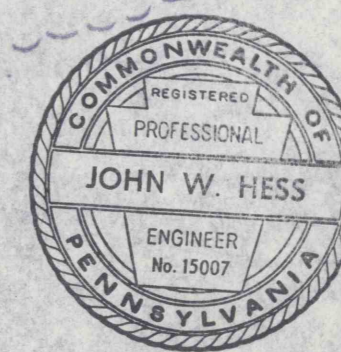

BELFORD COAL COMPANY

#12 Mine

GIRARD TWP CLEARFIELD CO., PA

SCALE - 1 inch = 100 Feet

September 13, 1967 John W. Hess
Clearfield, Pa. Engineer

#206
6-8-69
C.C.