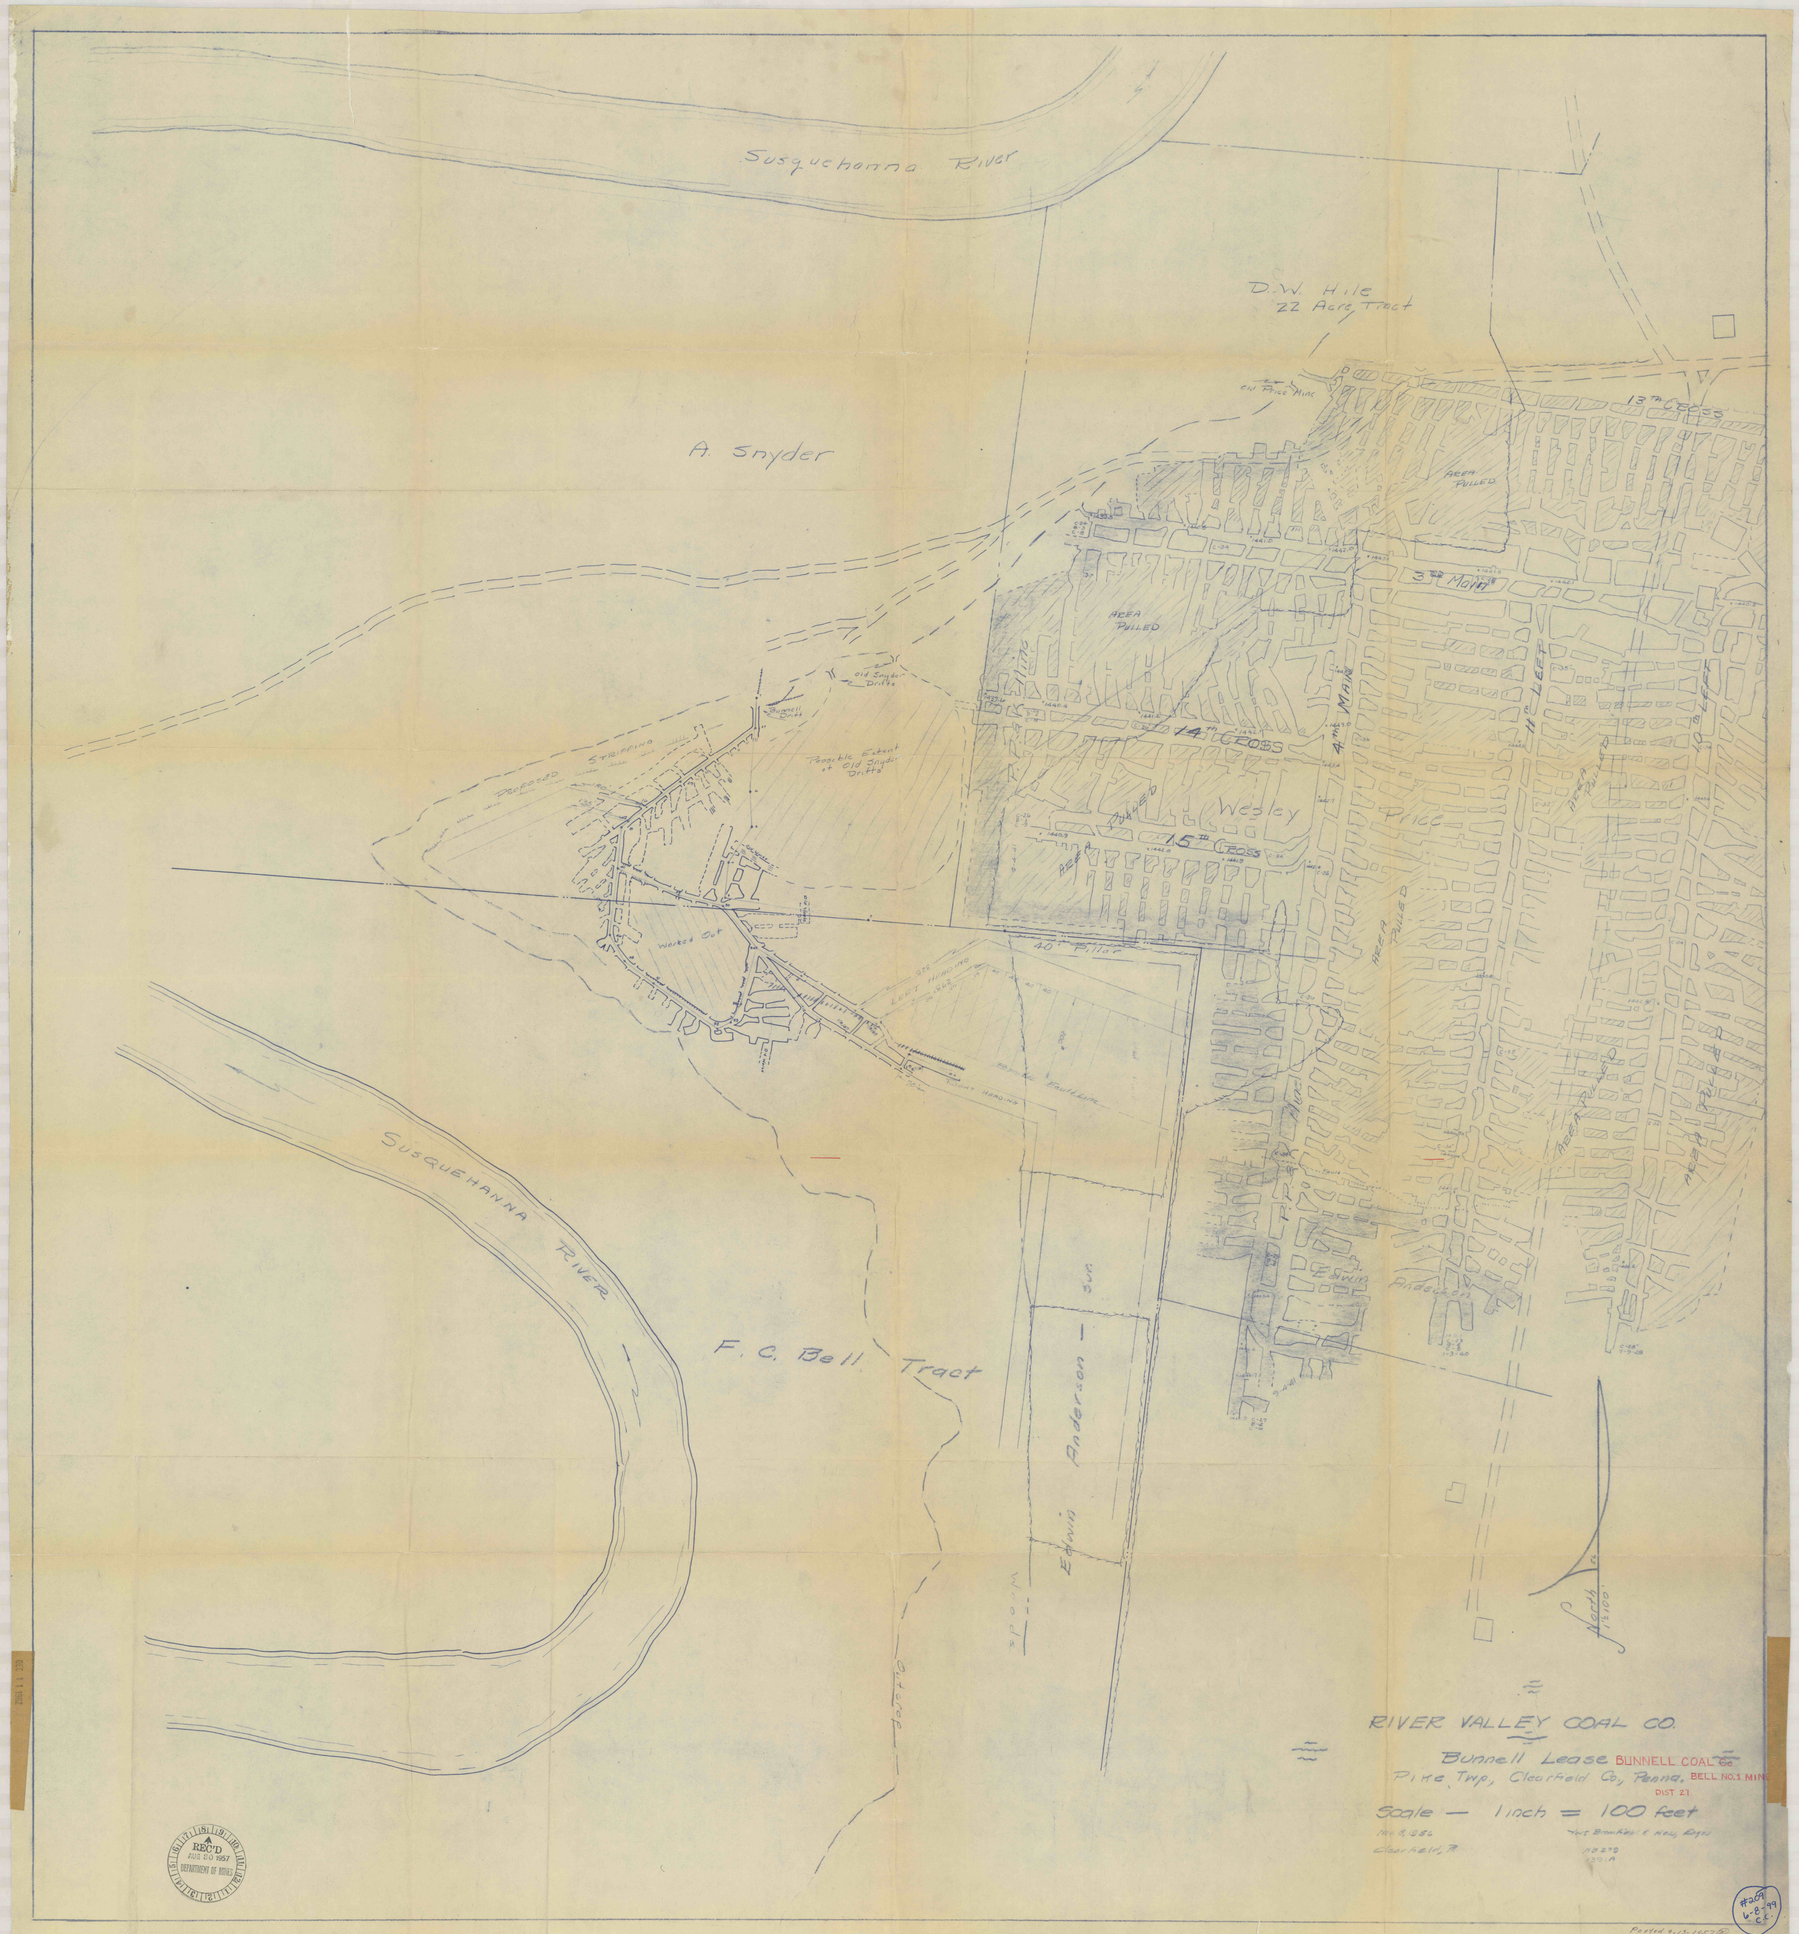
Susquehanna River
D.W. Hile
22 Acre Tract
A. Snyder
13th Cross
Area Pulled
3rd Main
Area Pulled
14th Cross
Wesley
Price
15th Cross
Area Pulled
Area Pulled
Area Pulled
Area Pulled
Old Snyder Drifts
Possible Extent of Old Snyder Drifts
Proposed Stripping
Worked Out
40' Pillar
Susquehanna River
F. C. Bell Tract
Edwin Anderson — Sun
Woods
Outcrop
North
1"=100'
RIVER VALLEY COAL CO.
Bunnell Lease
Pike Twp, Clearfield Co, Penna.
BUNNELL COAL Co
BELL NO.1 MINE
DIST 27
Scale — 1 inch = 100 feet
Nov 8, 1956
Clearfield, Pa
Yost Bromfield & Hess, Engrs
NB 270
1301A
REC'D
AUG 30 1957
DEPARTMENT OF MINES
#209
6-8-99
C.C.
Posted 9-13-1957