

(Bell Mine)



Map of Rugh Mine

Bell Coal Co.

Bell Township, Westmoreland County  
Pennsylvania.

Scale 1"=100'

May 17-1943.

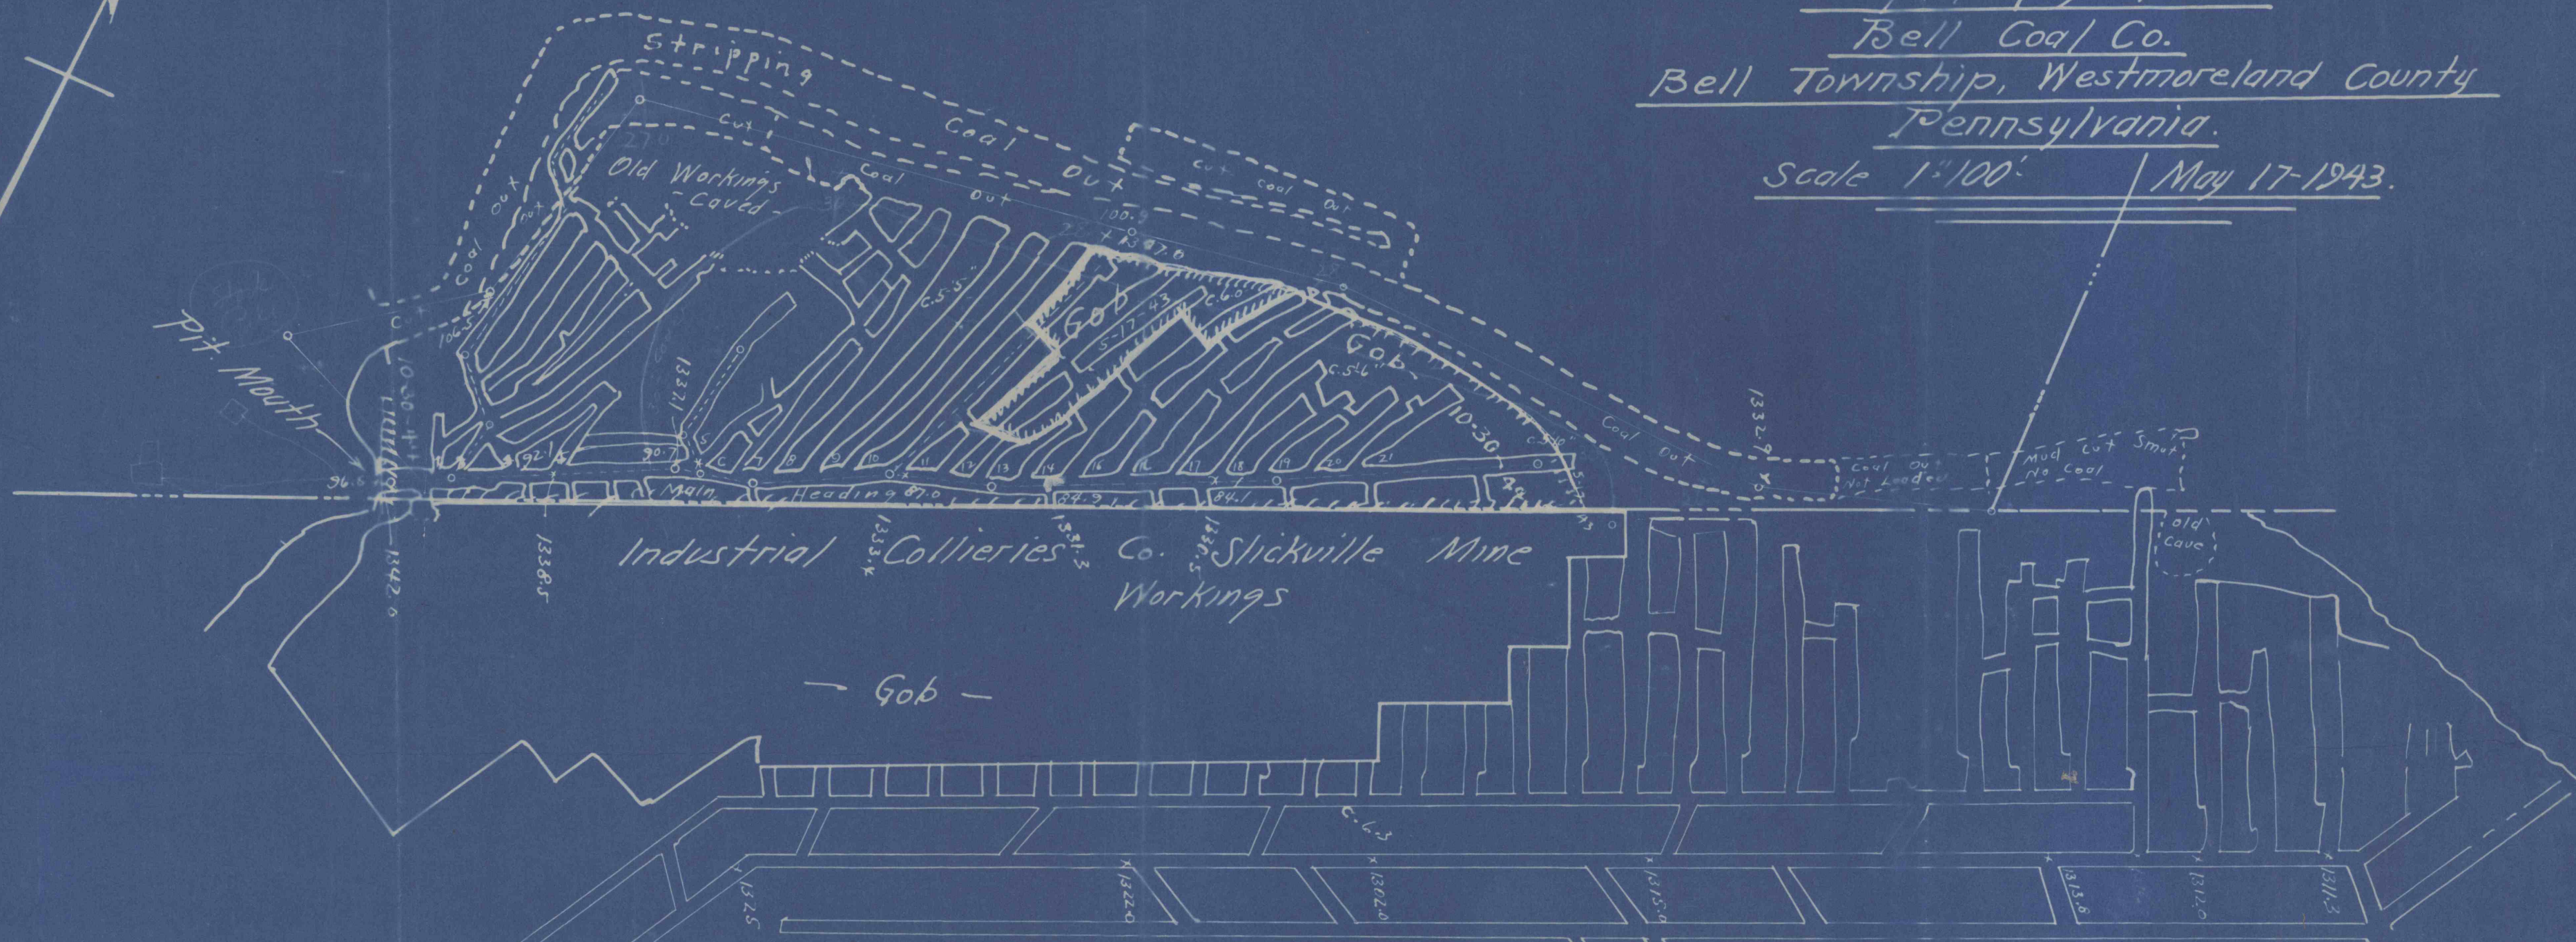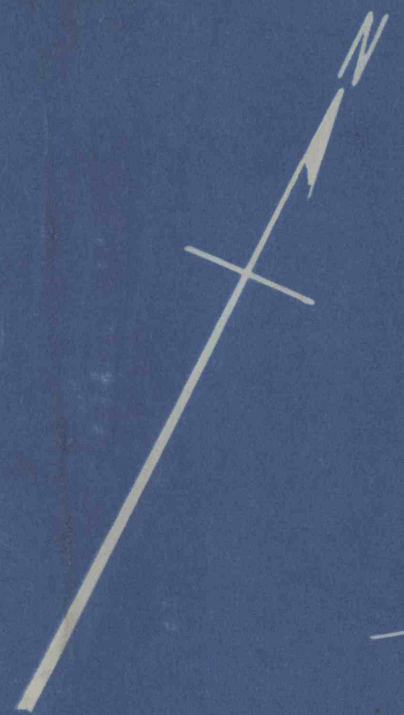

I, the undersigned, hereby certify that this map is correct and shows all the information, to the best of my knowledge and belief required by the mining Laws of this State and covers the period ending Sept. 30th 1944. when all mining was completed.

Robert A. Ramsay Registered Engineer # 3601

Acknowledged before me this 26th day of March 1945

Thos. H. Keim

THOS. H. KEIM, N. P.  
My Commission Expires  
January 5, 1947

Robert A. Ramsay Engineer  
Greensburg Pennsylvania.

#210  
6-8-49  
CC

BK389P25