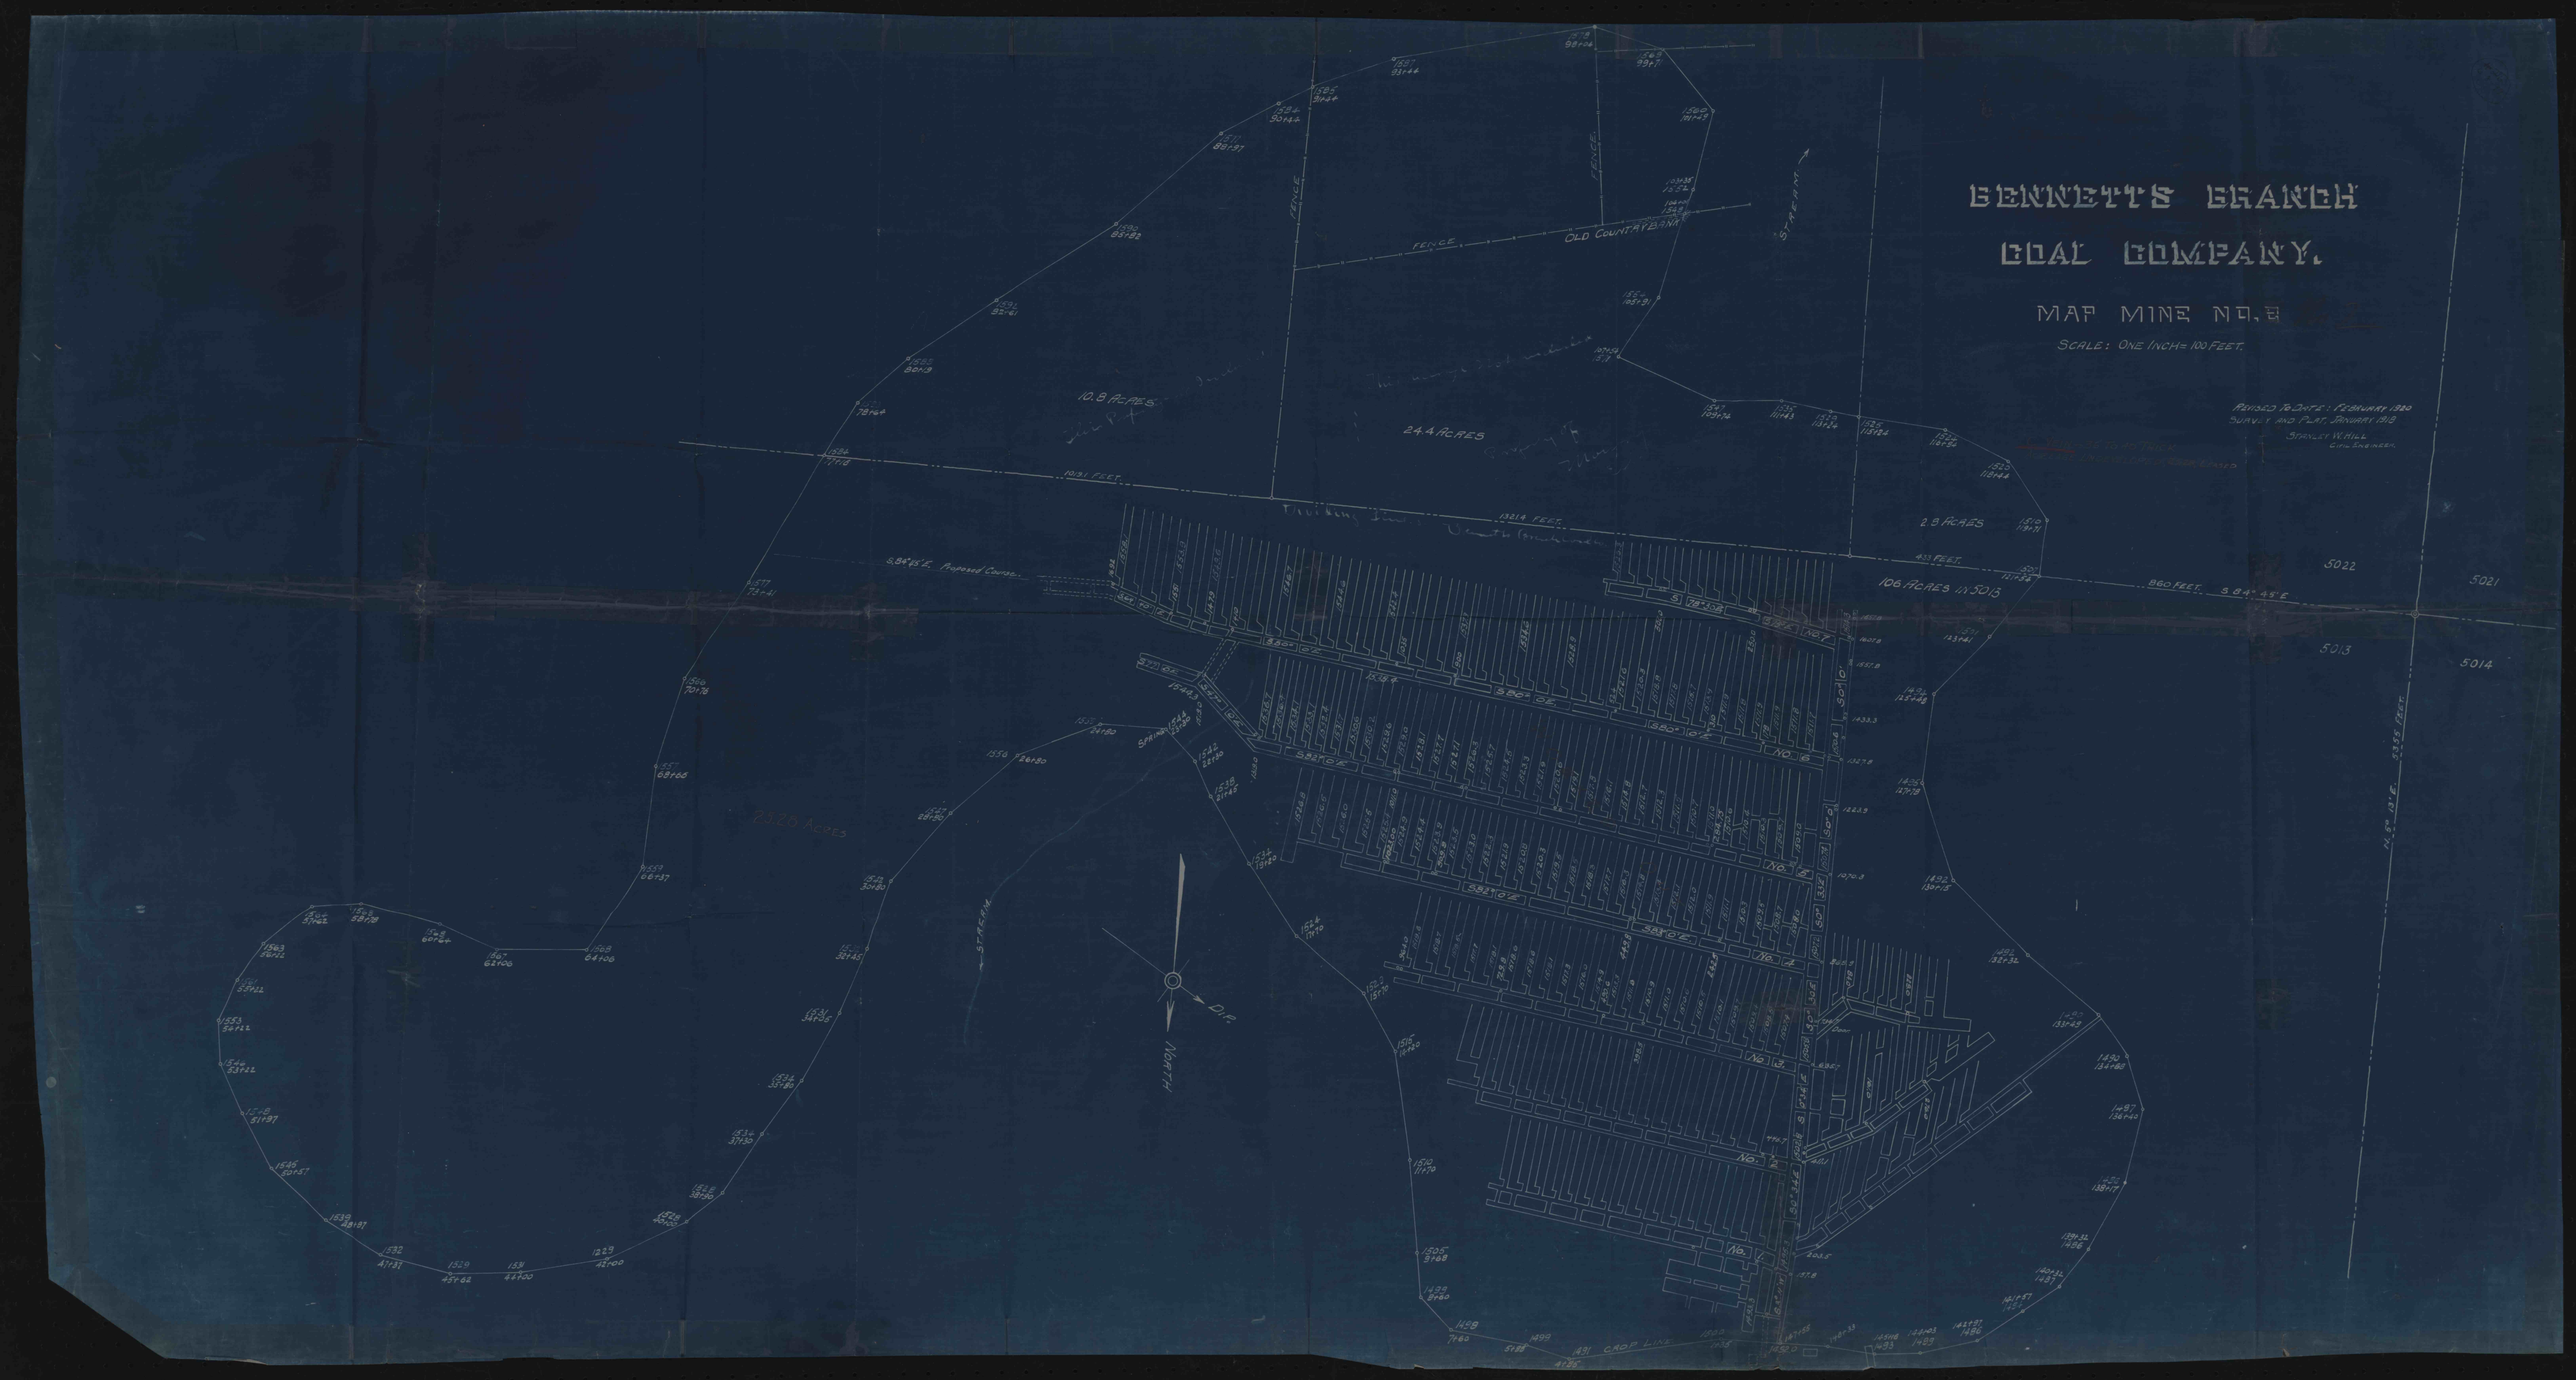
BENNETTS BRANCH
COAL COMPANY.
MAP MINE NO. 3
SCALE: ONE INCH = 100 FEET.
REVISED TO DATE: FEBRUARY 1920
SURVEY AND PLAT JANUARY 1918
STANLEY W. HILL
CIVIL ENGINEER
10.8 ACRES
24.4 ACRES
2.8 ACRES
106 ACRES in 5013
23.20 ACRES
FENCE
OLD COUNTY ROAD
STREAM
10191 FEET.
13214 FEET.
433 FEET.
860 FEET. S 84° 45' E
S. 84° W. Proposed Course.
N. 6° 15' E. 5955 FEET.
No. 1
No. 2
No. 3
No. 4
No. 5
No. 6
No. 7
5022
5021
5013
5014
NORTH
D.P.
CROP LINE