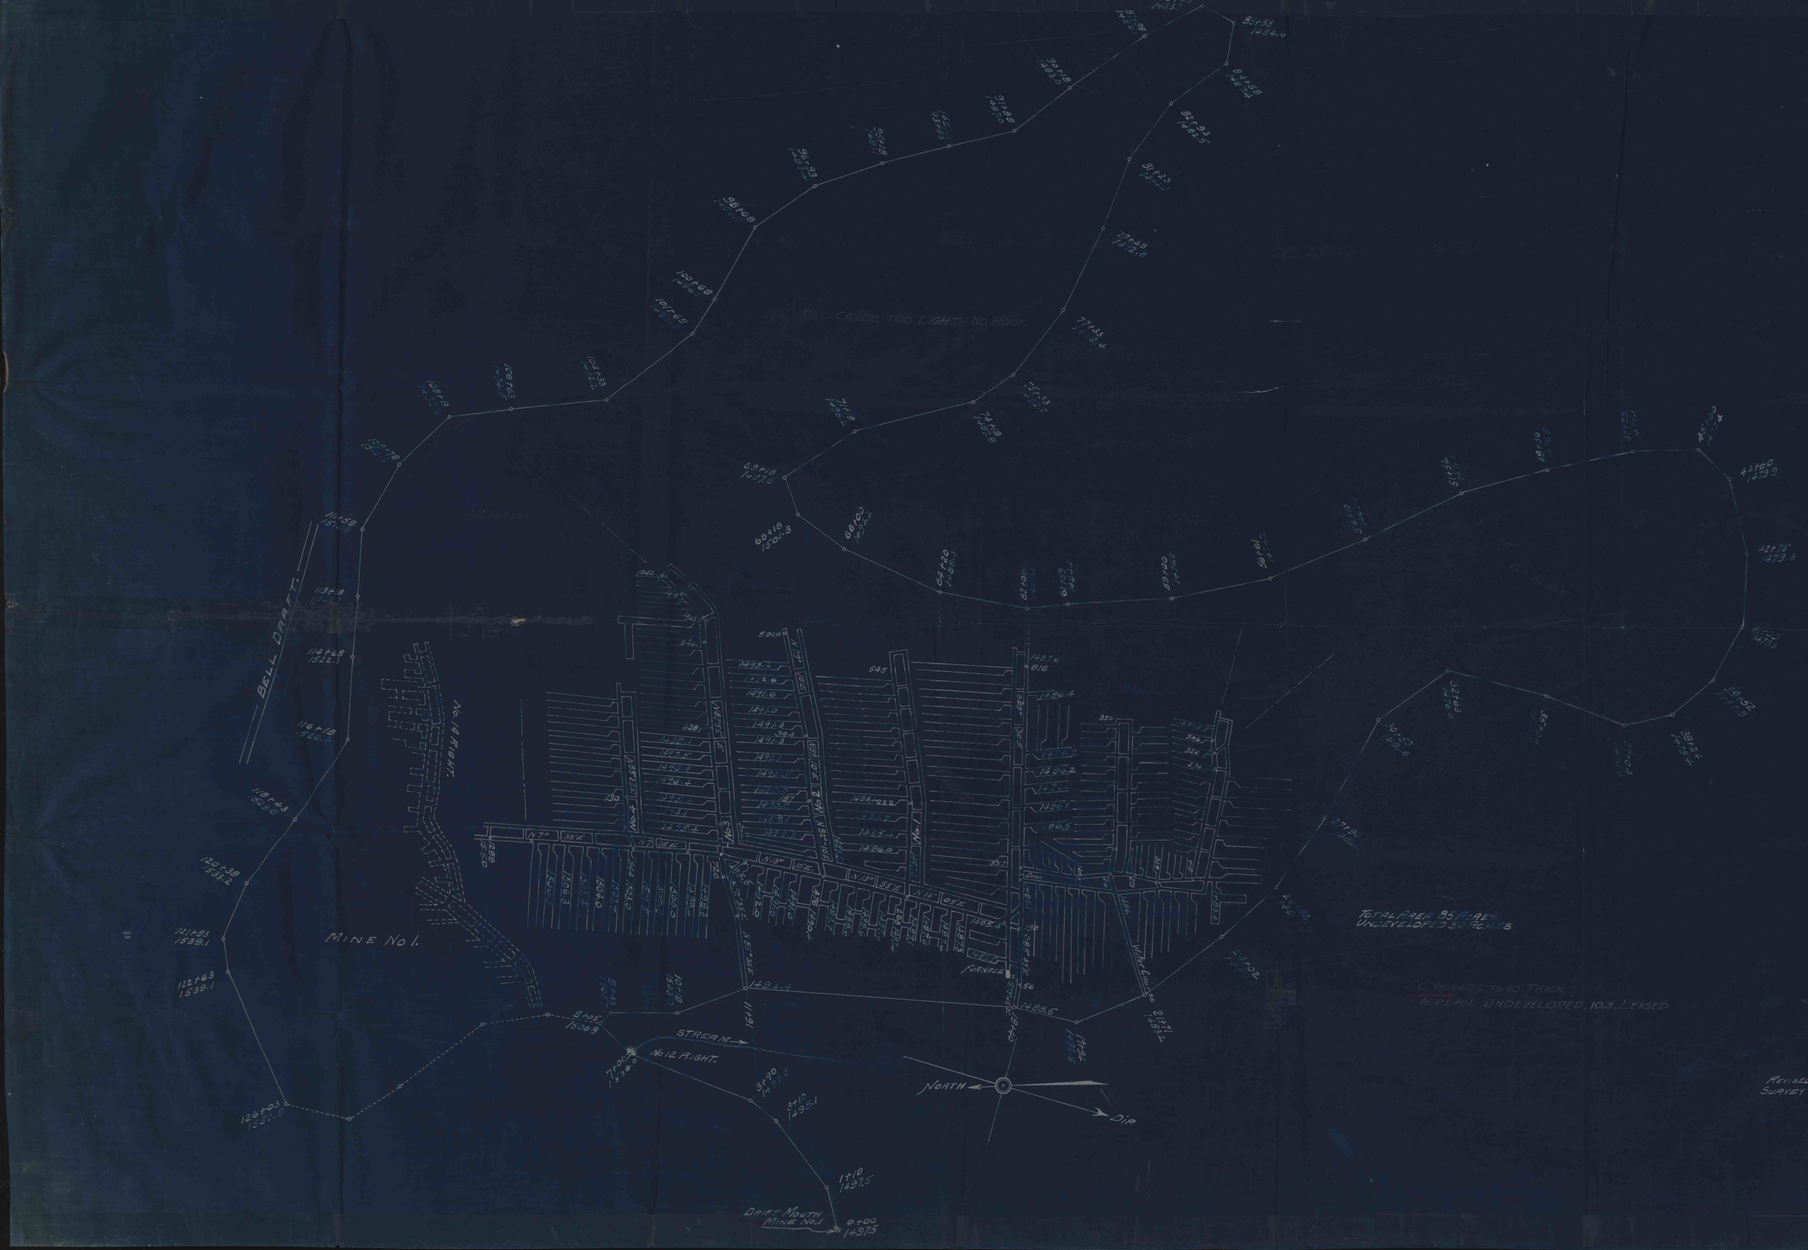


# BENNETTS BRANCH COAL COMPANY.

## MAP MINE No. 3

SCALE:- 1 INCH = 100 FT.

REVISED TO DATE: FEBRUARY 5-1920
SURVEY AND PLAT FEBRUARY 1918
STANLEY W. HILL
CIVIL ENGINEER