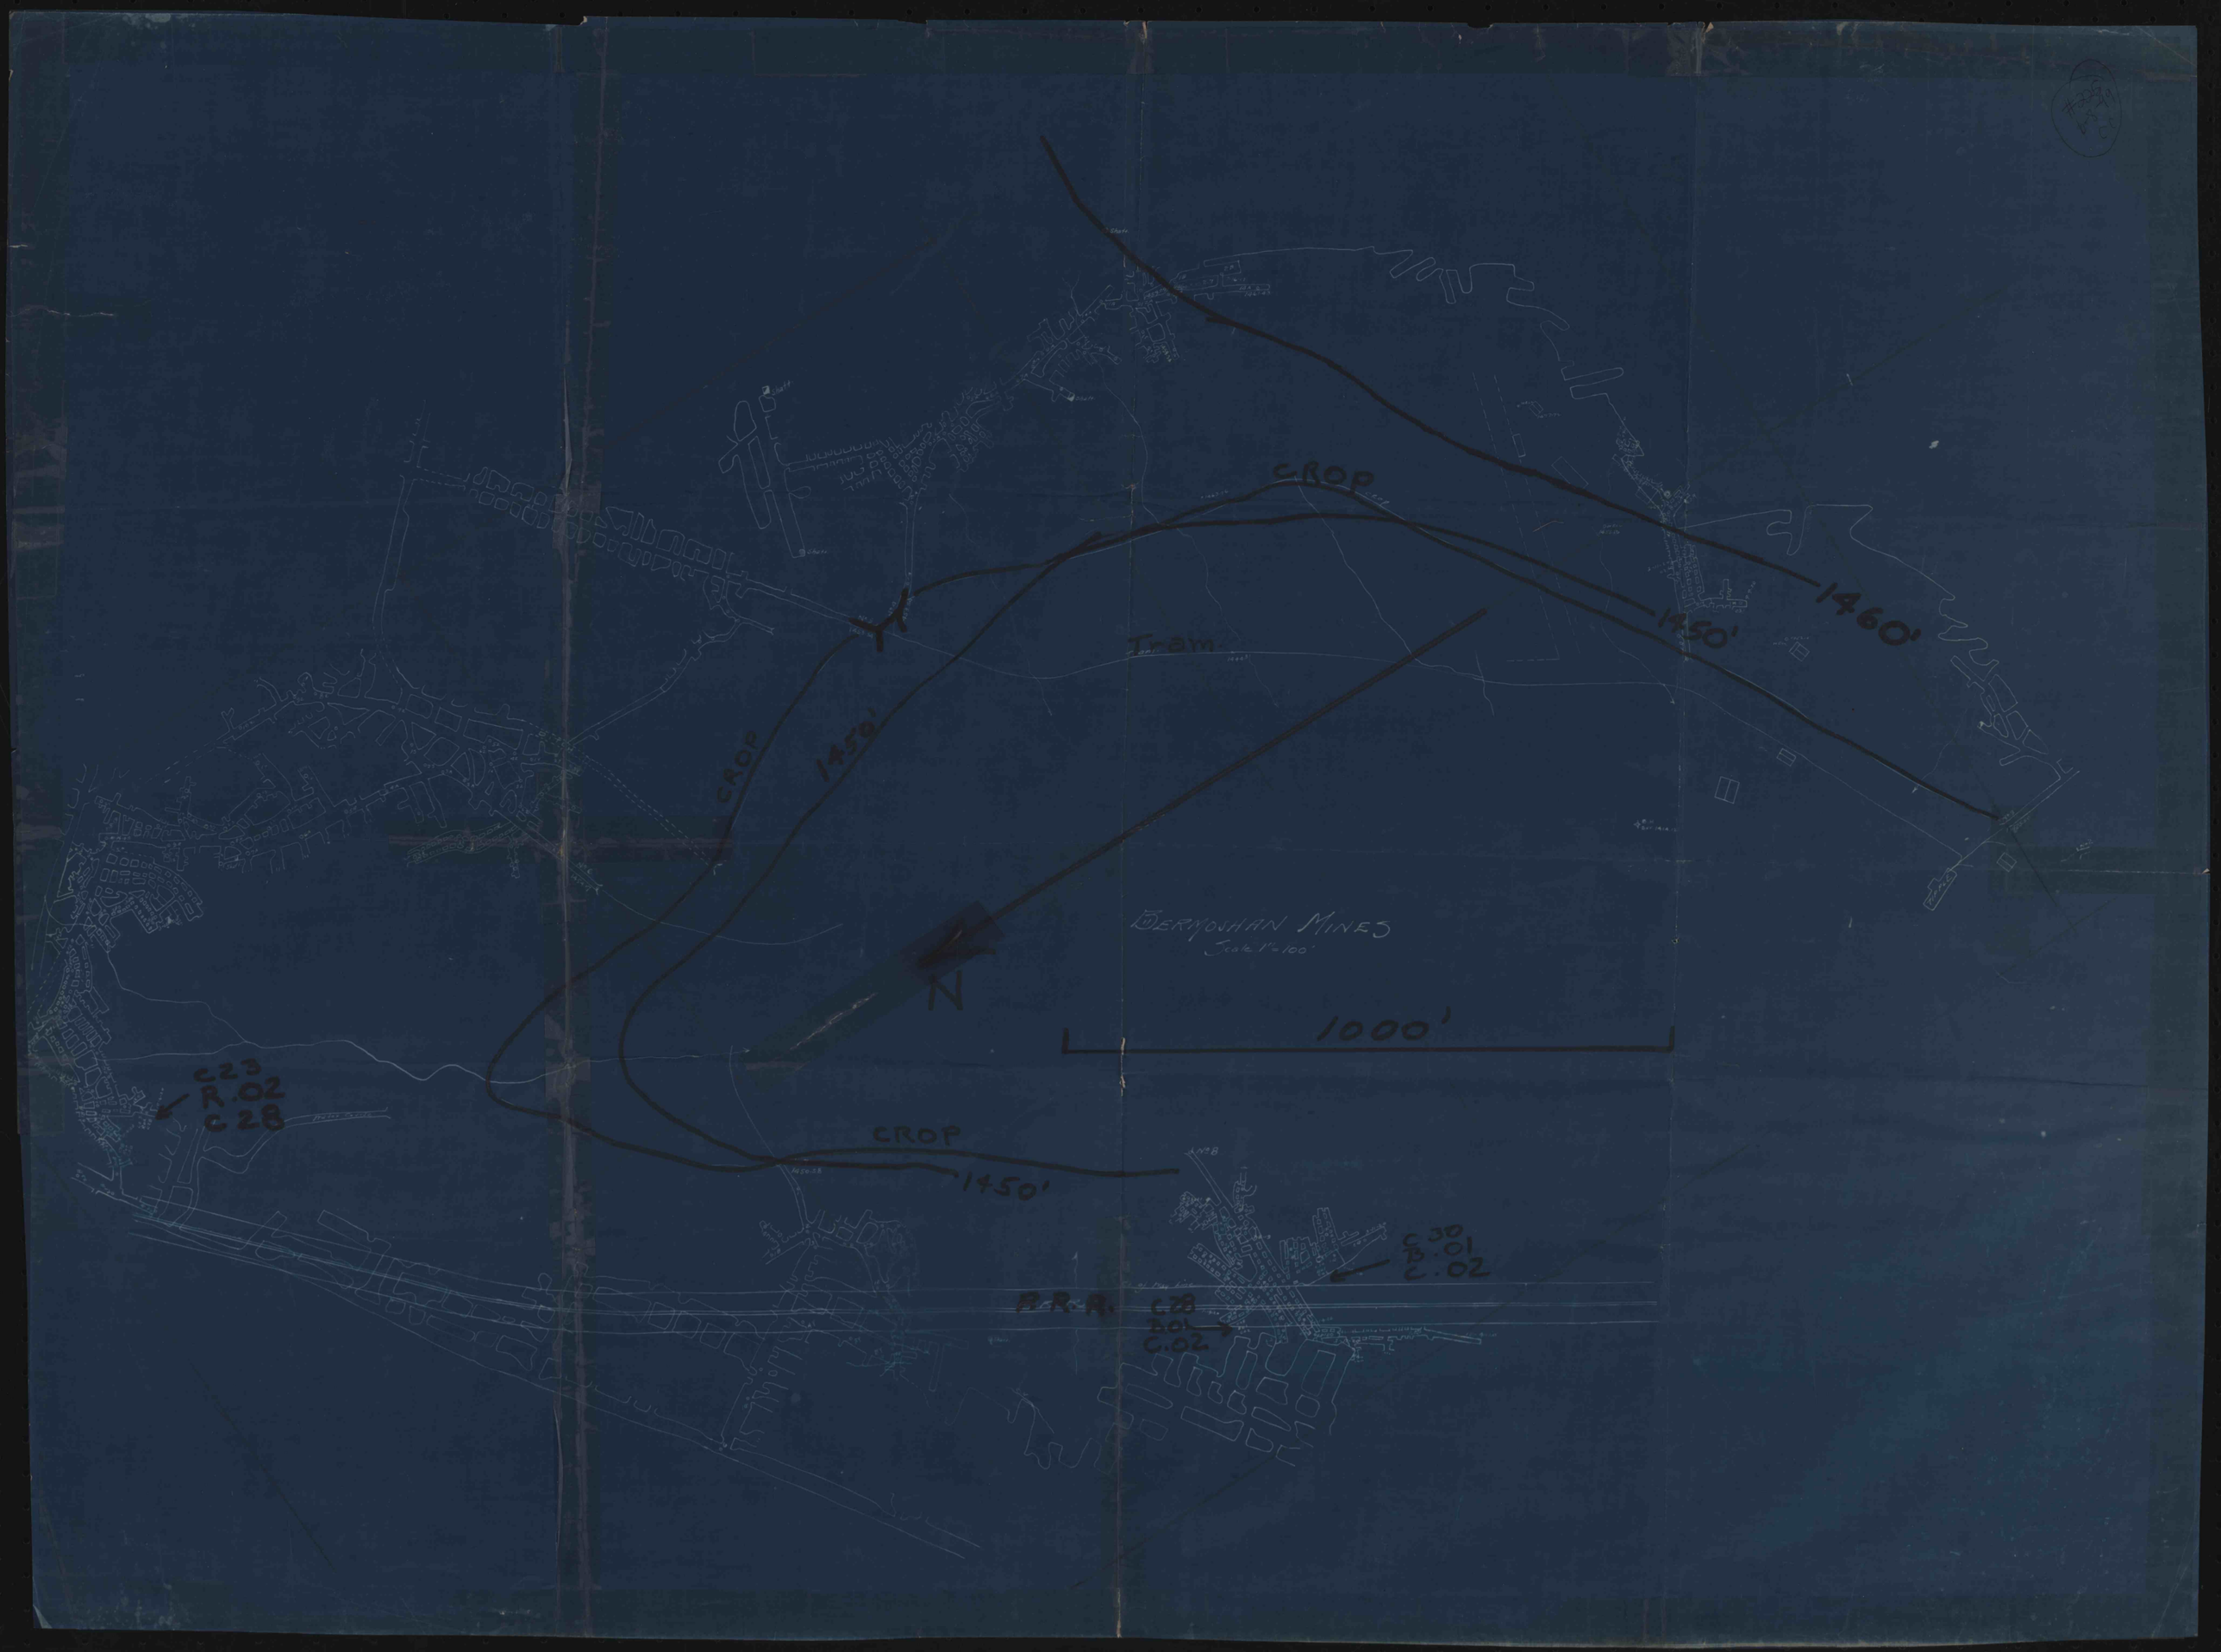
CROP
1460'
1450'
Tram
CROP
1450'
N
BERYOSHAN MINES
Scale 1"=100'
1000'
C23
R.02
C28
CROP
1450'
C30
B.01
C.02
B.R.R.
C28
B01
C.02