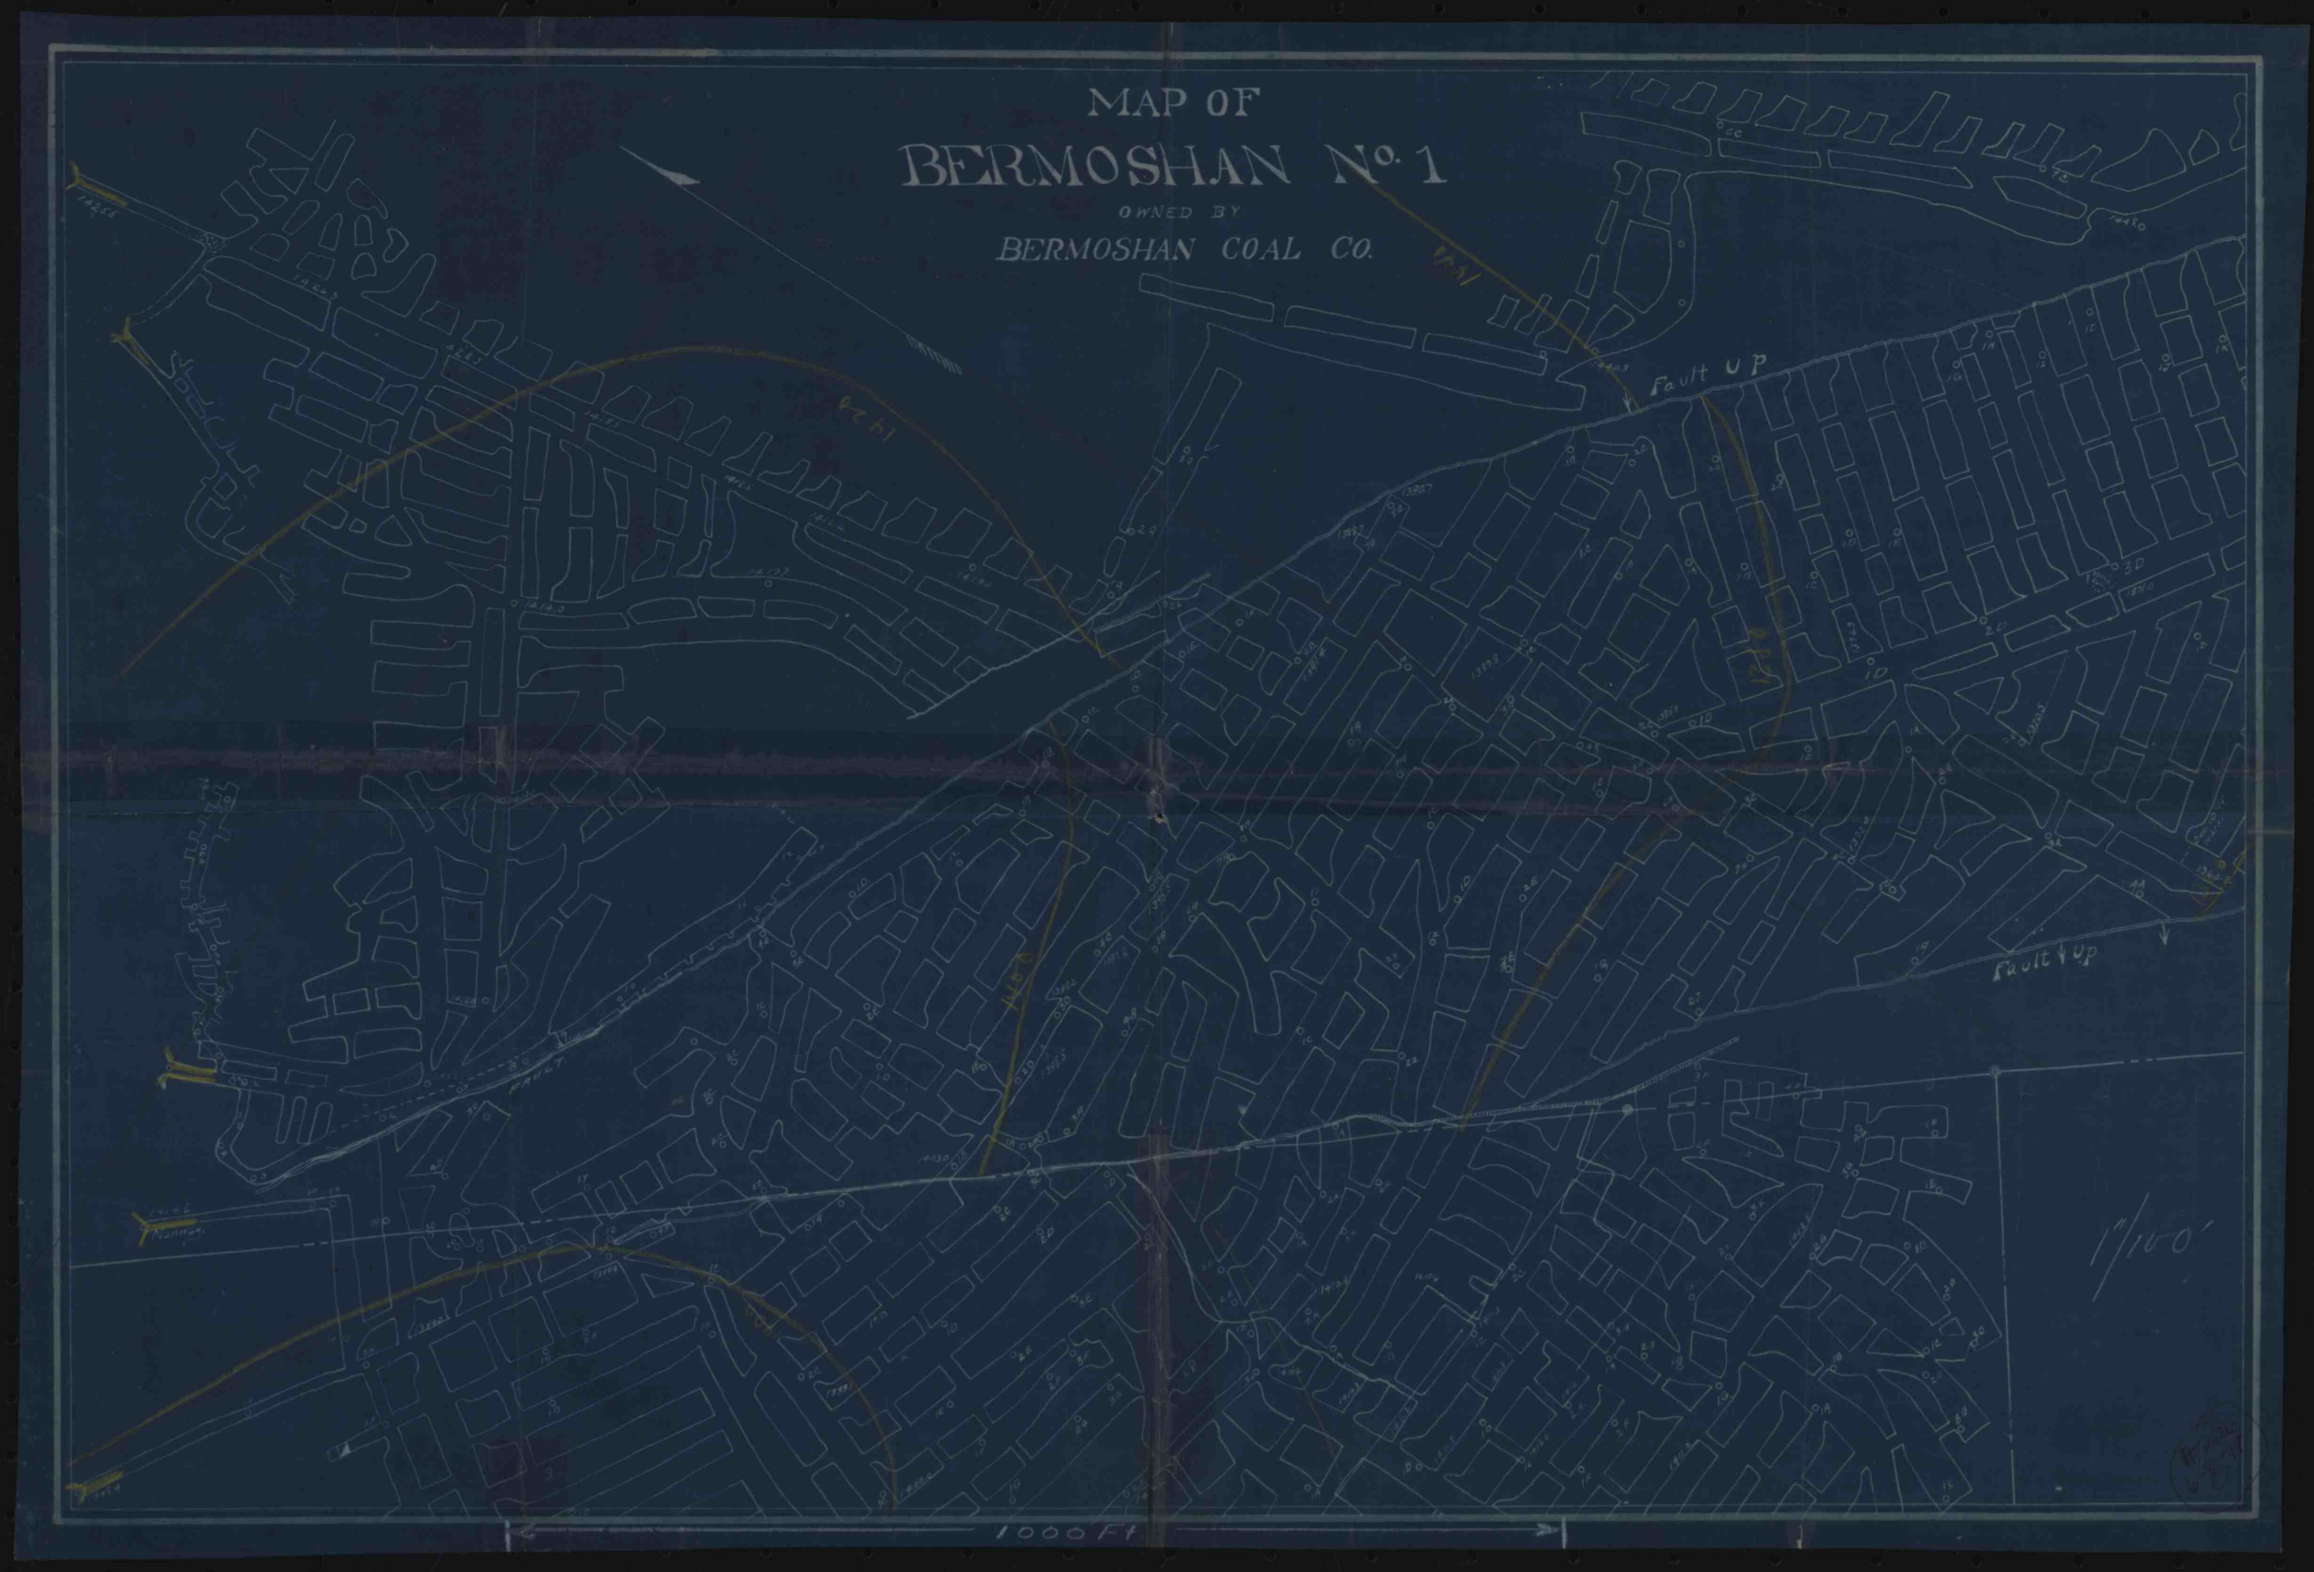
MAP OF
BERMOSHAN No. 1
OWNED BY
BERMOSHAN COAL CO.
Fault Up
Fault Up
1000 Ft