


James Filiaggi  
 COMPLETION MAP  
 BERTHA MINE  
 Dunkard Twp - Greene Co. Penna.  
 Scale 1" = 100' 2-1-65  
 operator Bertha Leneskie  
 address Dilliner, Pa  
 By - William A. Thistlethwaite  
 Reg Surveyor # 7770 E

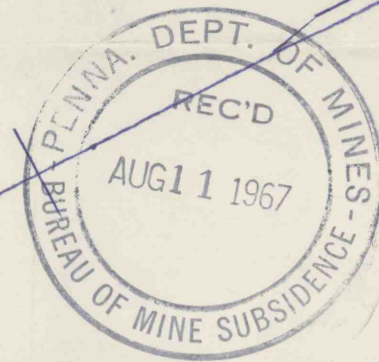

Legend

7-9-65	William A. Thistlethwaite
5-10-66	William A. Thistlethwaite
8-3-66	William A. Thistlethwaite
1-16-67	William A. Thistlethwaite
8-1-67	William A. Thistlethwaite

LEGEND	
PROP. LINE	
MINED AFTER APRIL 27, 1966	
PROPOSED MINING 6 MONTH PERIOD	NONE
PERIOD ENDING	COMPLETED
SURFACE STRUCTURES	NONE
AREA TO BE STUMPED	NONE
SCALE	1" = 100'

#231  
 1-9-99  
 C.C.